


10392 S IN SR13

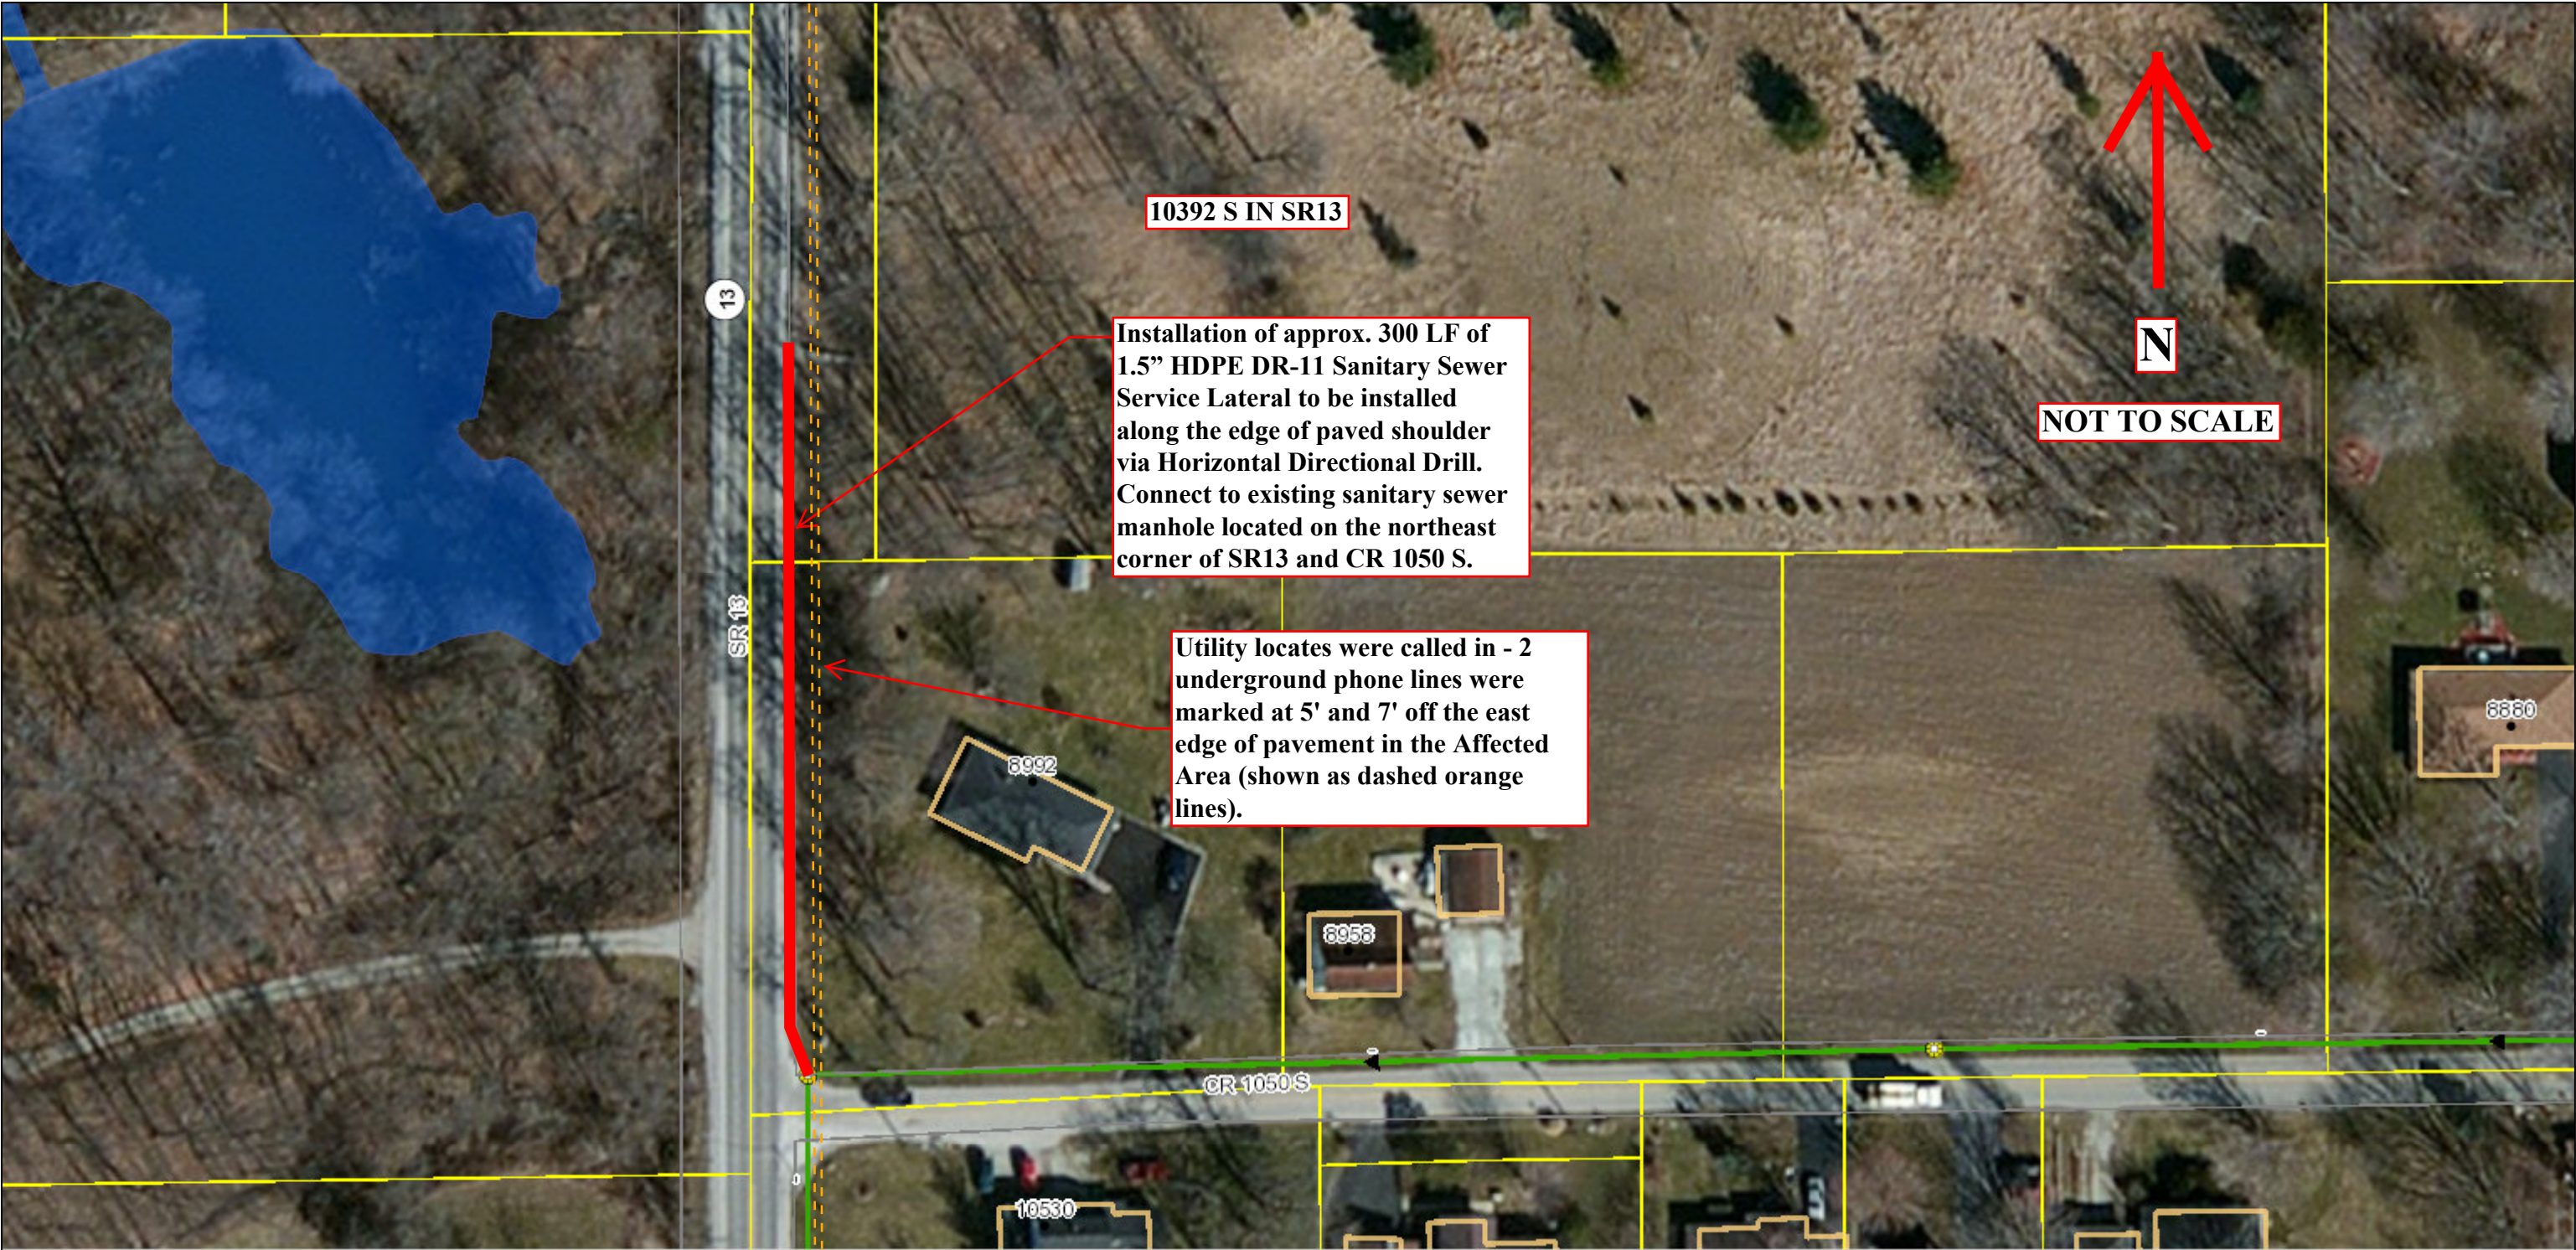

October 4, 2016

Lateral Top Connection

- Not Plugged
- Plugged
- Pendleton Addresses
- Road Edge
- Railroads

Street Centerlines

- State Highways
- Interstate Labels
- Interstate 69

Manhole

- Manhole

Proposed Manhole

Network Structure

- Lift Station

Lateral Line

- Not Plugged
- Plugged

Sanitary Main

- Abandoned Main
- Sanitary Main
- Proposed Sanitary Main

Curb Inlet

- Catch Basin
- Storm Manhole

Storm Main

- Storm Pipe
- Buildings
- Parcels
- Hydrology

Sewer Rehabilitation

- Main and Lateral Rehab

Lateral Rehabs Only

- Main and Lateral (R/W only) Rehabs
- MapGrid

Lateral Connections

- Lateral Connections
- Lateral Connections with Permits

Source: Esri, DigitalGlobe, GeoEye, Earthstar Geographics, CNES/Airbus DS, USDA, USGS, AEX, Getmapping, Aerogrid, IGN, IGP, swisstopo, and the GIS User Community