

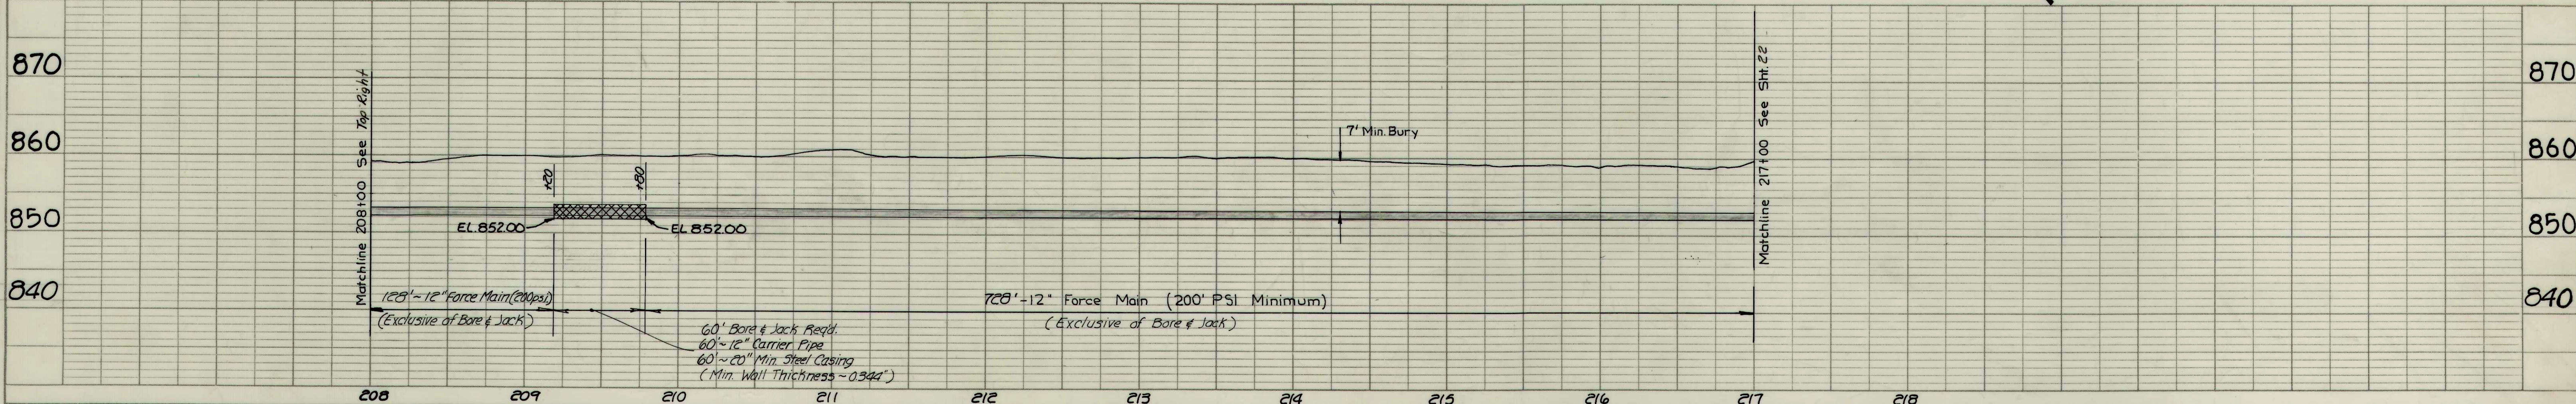
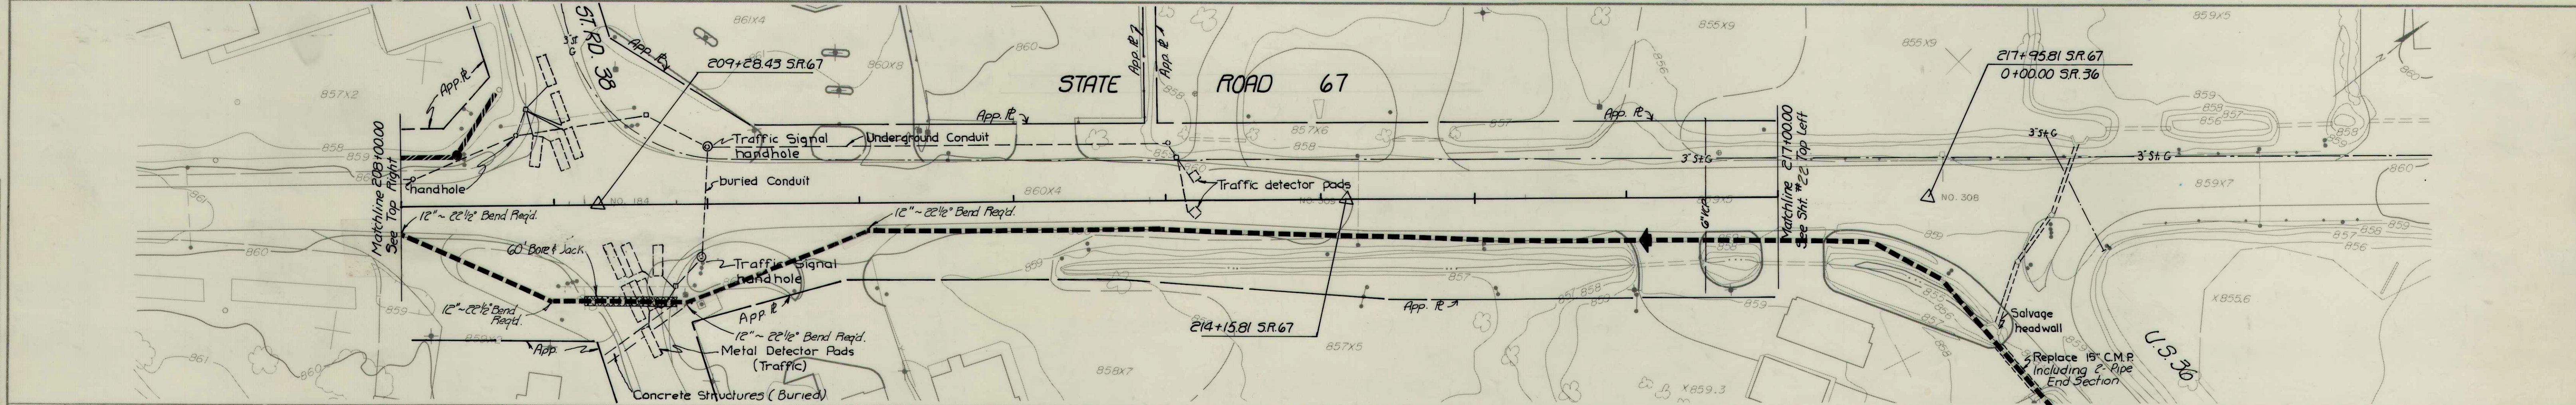


PLAN	SURVEYED	DATE
	NOTED	BY
	NOTED	BY
	NOTED	BY

PROFILE	SURVEYED	DATE
	NOTED	BY
	NOTED	BY
	NOTED	BY

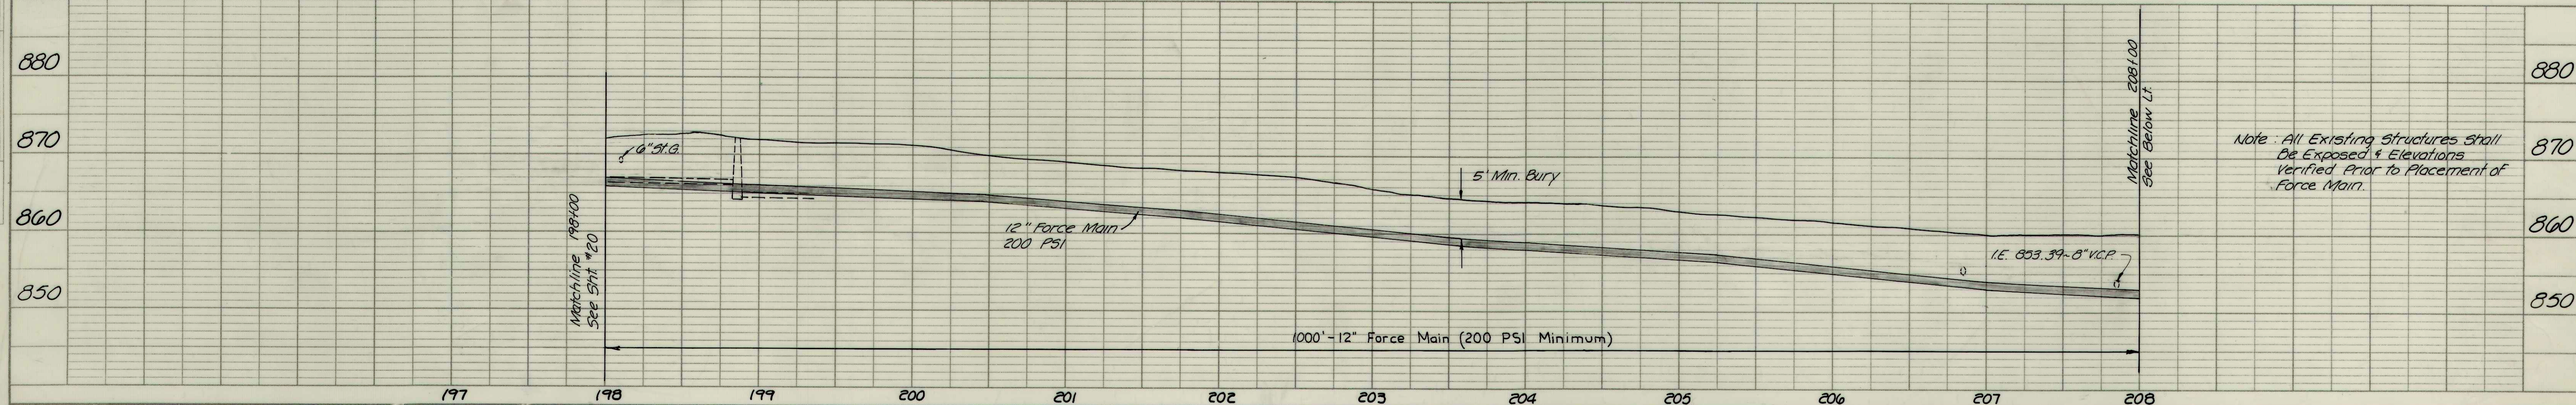

RECORD DRAWING

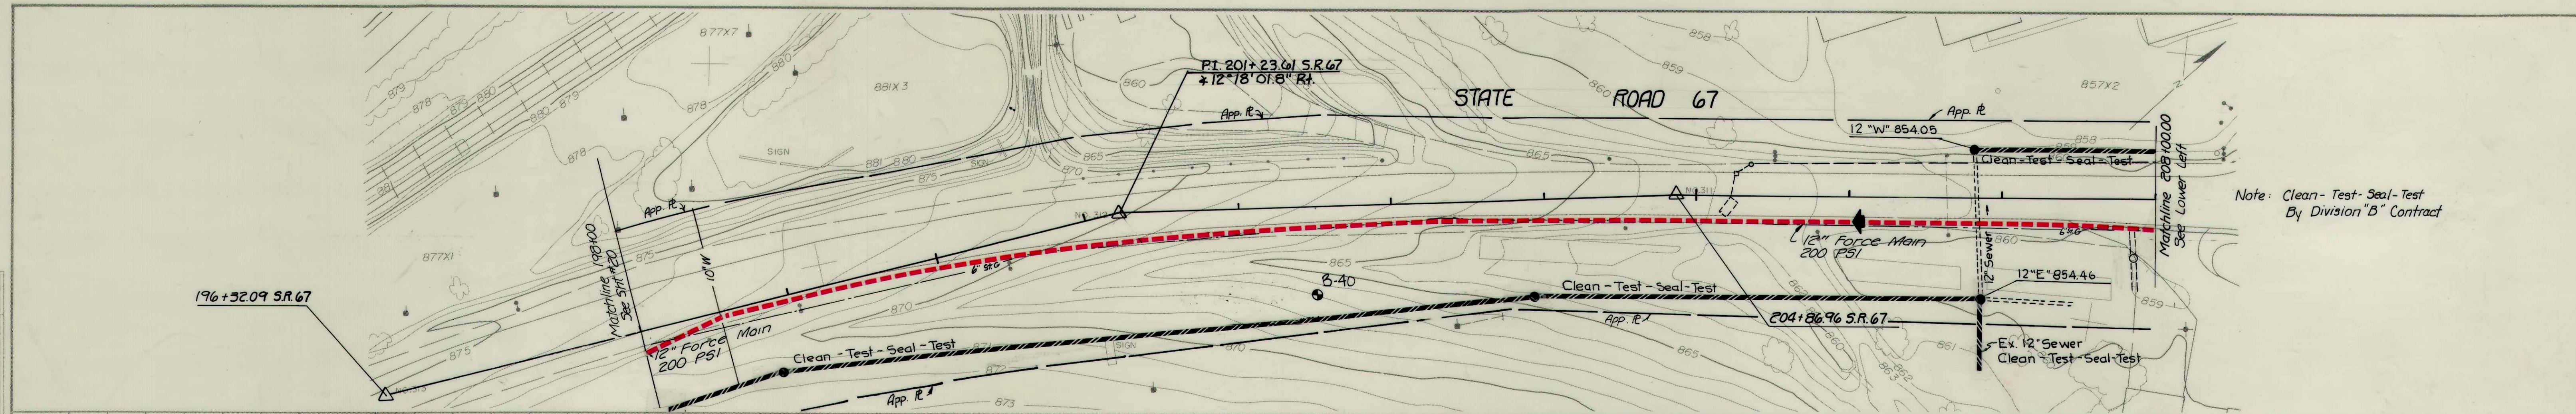

STATE ROAD 67	
FALL CREEK R.W.D. PLAN & PROFILE SHEET	
HORIZ. 1"=50'	BEAM, LONGEST & NEFF, INC.
VERT. 1"=10'	CONSULTING ENGINEERS
	INDIANAPOLIS, INDIANA