FEDERAL ROAD REGION NO.	STATE	PROJECT NO.	FISCAL YEAR	SHEET NO.	TOTAL SHEETS
5	IND.				

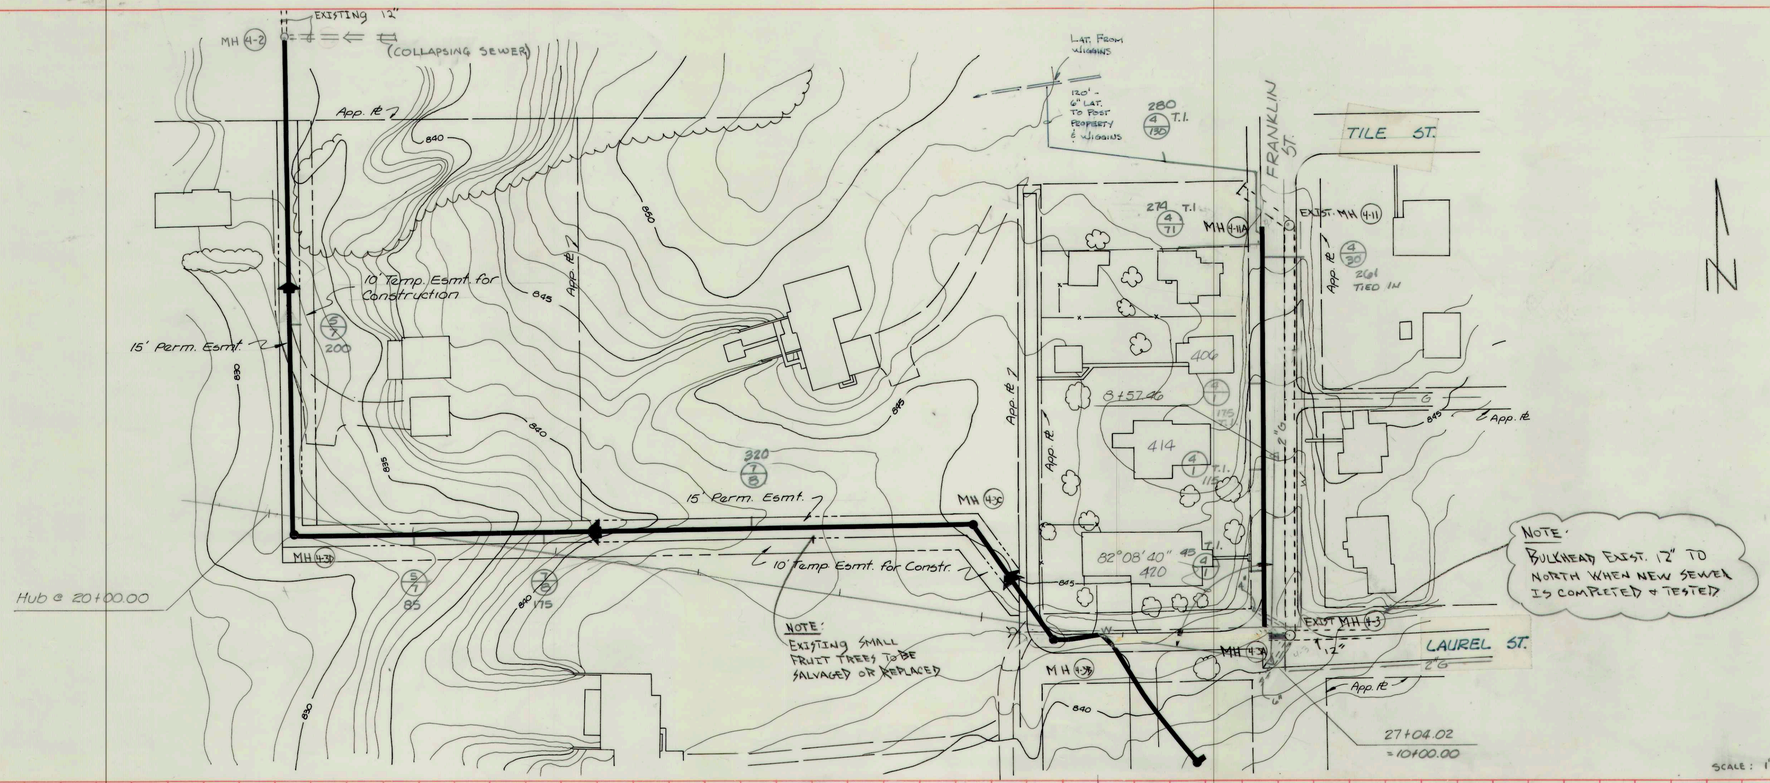

SEWER LINE "E" REVISION (PENDELTON) DIV. B 1/17/85

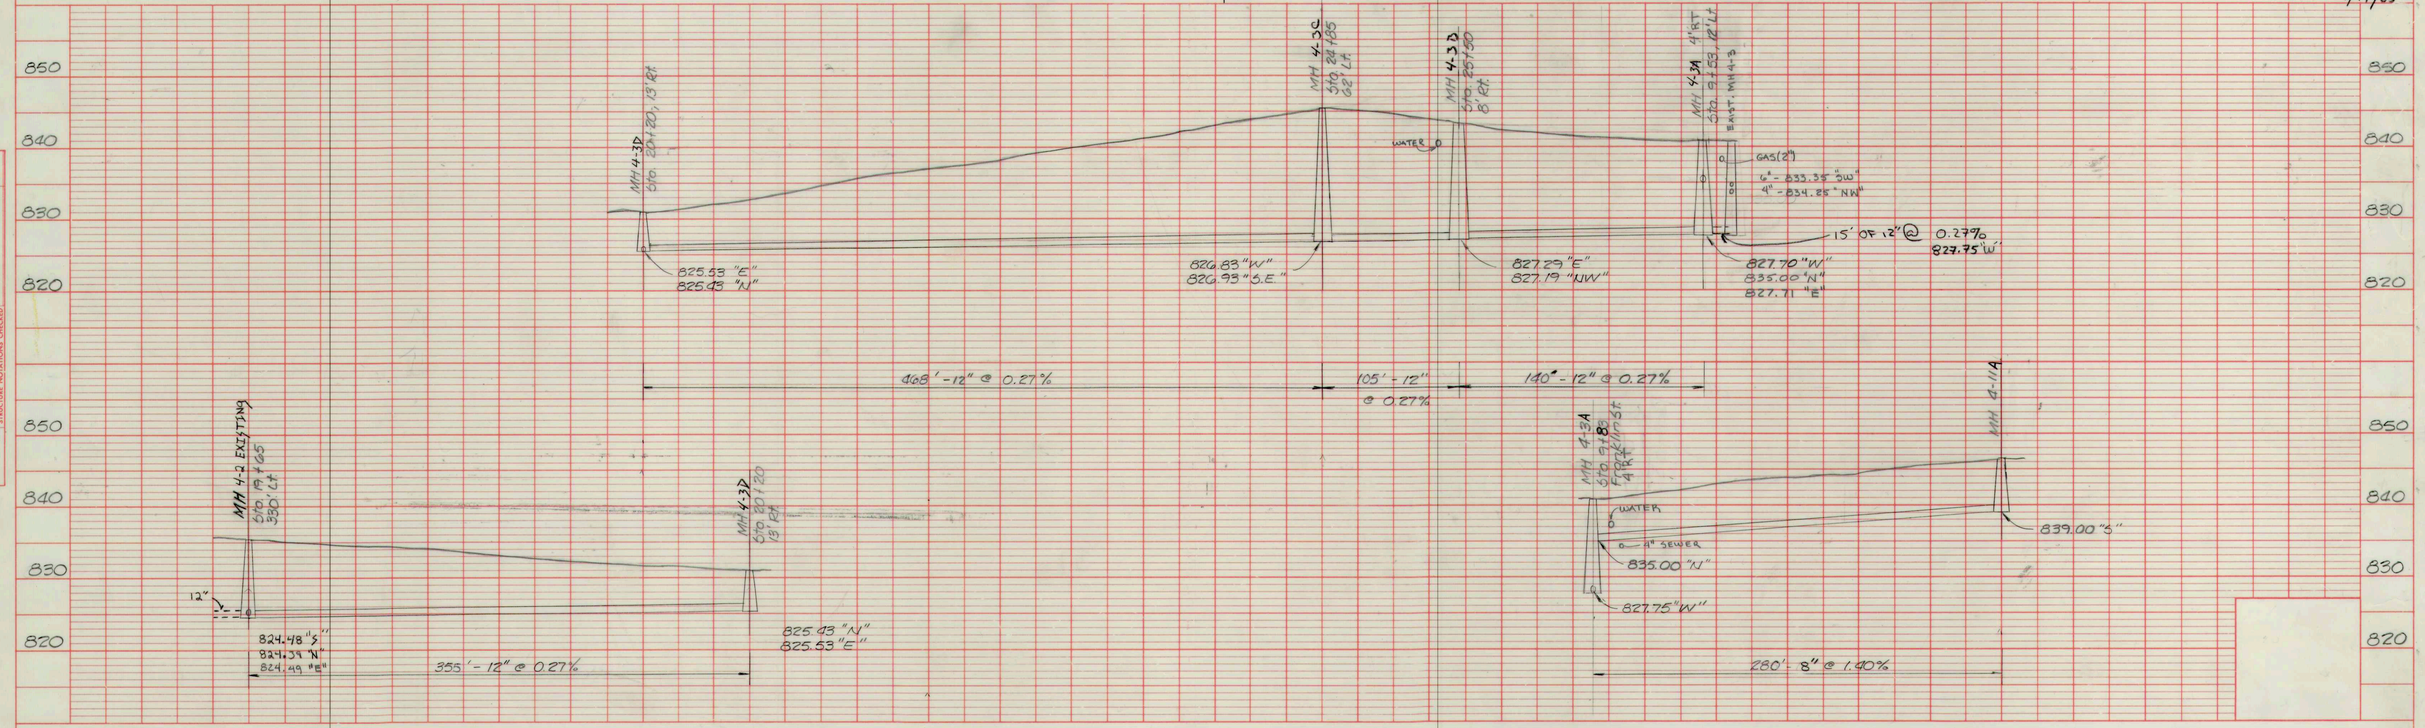

PLAN — SURVEYED / PLOTTED / ALIGNMENT CHECKED / TE. OF WAY CHECKED — BY R. Mitchell, J. Baird — DATE — NOTE BOOK No.

PROFILE — SURVEYED / PLOTTED / GRADES CHECKED / R.R. CROSSINGS / STRUCTURE NOTATIONS CHECKED — BY R. Mitchell, J. Baird — DATE — NOTE BOOK No.

PLATE 1 - PLAN - PROFILE B. R. R. STANDARD 1975

RECORD DRAWING

PROJECT NO.	LINE	SHEET NO.	TOTAL SHEETS	FILE
LINE "E"		48A		

TP.14