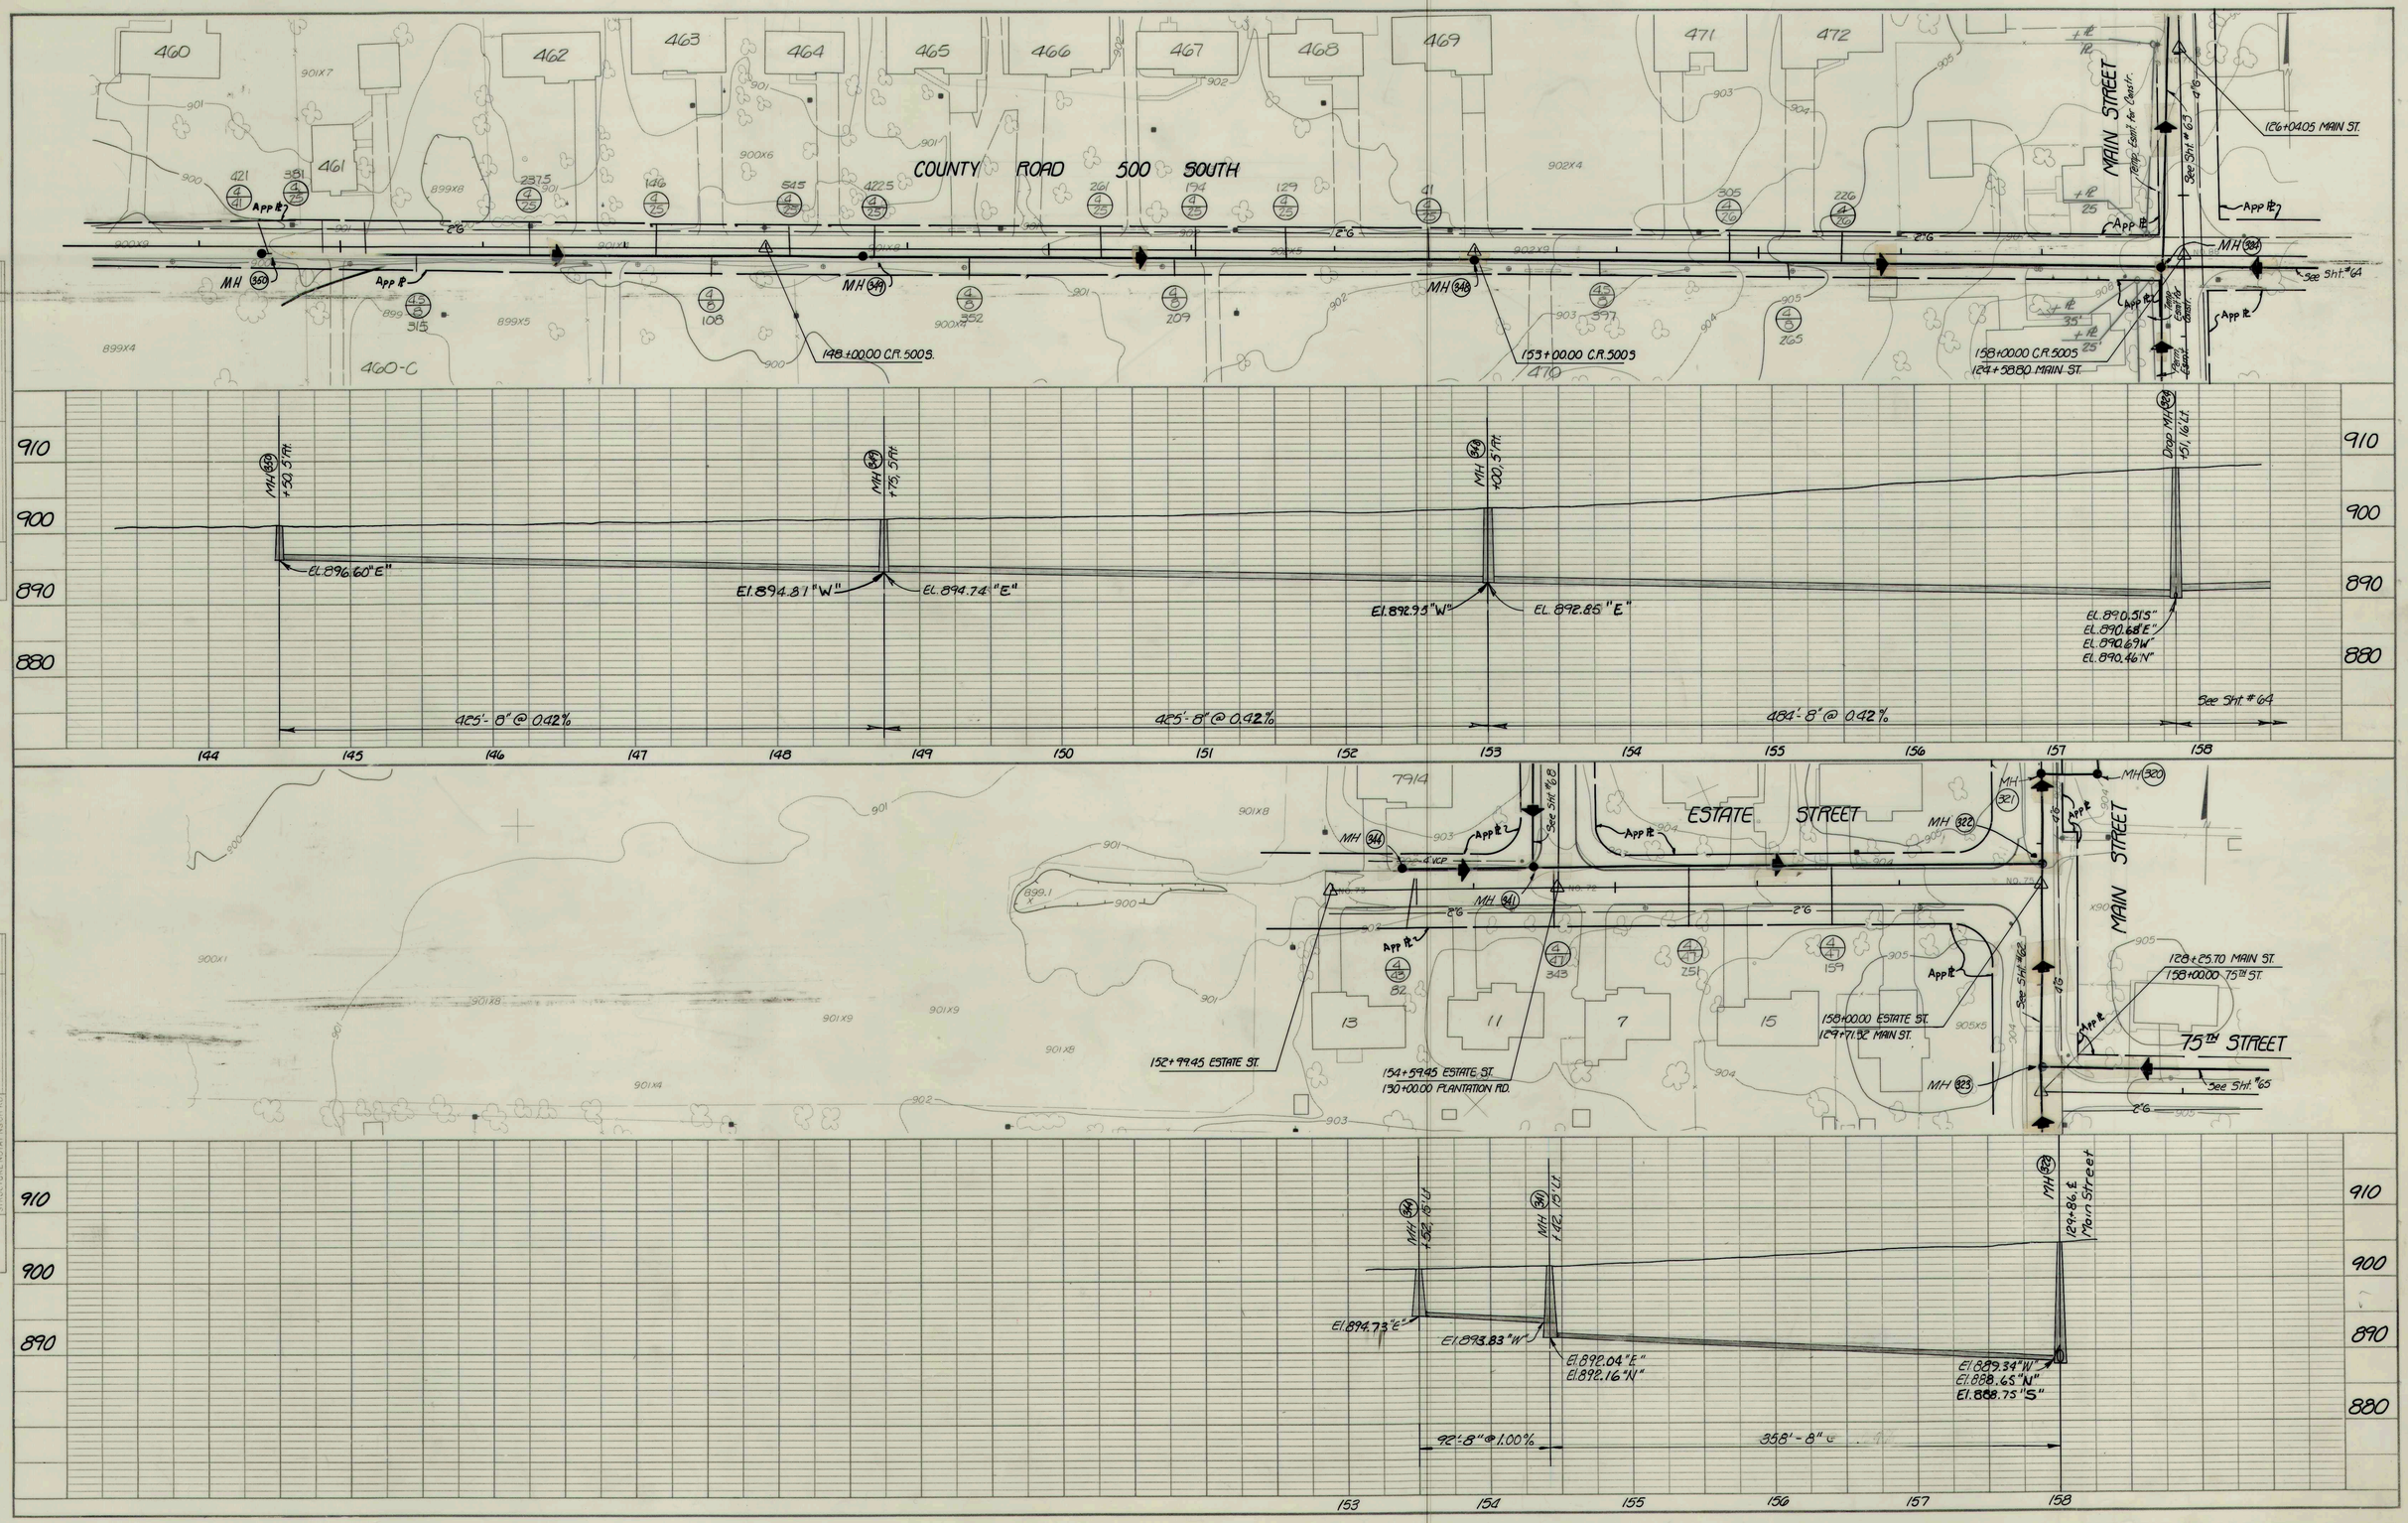

PLAN — SURVEYED, PLOTTED, ALIGNMENT CHECKED, PROF. OF WAY CHECKED — NOTE BOOK NO. — BY — DATE

PROFILE — SURVEYED, PLOTTED, GRADES CHECKED, BY — NOTE BOOK NO. — STRUCTURE NOTATIONS CHKD. — BY — DATE

RECORD DRAWING

ERIC RESKE REGISTERED ER No. 13442 STATE OF INDIANA PROFESSIONAL ENGINEER

Co. Rd. 500 S / ESTATE ST.		
FALL CREEK R.W.D. PLAN & PROFILE		SHEET
HORIZ. 1"=50'	BEAM, LONGEST & NEFF, INC.	69
VERT. 1"=10'	CONSULTING ENGINEERS	
	INDIANAPOLIS, INDIANA	

PHOTOGRAMMETRIC COMPILATION BY ACCU-TAP SURVEYS, INC. SEYMOUR, INDIANA