D	C	E	G
4"	1'-0"	6"	6"
6"	1'-3"	8"	8"
12"	2'-6"	1'-3"	1'-3"
15"	3'-0"	1'-6"	1'-6"

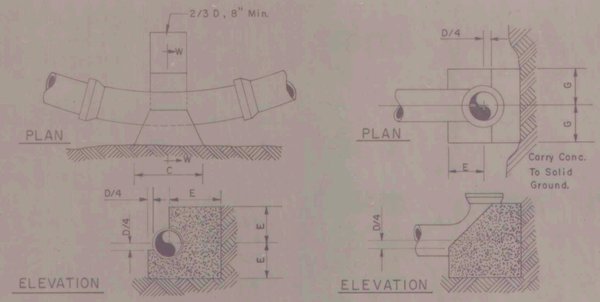

THRUST BLOCK FOR HORIZONTAL BEND

THRUST BLOCK FOR VERTICAL ELBOW

Scale: None

(Thrust Blocks To Be Provided At All Bends In Force Mains)

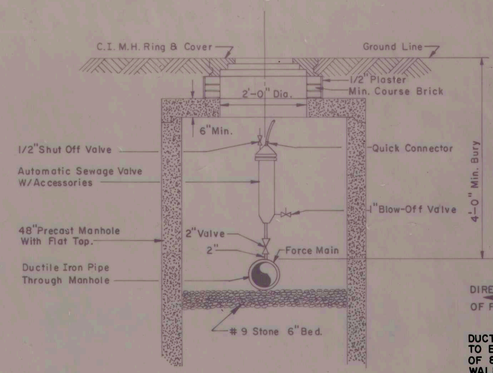

FORCE MAIN AIR RELEASE

SCALE: NONE

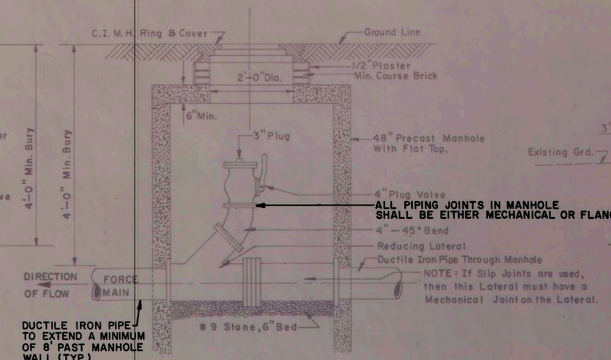

CLEANOUTS FOR FORCE MAINS

SCALE: NONE

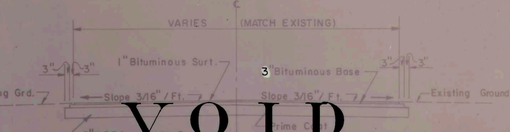

VOID

BITUMINOUS PAVEMENT TYPICAL SECTION FOR ROADWAY REPLACEMENT

SCALE: NONE

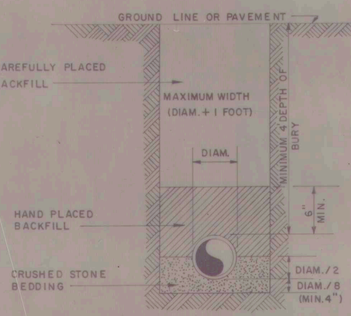

FORCE MAIN TRENCH DETAIL

SCALE: NONE

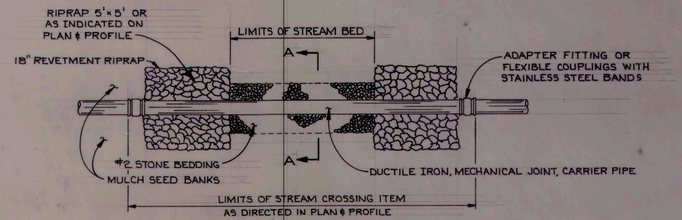

PLAN VIEW

NO SCALE

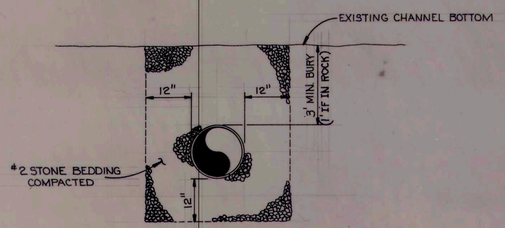

SECTION A-A

NO SCALE

STREAM CROSSING DETAIL

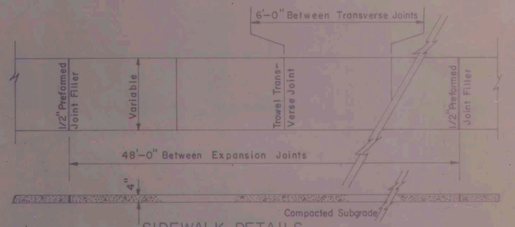

SIDEWALK DETAILS

-NO SCALE-

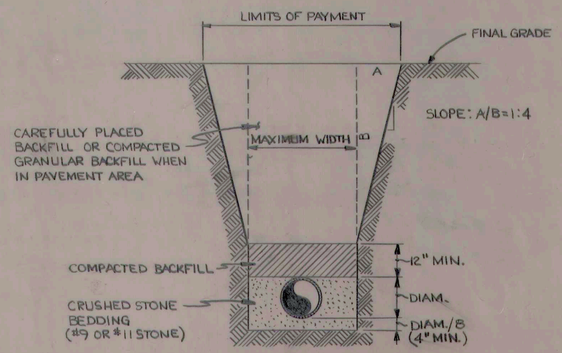

FLEXIBLE PIPE GRAVITY SEWER TYPICAL TRENCH DETAIL

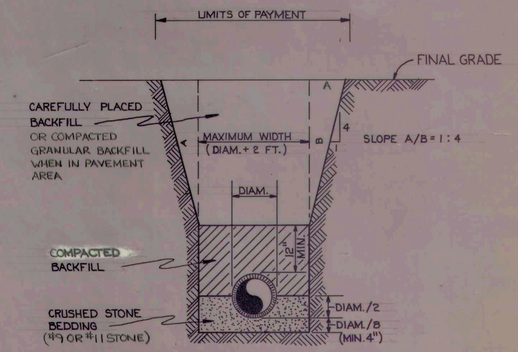

RIGID PIPE GRAVITY SEWER TYPICAL TRENCH DETAIL

RECORD DRAWING

ERIC RESKE REGISTERED CE No. 13442 STATE OF INDIANA 12-30-83 PROFESSIONAL ENGINEER

MISCELLANEOUS DETAILS		
JOB NO. 825	FALL CREEK WASTEWATER FACILITIES	SHEET NO. 81
DATE 3-30-83	BEAM, LONGEST & NEFF, INC. CONSULTING ENGINEERS 8136 CASTLETON ROAD INDIANAPOLIS, INDIANA	
DR. BY: JCB.		
CERTIFIED BY: E.R.		

1976