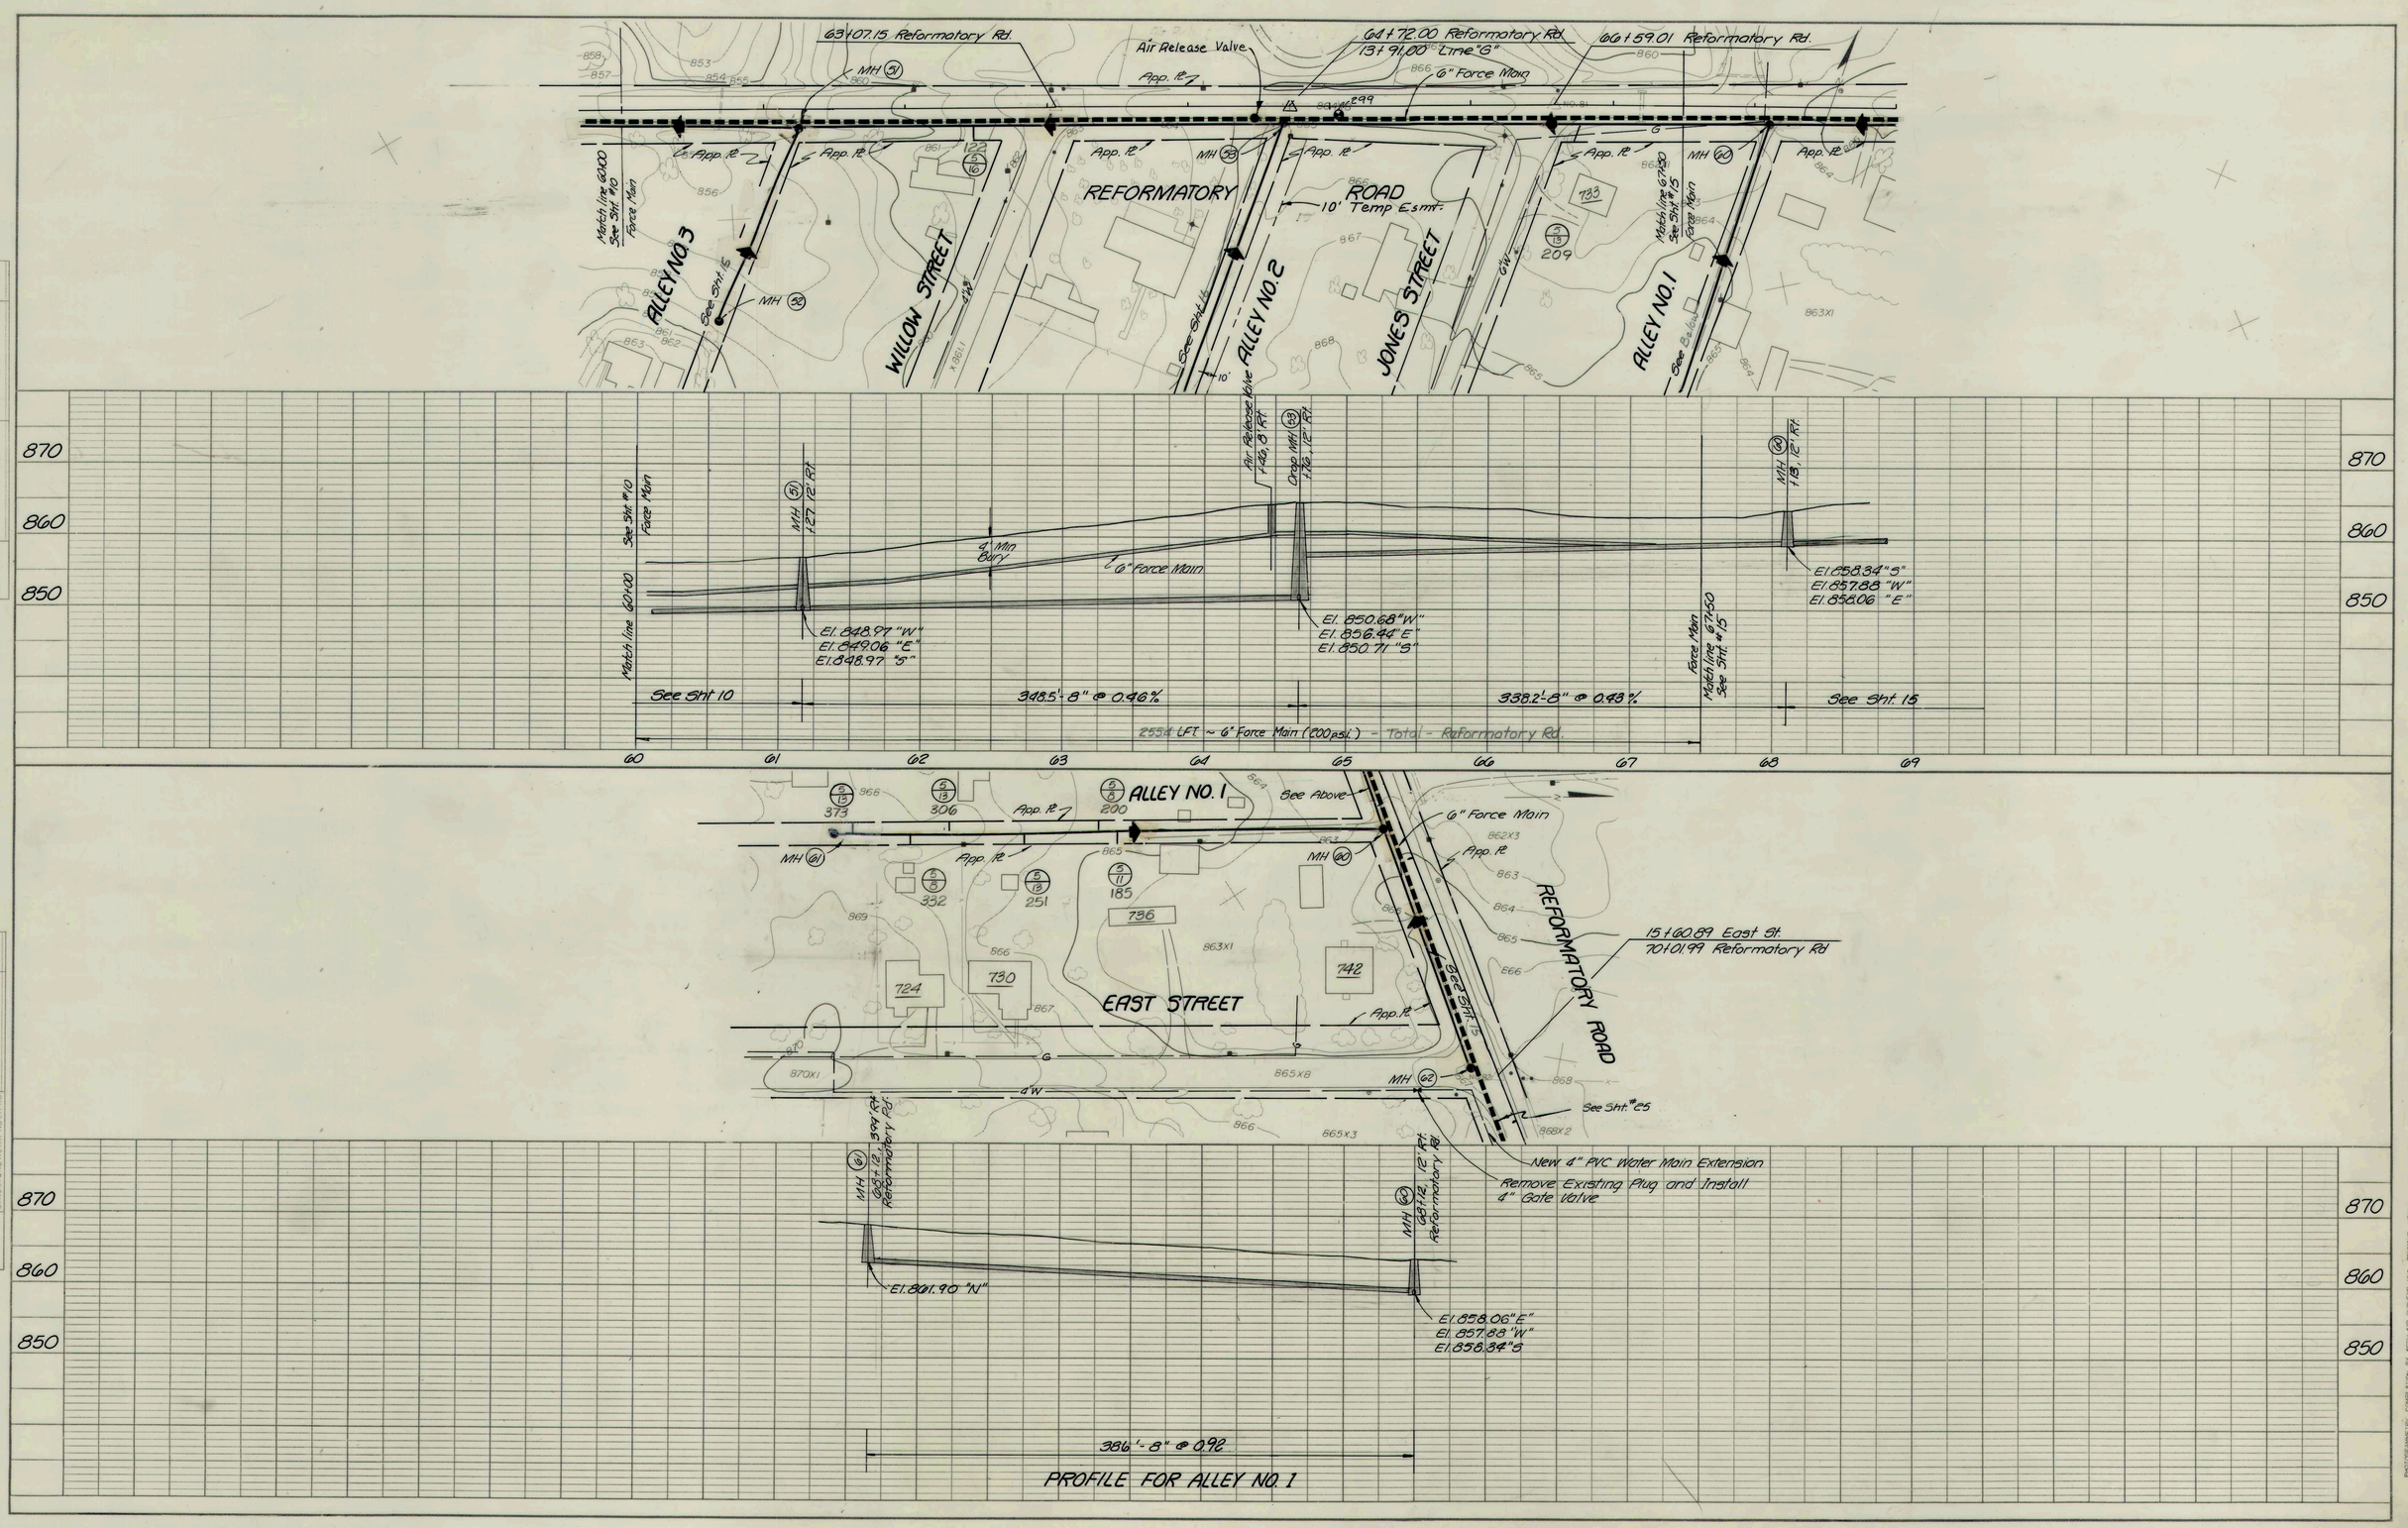

RECORD DRAWING

ERIC RESKE
REGISTERED
No. 13442
3-30-83
STATE OF INDIANA
PROFESSIONAL ENGINEER

REFORMATORY RD. ALLEY # 1		
FALL CREEK R.W.D. PLAN & PROFILE		SHEET
HORIZ. 1" = 50'	BEAM, LONGEST & NEFF, INC.	14
VERT. 1" = 10'	CONSULTING ENGINEERS	
	INDIANAPOLIS, INDIANA	

PHOTOGRAMMETRIC COMPILATION BY ACCU-AIR SURVEYS, INC. SEYMOUR, INDIANA