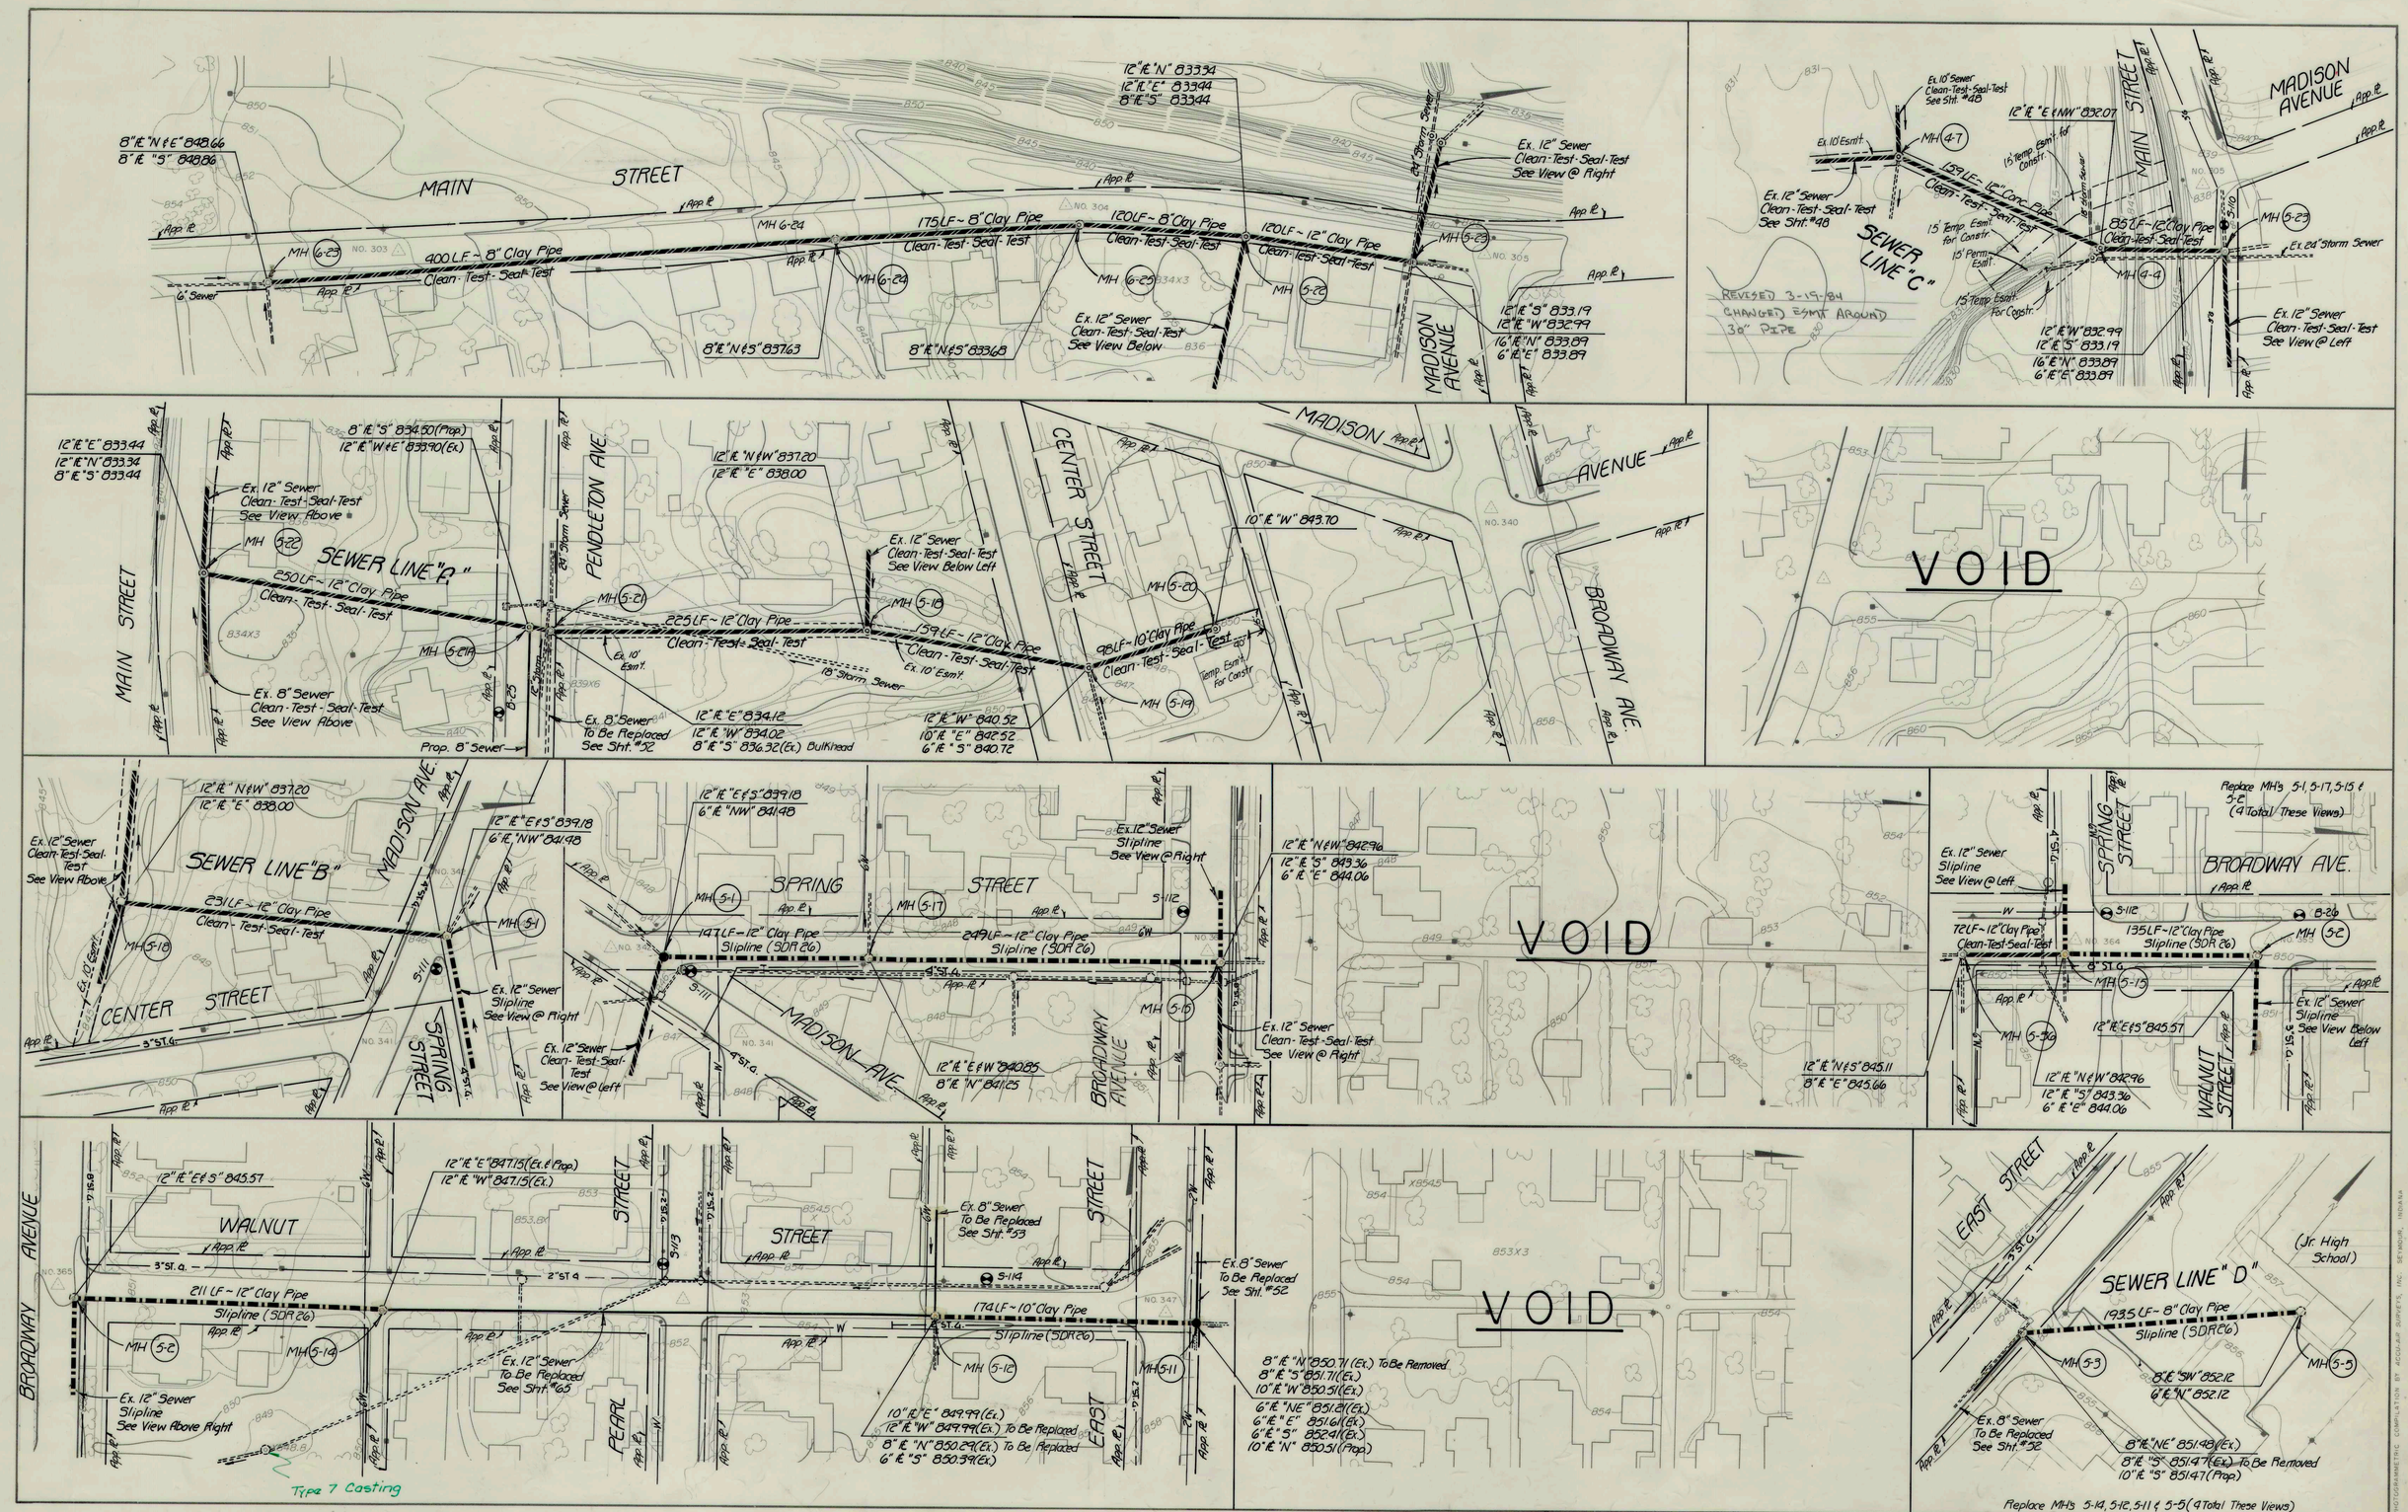

RECORD DRAWING

ERIC RESKE
REGISTERED
No. 13142
3-30-83
STATE OF INDIANA
PROFESSIONAL ENGINEER

MAIN ST., SEWER LINE "C", SEWER LINE "A", WALNUT ST., SPRING ST., BROADWAY AVE. & SEWER LINE "B & D"

FALL CREEK R.W.D. PLAN

HORIZ. 1" = 50'
VERT. 1" = 10'

BEAM, LONGEST & NEFF, INC.
CONSULTING ENGINEERS
INDIANAPOLIS, INDIANA

SHEET 49

SLIPLINE / CLEAN-TEST-SEAL-TEST

PHOTOGRAMMETRIC COMPILATION BY AERIAL SURVEYS, INC. SEYMOUR, INDIANA