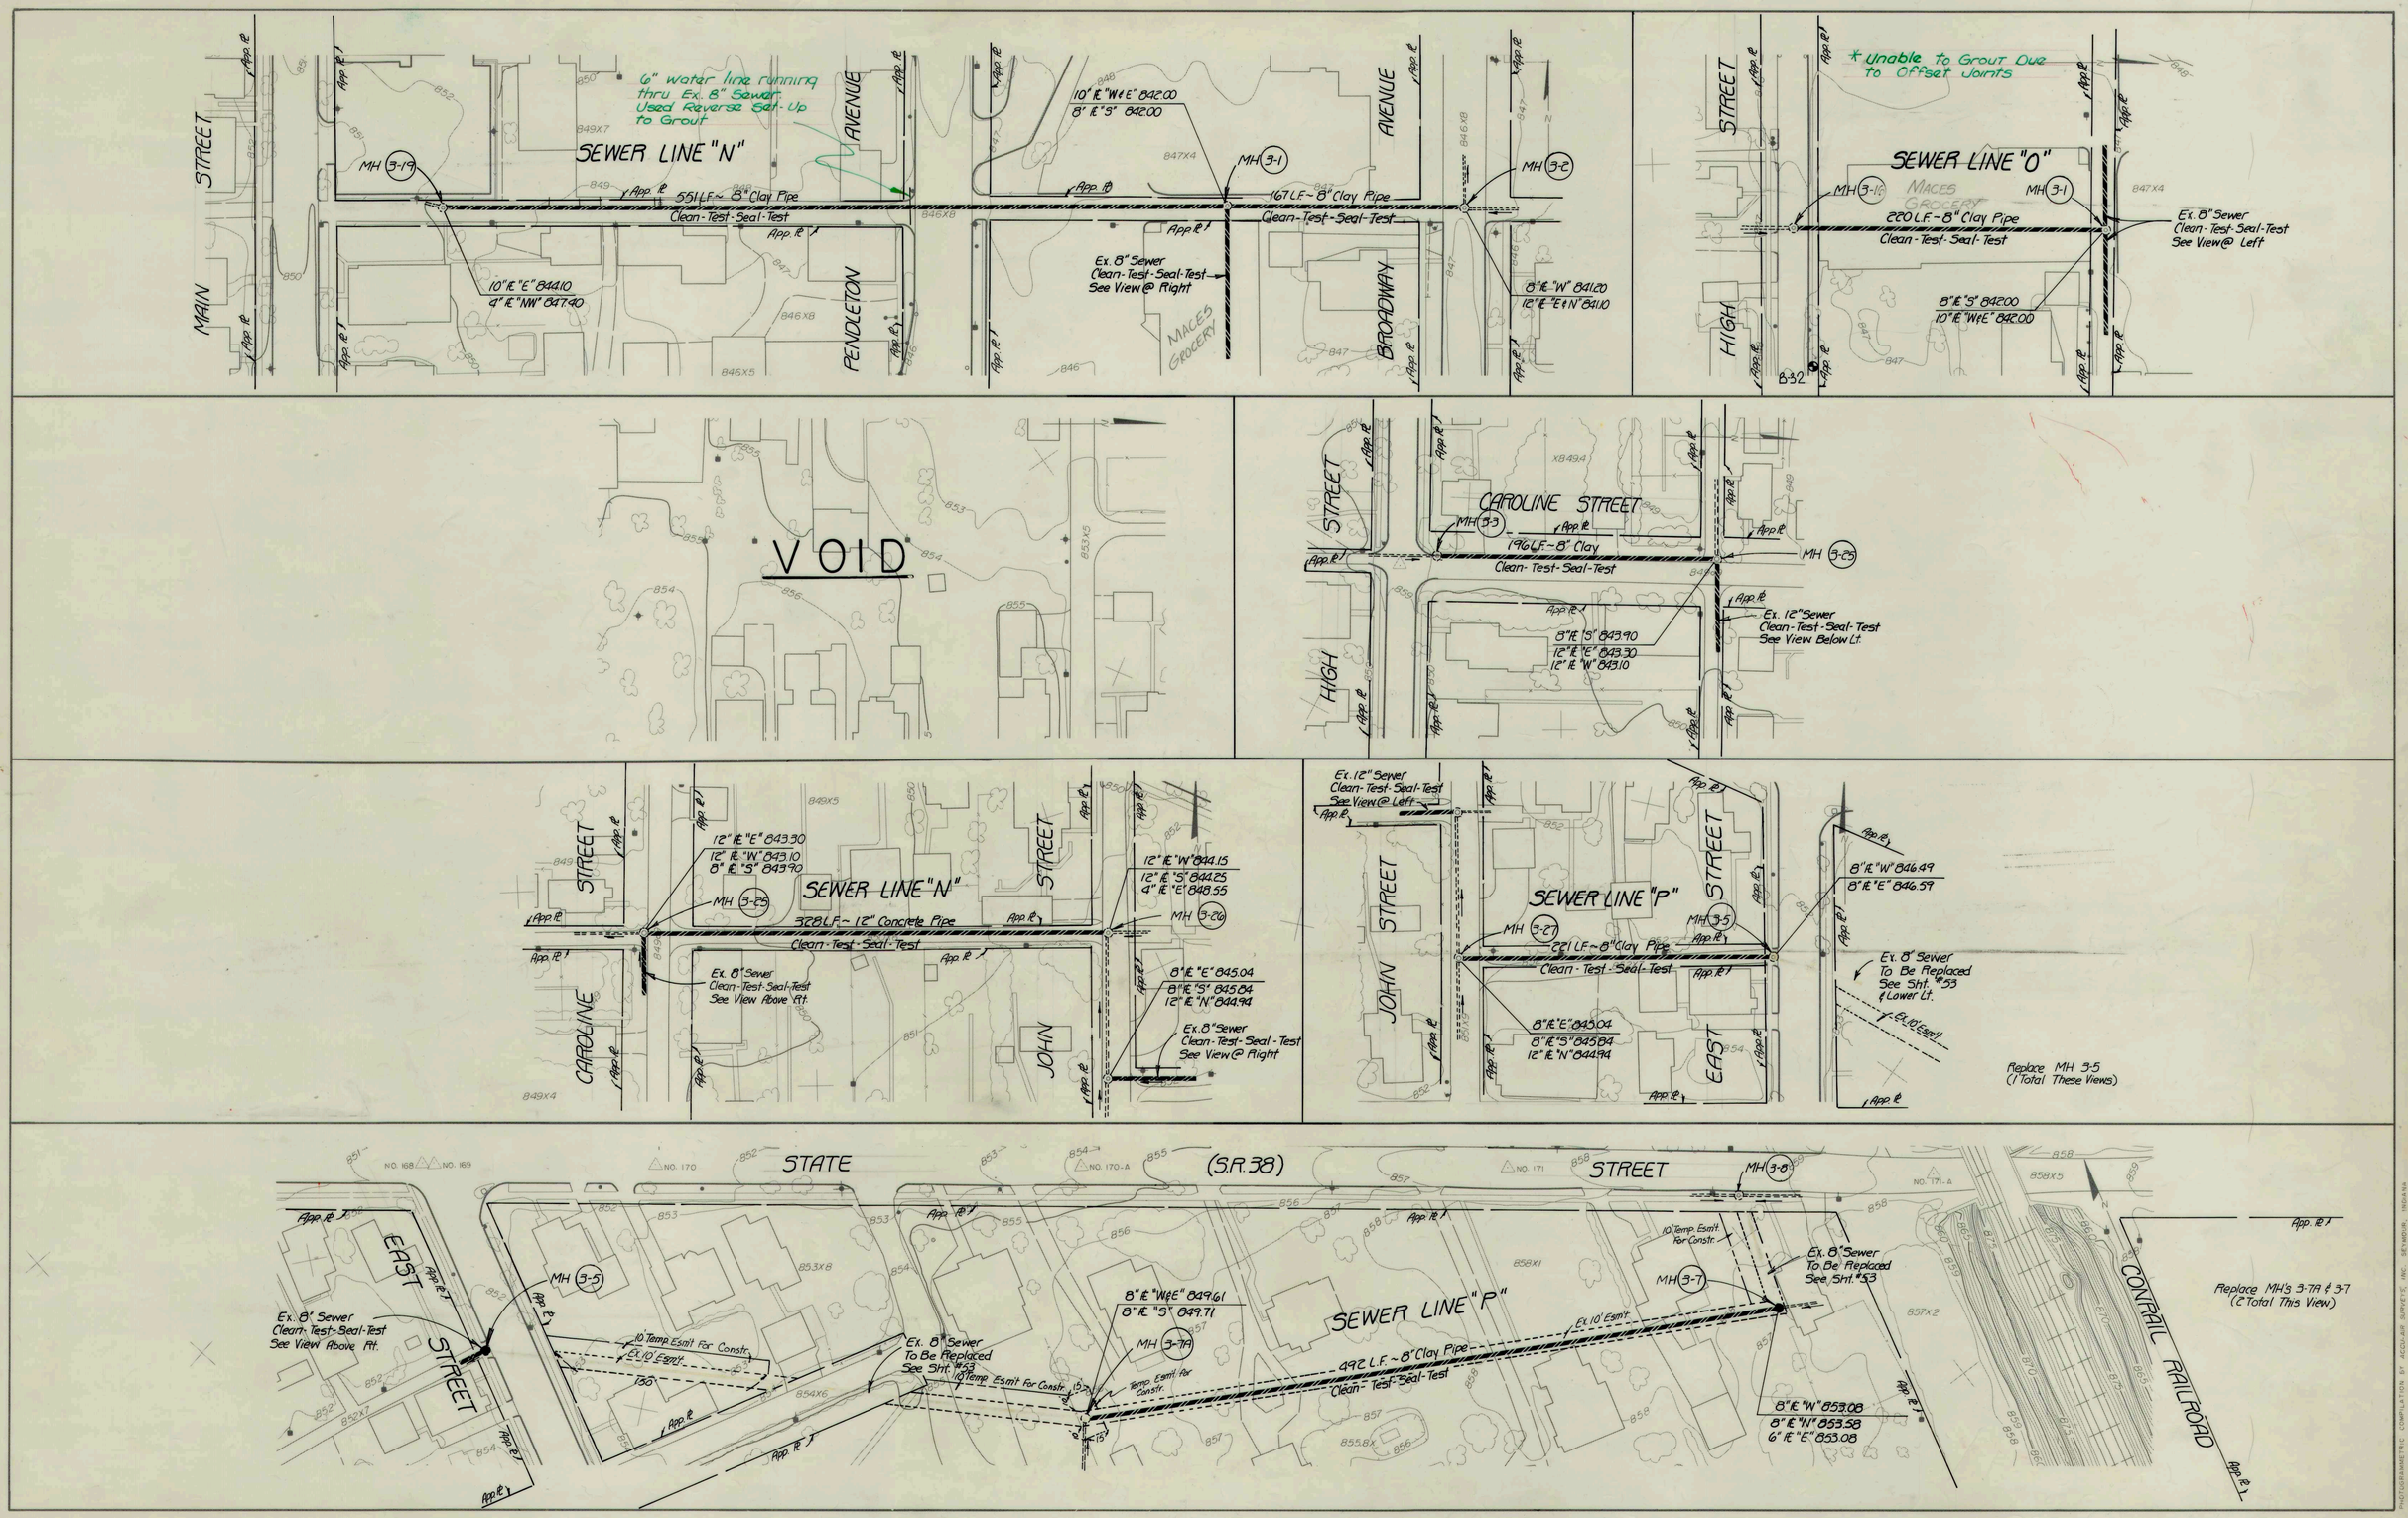

RECORD DRAWING

ERIC RESKE REGISTERED No. 13442 STATE OF INDIANA PROFESSIONAL ENGINEER

SEWER LINE "N", SEWER LINE "O", CAROLINE ST., & SEWER LINE "P"	
FALL CREEK R.W.D. PLAN	SHEET
HORIZ. 1" = 50'	BEAM, LONGEST & NEFF, INC. CONSULTING ENGINEERS INDIANAPOLIS, INDIANA
VERT. 1" = 10'	50
CLEAN-TEST-SEAL-TEST	

PHOTOGRAMMETRIC COMPILATION BY ACCU-AIR SURVEYS, INC. SEYMOUR, INDIANA