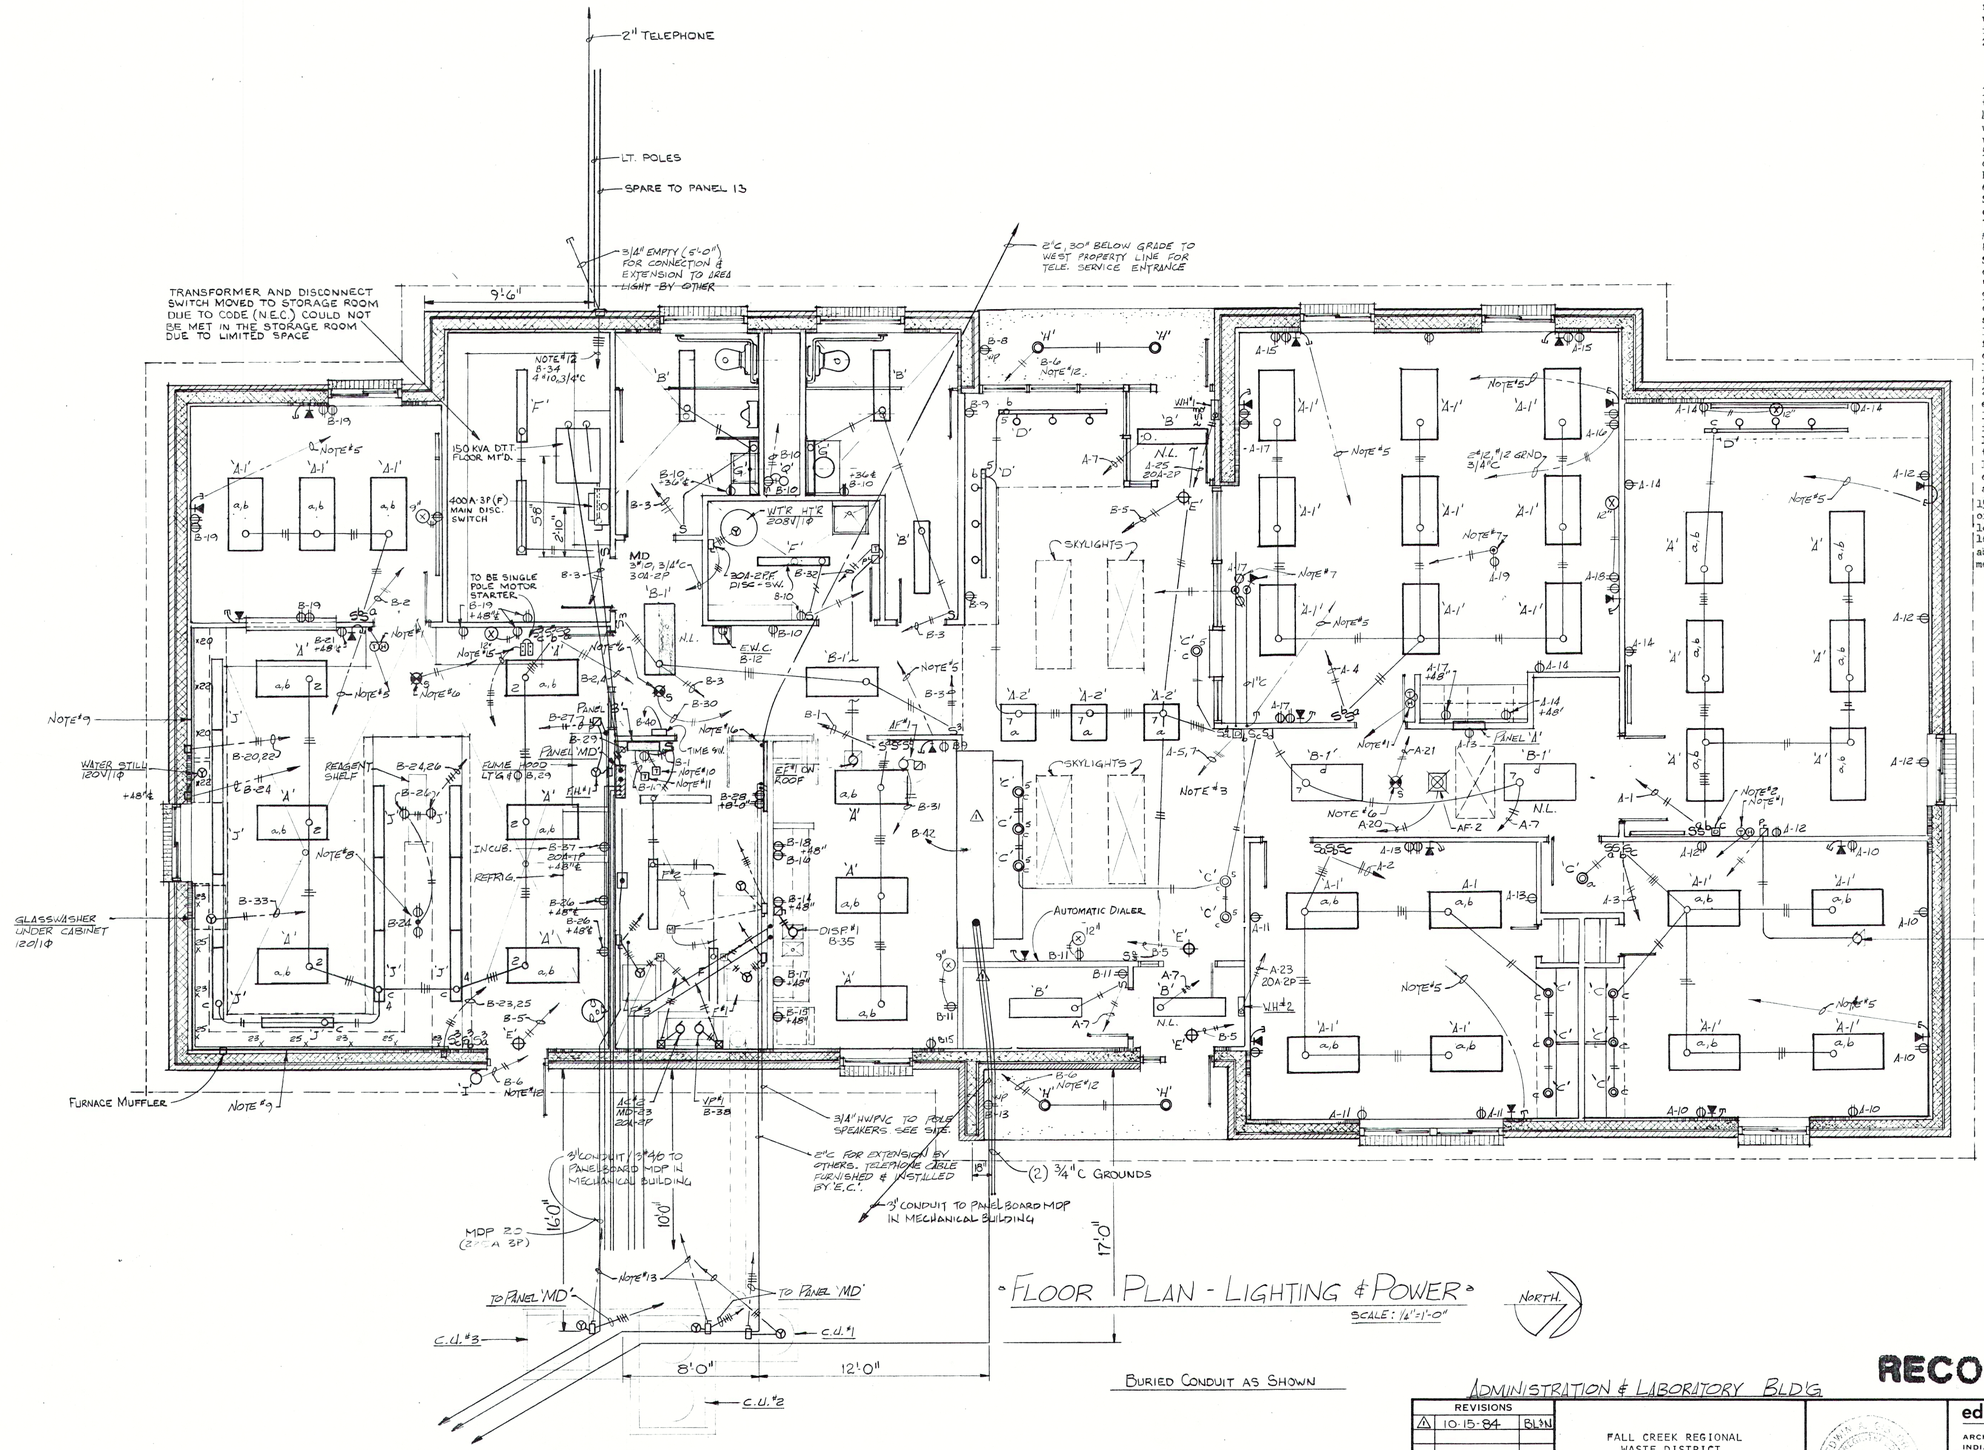

FLOOR PLAN - LIGHTING & POWER

SCALE: 1/4"=1'-0"

BURIED CONDUIT AS SHOWN

NOTES: (ADMIN. BLDG.)

1. Thermostat and humidistat by others installed and wired by "E.C.". 7#14, 3/4" c to respective Furnace-Heat Pump Unit. Verify wire count with manufacturer prior to rough-in.
2. Incandescent dimmer unit 600 watt at 120V.
   Thyrocon #PP-800UL
   Hunt #PC-610UL
   Decor 1-600UL
3. Same as Note #2 except to be 1000 watt type dimmer.
4. ℡ indicates telephone outlet flush in wall with 3/4" conduit (unless otherwise noted) up wall and turned out above lay-in ceiling.
5. Telephone cable by "E.C." above lay-in ceiling to telephone equipment in Utility Room #118.
6. 120 volt ceiling mounted smoke detector. Square "D" ERSD-4S, Pyrentronics, Edwards, or approved equal.
7. Floor outlets to be Steel City Series #98 with SFH and SFL metal service heads.
8. Double sided floor type service head Steel City #SFH-50-2RG mounted on top of lab counter, wiring in base cabinet area, by "E.C."
9. Wiremold #2000 series with outlets 30" on center #2000BA Series. Locate on top of back splash on counter.
10. Time clock for control of canopy light fixture Type "H". Paragon #4003-005, Tork, or equal.
11. Time clock for control of parking lot and front entrance light fixtures. Connect B-34 20A-2P breaker. Paragon #4003-005, Tork, or equal.
12. 2#12, 3/4" c to time clock at Panel "B" in Utility Room #118.
13. Heat pump control circuit (3#14, 3/4"c) to respective furnace control unit.
14. ▭ indicates fixture (2 lamps) connected ahead of switching for 24 hour operation as night light.
15. Remote "Start-Stop" P.B. Stations for control of AC#2 & VP #1. 6#14, 3/4" c to starter locations in Utility Room.
16. 4'-0" wide x 8'-0" high x 3/4" plywood @ 6" above fin. flr. for mounting of telephone equipment.

ADMINISTRATION & LABORATORY BLD'G

RECORD DRAWING

REVISIONS		
1	10-15-84	BLSN

FALL CREEK REGIONAL WASTE DISTRICT
WASTEWATER FACILITIES

PENDLETON, INDIANA

STATE OF INDIANA REGISTERED No. 730 ARCHITECT

ed gibson and associates
INCORPORATED
ARCHITECTS
INDIANAPOLIS, INDIANA

DRAWN BY M.W.B. | ACCT. NO.
CHECKED BY L.R.S. | DATE
CERTIFIED BY

SHEET NO. E-1
64 OF