2-14-22

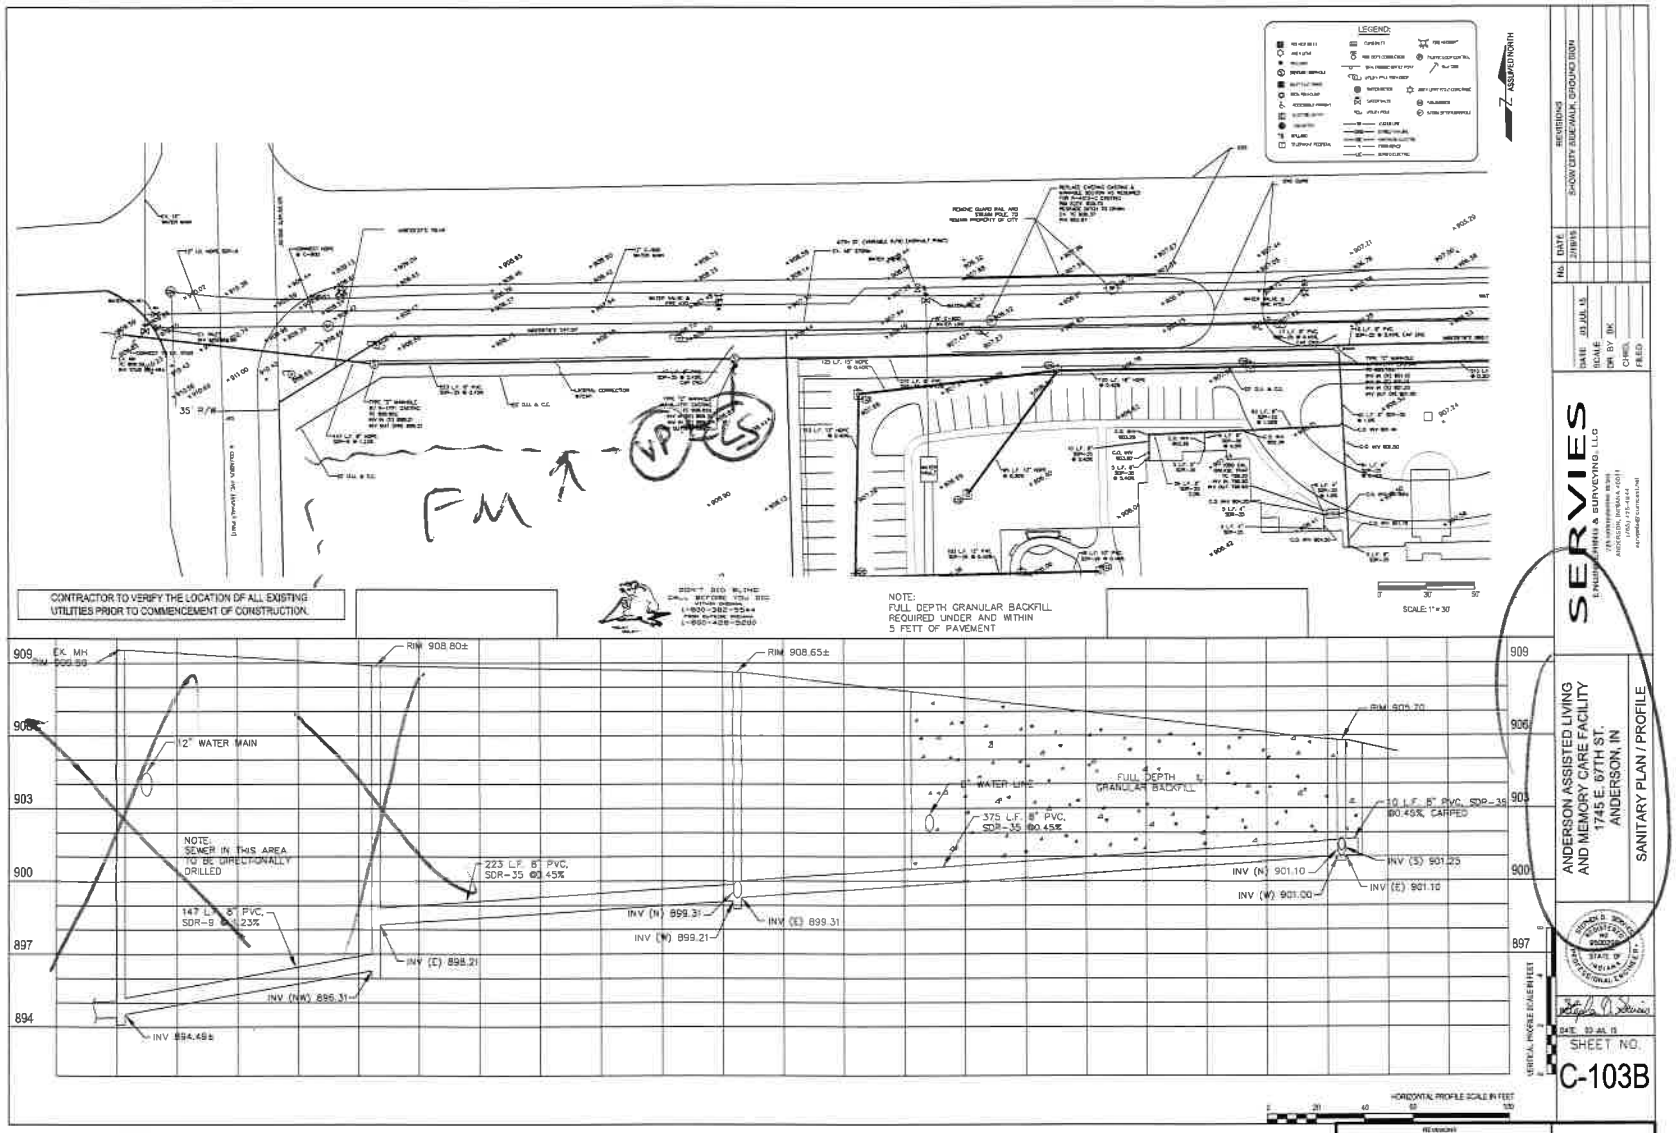

Ass. Living