PRINTED: 3/11/2017 @ 2:12PM

FILE NAME: G:\4447-FCRWD-2015\Working Drawings\AutoCAD\REHABILITATION PHASE II\4447-24-C-02.dwg

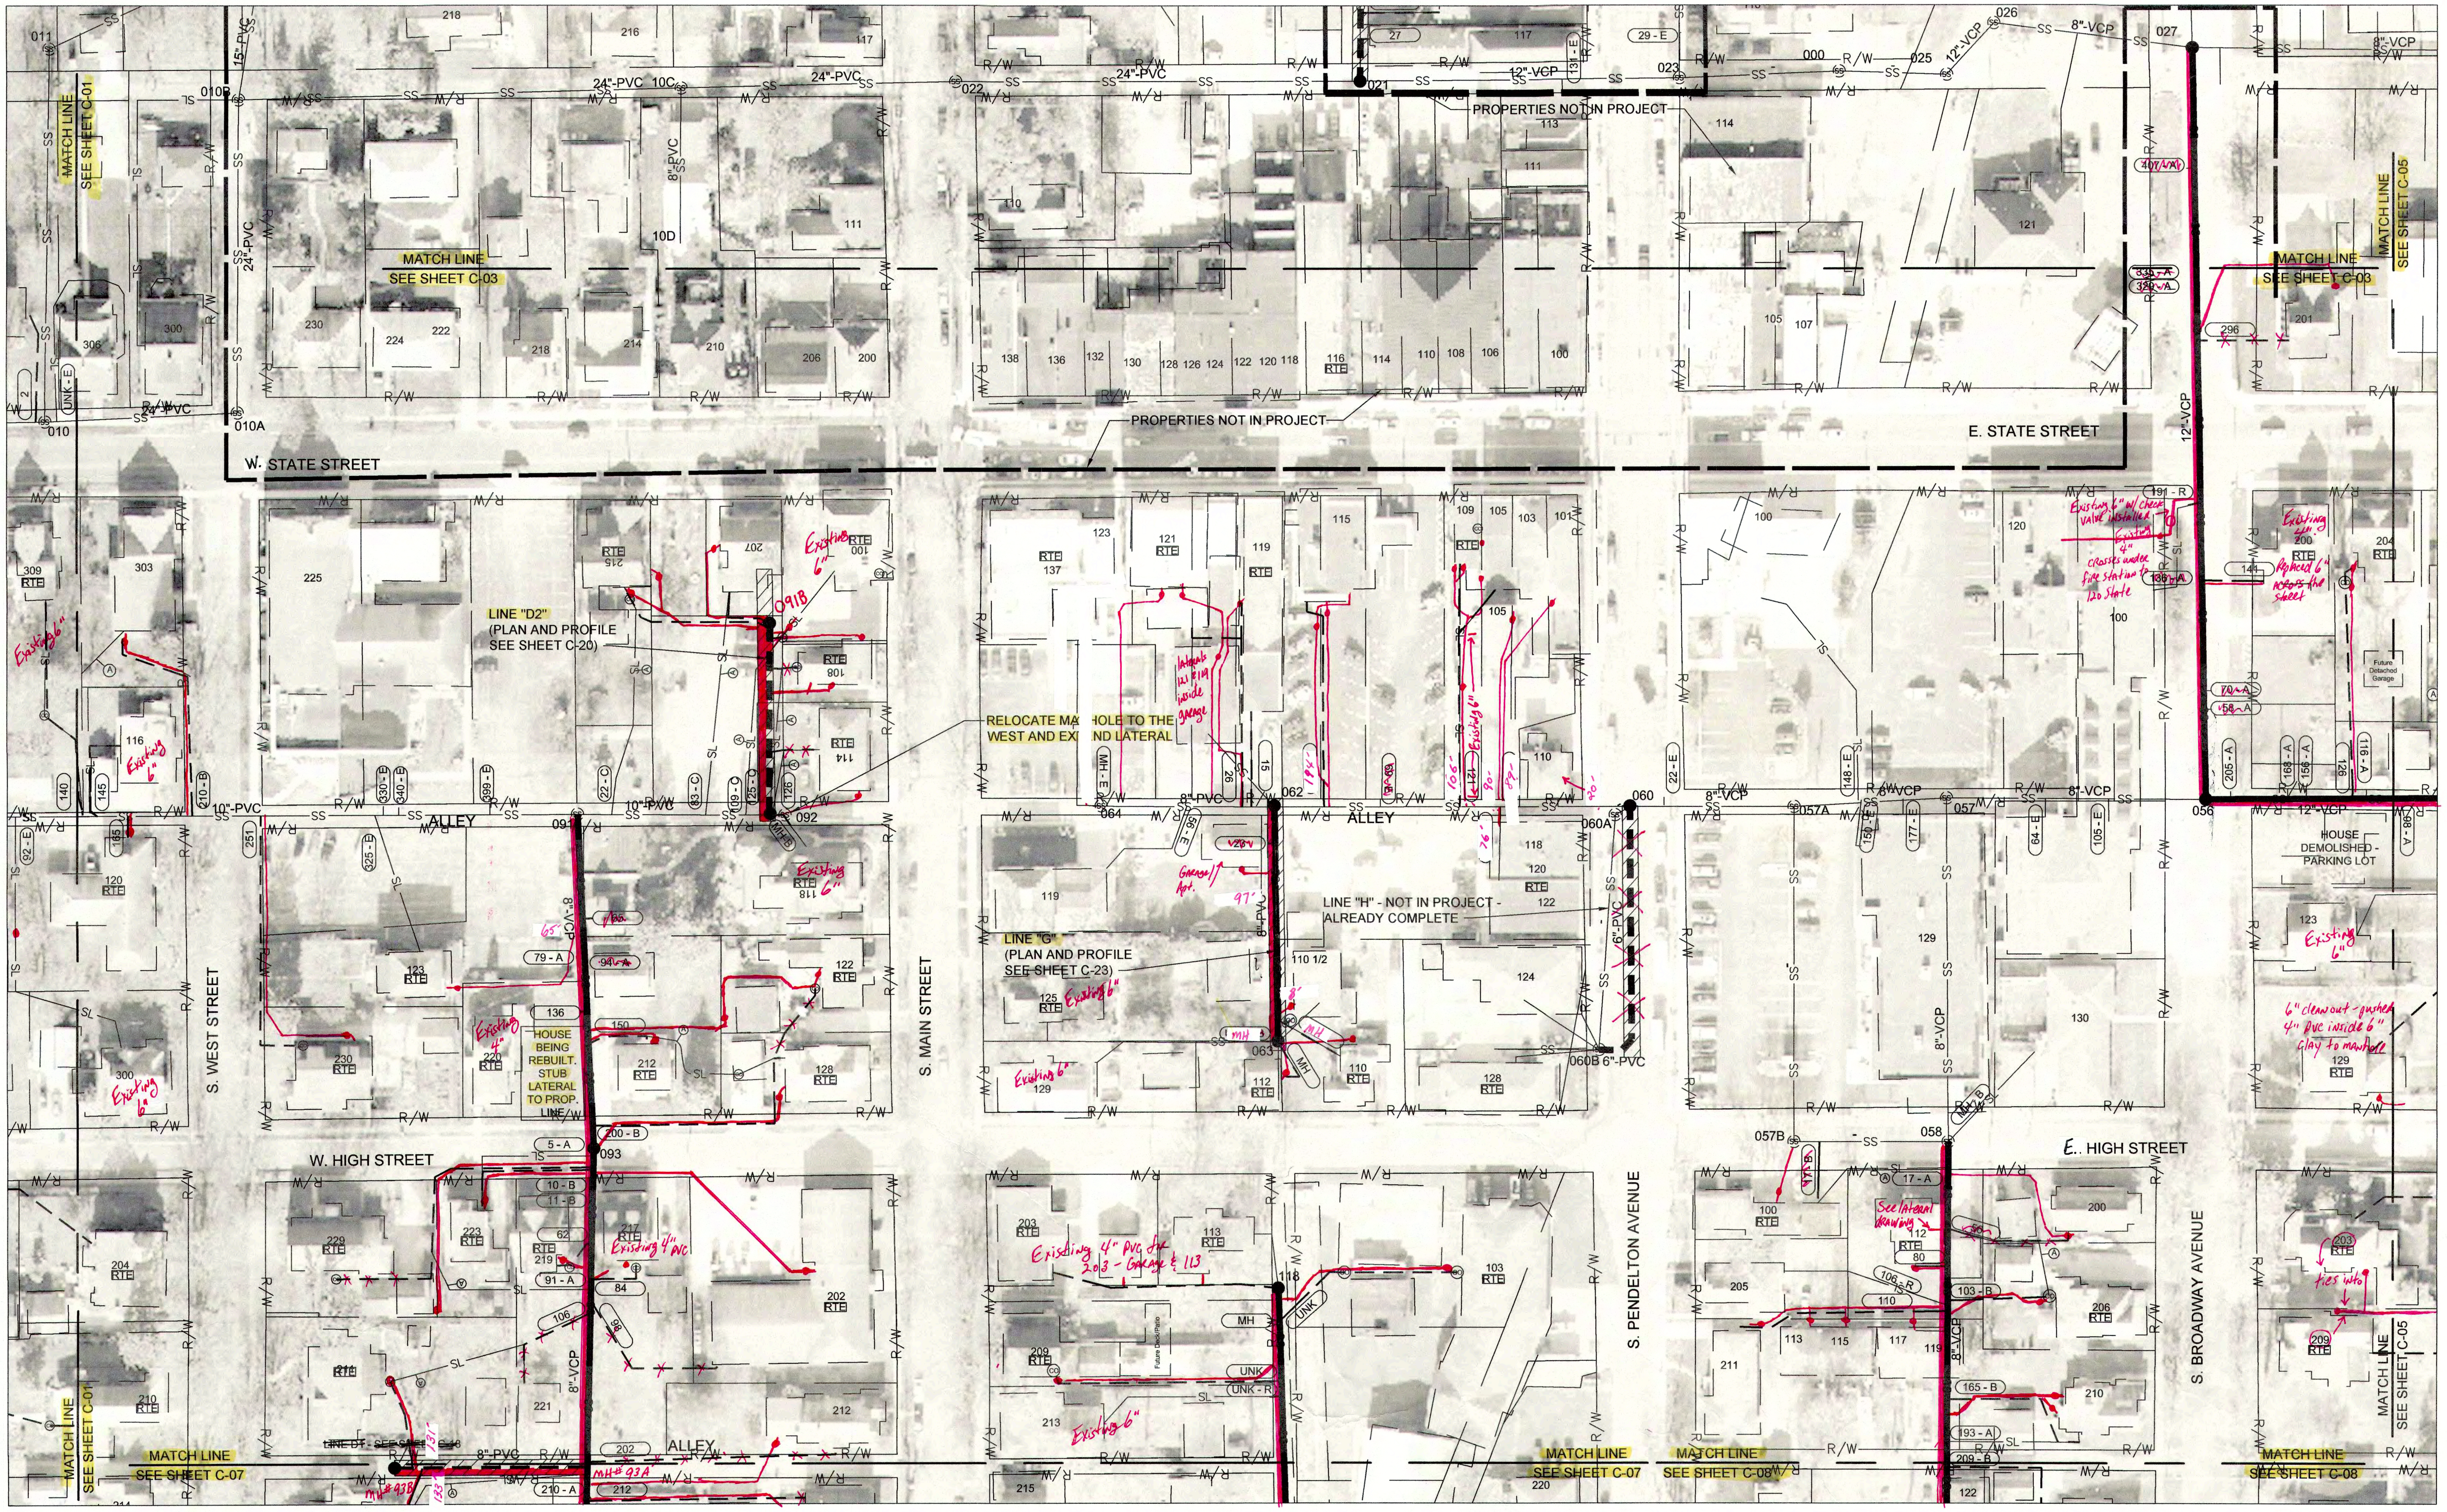
MATCH LINE SEE SHEET C-01
MATCH LINE SEE SHEET C-03
MATCH LINE SEE SHEET C-05
MATCH LINE SEE SHEET C-07
MATCH LINE SEE SHEET C-08
W. STATE STREET
E. STATE STREET
W. HIGH STREET
E. HIGH STREET
S. WEST STREET
S. MAIN STREET
S. PENDELTON AVENUE
S. BROADWAY AVENUE
ALLEY
PROPERTIES NOT IN PROJECT
LINE "D2" (PLAN AND PROFILE SEE SHEET C-20)
LINE "G" (PLAN AND PROFILE SEE SHEET C-23)
LINE "H" - NOT IN PROJECT - ALREADY COMPLETE
RELOCATE MANHOLE TO THE WEST AND EXTEND LATERAL
HOUSE BEING REBUILT. STUB LATERAL TO PROP. LINE
HOUSE DEMOLISHED - PARKING LOT
Future Detached Garage
Future Deck/Patio
15"-PVC
24"-PVC
12"-VCP
8"-VCP
10"-PVC
8"-PVC
6"-PVC
010
010A
010B
10C
10D
011
021
022
023
025
026
027
000
056
057
057A
057B
058
060
060A
060B
062
063
064
091
091B
092
093
118
MH# 93A
MH# 93B
Existing 6"
Existing 4"
Existing 4" PVC
Existing 4" PVC for 203 - Garage & 113
laterals 121 & 119 inside garage
Garage/Apt.
Existing 6" w/ check valve installed
Existing 4" crosses under fire station to 120 State
Existing 4" Replaced 6" across the street
6" clean out - pushed 4" pvc inside 6" clay to manhole
See lateral drawing
ties into
65'
97'
194'
106'
90'
89'
76'
20'
8'
131'
133'

NOTES:

1. ALL LATERALS AND TAP LOCATIONS ARE BASED ON BEST INFORMATION AVAILABLE. CONTRACTOR SHALL FIELD VERIFY LOCATIONS OF LATERAL CONNECTIONS AND WHETHER LATERAL PIPES ARE ACTIVE OR ABANDONED BEFORE RECONNECTING OR ABANDONING THE CONNECTIONS.
2. UTILITY LOCATIONS ARE NOT SHOWN FOR LATERAL REPLACEMENT WORK. CONTRACTOR IS RESPONSIBLE FOR FIELD LOCATING ALL UTILITIES AND ADJUSTING PROPOSED LATERAL ROUTES AS NEEDED TO AVOID CONFLICTS.
3. FOR LATERAL REPLACEMENTS, CONTRACTOR SHALL FIRST VERIFY LOCATION OF EXISTING LATERALS & UTILITIES, THEN MEET WITH DISTRICT, ENGINEER AND PROPERTY OWNER TO DETERMINE ACTUAL ROUTE OF NEW LATERAL TO BE INSTALLED.
4. LATERAL REPLACEMENTS CONNECTING TO MAINS TO BE CIPP LINED MUST BE COMPLETED AFTER CIPP LINER IS IN PLACE SO THAT SADDLE CAN CONNECT DIRECTLY TO CIPP.

LEGEND

—SS— XX"	EXISTING SANITARY SEWER MAIN
(SS) MANHOLE NUMBER → #	EXISTING SANITARY SEWER MANHOLE
▬▬▬	SANITARY SEWER MAIN TO BE CIPP LINED
▨	SANITARY SEWER MAIN TO DIG AND REPLACED (SEE PLAN & PROFILE SHEETS)
●	SANITARY MANHOLE TO BE REPLACED OR REHABILITATED (SEE SCHEDULE ON SHEET C-43)
RTE	RIGHT TO ENTER DOCUMENT SIGNED BY PROPERTY OWNER
(P)	PLUMBING IN HOME TO BE RE-ROUTED BY DISTRICT
(A)	EXISTING PIPE SEGMENT TO BE ABANDONED
—SL—	EXISTING SANITARY SEWER LATERAL
(CO)	EXISTING SANITARY SEWER CLEANOUT
▬ ▬ ▬	SANITARY LATERAL REPLACEMENT
UNK	DISTANCE UNKNOWN
MH	EXISTING LATERAL TO BE CONNECTED TO EXISTING MANHOLE
xxx	EXISTING TAP LOCATION TO BE RECONNECTED - DISTANCE FROM MANHOLE
xxx - A	EXISTING TAP LOCATION TO BE ABANDONED
xxx - B	NEW TAP LOCATION TO BE ESTABLISHED
xxx - C	EXISTING TAP LOCATION TO BE DUG UP AND CAPPED/PLUGGED
xxx - E	EXISTING LATERAL CONNECTION - NO WORK NEEDED
xxx - R	DIG UP AND RECONNECT EXISTING PVC LATERAL TO CIPP LINED MAIN

NOTE:
SOURCE OF 2015 AERIAL IMAGERY IS FROM MADISON COUNTY GIS.

0' 50' 100'
SCALE: 1" = 50'

JOSEPH P. TIERNEY
No. 19300407

Joseph P. Tierney

GRW PROJECT NO. 4447-24

SRF NO. WW16074803

ALL RIGHTS RESERVED: THIS DOCUMENT IS THE PROPERTY OF GRW ENGINEERS, INC. AND SHALL NOT BE REPRODUCED IN WHOLE OR IN PART OR USED FOR CONSTRUCTION OF OTHER THAN THIS SPECIFIC PROJECT WITHOUT WRITTEN PERMISSION

engineering | architecture | geospatial
www.grwinc.com

SANITARY SEWER REHABILITATION PLAN

SEWER REHABILITATION PROJECT PHASE II
TOWN OF PENDLETON, INDIANA

DESIGNED: GWL
DRAWN: GCR
REVIEWED: GWL
APPROVED: JPT

REVISIONS

NO.	DESCRIPTION	DATE	BY
---	---	---	---

SCALE CHECK: THIS MARK SHOULD MEASURE EXACTLY 1" WHEN PLOTTED

DATE: MARCH 2017
SCALE: 1"=50'
SHEET NO. C-02