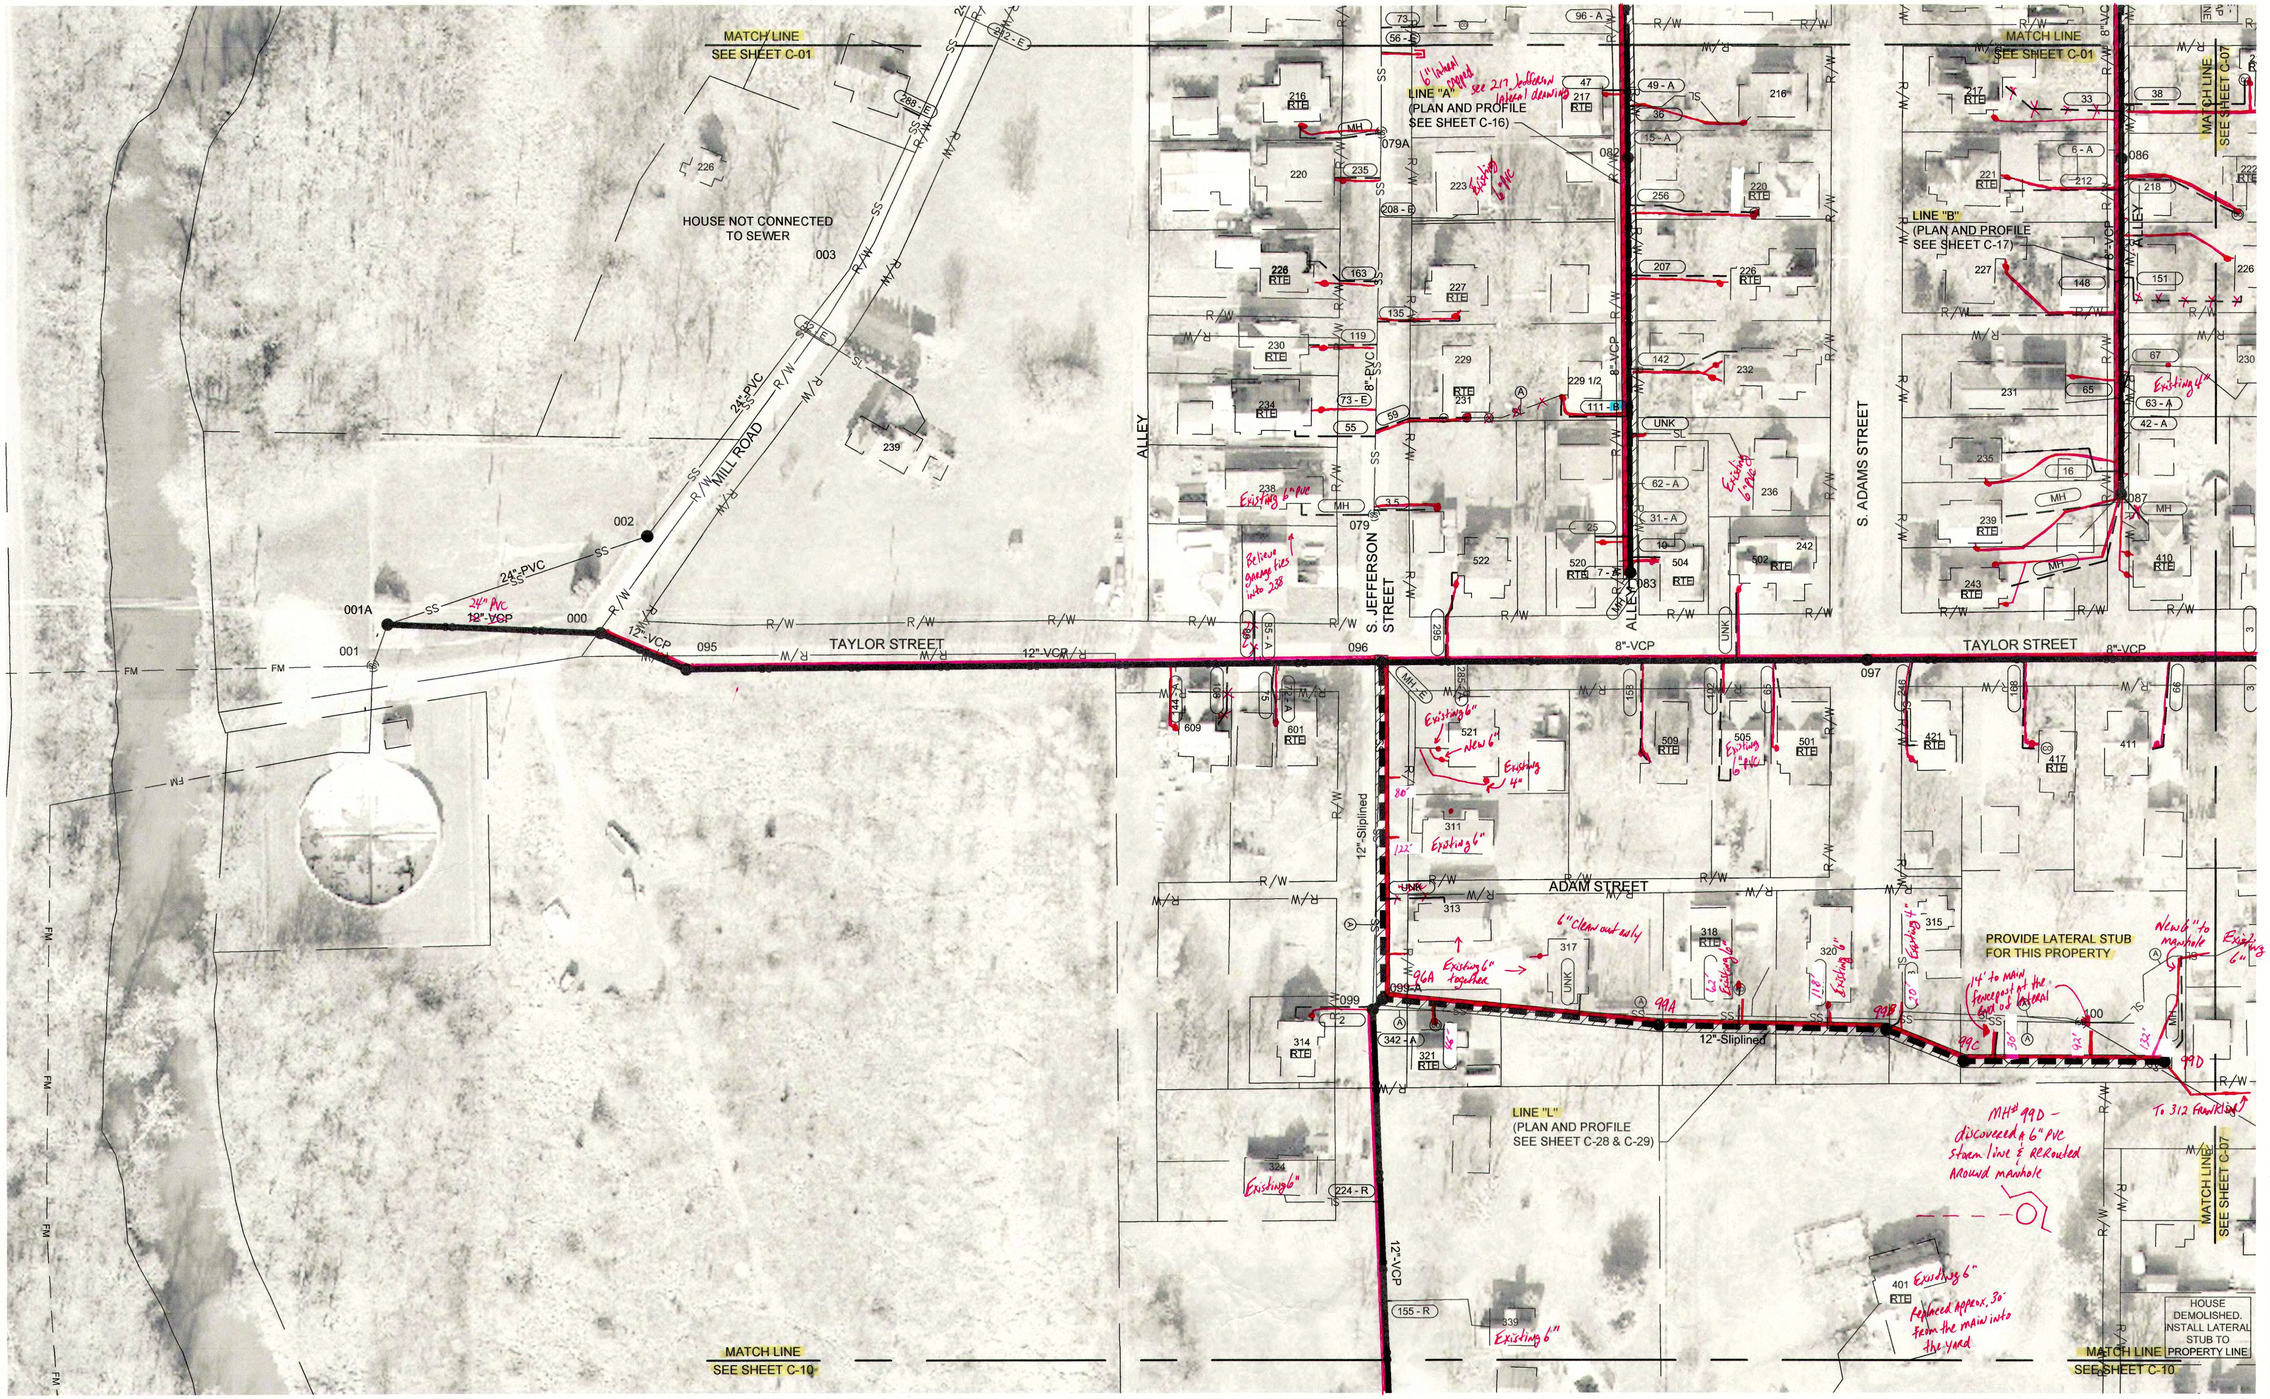
MATCH LINE
SEE SHEET C-01
HOUSE NOT CONNECTED TO SEWER
MILL ROAD
TAYLOR STREET
ALLEY
S. JEFFERSON STREET
S. ADAMS STREET
ADAM STREET
LINE "A"
(PLAN AND PROFILE
SEE SHEET C-16)
LINE "B"
(PLAN AND PROFILE
SEE SHEET C-17)
LINE "L"
(PLAN AND PROFILE
SEE SHEET C-28 & C-29)
MATCH LINE
SEE SHEET C-07
MATCH LINE
SEE SHEET C-10
PROVIDE LATERAL STUB
FOR THIS PROPERTY
HOUSE
DEMOLISHED.
INSTALL LATERAL
STUB TO
PROPERTY LINE
24"-PVC
12"-VCP
8"-VCP
12"-Slipline
8"-PVC
Existing 6" pipe
Existing 4"
Existing 6"
New 6" to manhole
Existing 6" together
6" Clean out only
14' to main (nearest pt. of the end of lateral)
MH# 99D - disconnected 6" PVC steam line & Rerouted around manhole
To 312 Franklin
Replaced approx. 30' from the main into the yard
Relocate sewage flow into 238
Existing 6" pipe
Existing 6"
Existing 6"
Existing 6"