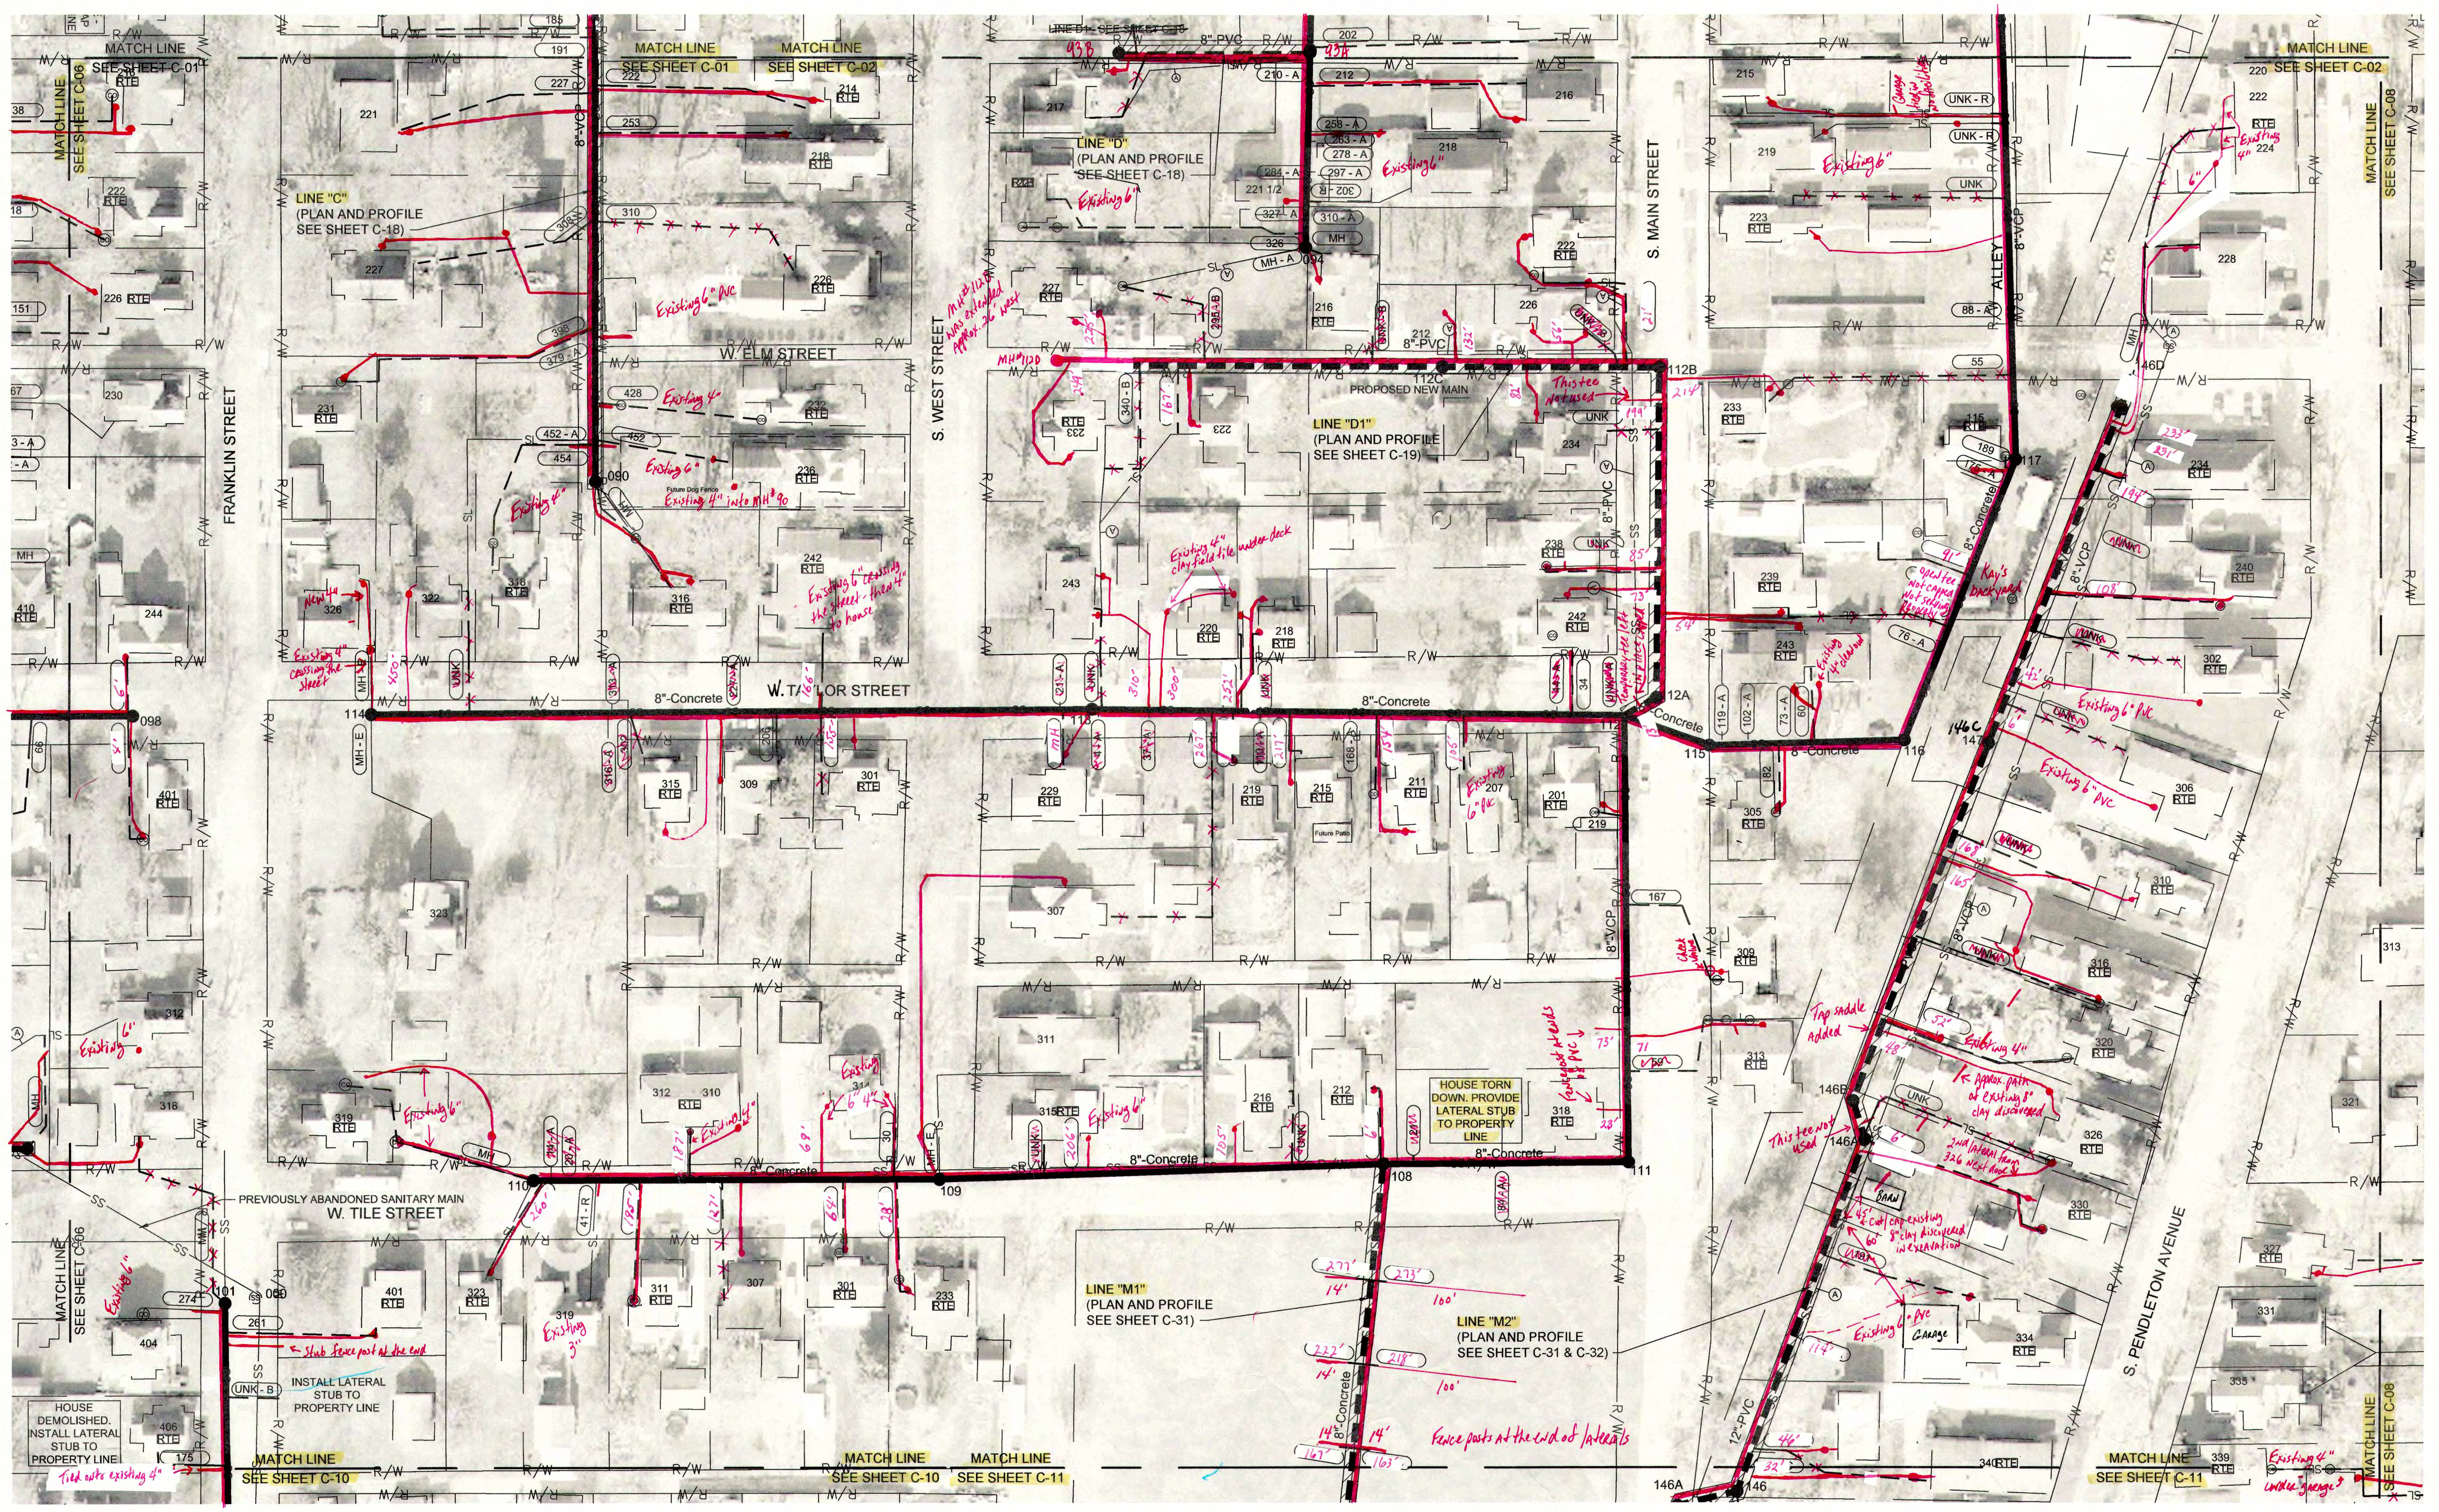
MATCH LINE SEE SHEET C-01
MATCH LINE SEE SHEET C-02
MATCH LINE SEE SHEET C-06
MATCH LINE SEE SHEET C-08
MATCH LINE SEE SHEET C-10
MATCH LINE SEE SHEET C-11
LINE "C" (PLAN AND PROFILE SEE SHEET C-18)
LINE "D" (PLAN AND PROFILE SEE SHEET C-18)
LINE "D1" (PLAN AND PROFILE SEE SHEET C-19)
LINE "M1" (PLAN AND PROFILE SEE SHEET C-31)
LINE "M2" (PLAN AND PROFILE SEE SHEET C-31 & C-32)
PROPOSED NEW MAIN
FRANKLIN STREET
W. ELM STREET
S. WEST STREET
S. MAIN STREET
W. TAYLOR STREET
W. TILE STREET
ALLEY
S. PENDLETON AVENUE
8"-VCP
8"-PVC
8"-Concrete
12"-PVC
R/W
PREVIOUSLY ABANDONED SANITARY MAIN
HOUSE TORN DOWN. PROVIDE LATERAL STUB TO PROPERTY LINE
INSTALL LATERAL STUB TO PROPERTY LINE
HOUSE DEMOLISHED. INSTALL LATERAL STUB TO PROPERTY LINE
Future Patio
Future Dog Fence
Existing 6"
Existing 4"
Existing 6" PVC
Existing 4" into MH 90
Existing 4" clay tile under deck
MH 1120 MH extended approx. 20' west
This tee not used
Tap saddle added
Approx. path of existing 8" clay discovered
Existing 6" PVC garage
Existing 4" under garage
Fence posts at the end of laterals
Stub fence post at the curb
Tied onto existing 4"
Kay's backyard
Check valve
MH
RTE
UNK
090
098
101
108
109
110
111
112
112A
112B
112C
114
115
116
117
146
146A
146B
146C
146D

PRINTED: 3/11/2017 @ 2:20PM

FILE NAME: G:\4447-FCRWD-2015\Working Drawings\AutoCAD\REHABILITATION PHASE II\4447-24-C-07.dwg

NOTES:

1. ALL LATERALS AND TAP LOCATIONS ARE BASED ON BEST INFORMATION AVAILABLE. CONTRACTOR SHALL FIELD VERIFY LOCATIONS OF LATERAL CONNECTIONS AND WHETHER LATERAL PIPES ARE ACTIVE OR ABANDONED BEFORE RECONNECTING OR ABANDONING THE CONNECTIONS.
2. UTILITY LOCATIONS ARE NOT SHOWN FOR LATERAL REPLACEMENT WORK. CONTRACTOR IS RESPONSIBLE FOR FIELD LOCATING ALL UTILITIES AND ADJUSTING PROPOSED LATERAL ROUTES AS NEEDED TO AVOID CONFLICTS.
3. FOR LATERAL REPLACEMENTS, CONTRACTOR SHALL FIRST VERIFY LOCATION OF EXISTING LATERALS & UTILITIES, THEN MEET WITH DISTRICT, ENGINEER AND PROPERTY OWNER TO DETERMINE ACTUAL ROUTE OF NEW LATERAL TO BE INSTALLED.
4. LATERAL REPLACEMENTS CONNECTING TO MAINS TO BE CIPP LINED MUST BE COMPLETED AFTER CIPP LINER IS IN PLACE SO THAT SADDLE CAN CONNECT DIRECTLY TO CIPP.

—SS— XX"	EXISTING SANITARY SEWER MAIN
(SS) MANHOLE NUMBER → #	EXISTING SANITARY SEWER MANHOLE
▬▬▬	SANITARY SEWER MAIN TO BE CIPP LINED
▨	SANITARY SEWER MAIN TO DIG AND REPLACED (SEE PLAN & PROFILE SHEETS)
●	SANITARY MANHOLE TO BE REPLACED OR REHABILITATED (SEE SCHEDULE ON SHEET C-43)
RTE	RIGHT TO ENTER DOCUMENT SIGNED BY PROPERTY OWNER
(P)	PLUMBING IN HOME TO BE RE-ROUTED BY DISTRICT
(A)	EXISTING PIPE SEGMENT TO BE ABANDONED
—SL—	EXISTING SANITARY SEWER LATERAL
(CO)	EXISTING SANITARY SEWER CLEANOUT
▬ ▬ ▬	SANITARY LATERAL REPLACEMENT
UNK	DISTANCE UNKNOWN
MH	EXISTING LATERAL TO BE CONNECTED TO EXISTING MANHOLE
xxx	EXISTING TAP LOCATION TO BE RECONNECTED - DISTANCE FROM MANHOLE
xxx - A	EXISTING TAP LOCATION TO BE ABANDONED
xxx - B	NEW TAP LOCATION TO BE ESTABLISHED
xxx - C	EXISTING TAP LOCATION TO BE DUG UP AND CAPPED/PLUGGED
xxx - E	EXISTING LATERAL CONNECTION - NO WORK NEEDED
xxx - R	DIG UP AND RECONNECT EXISTING PVC LATERAL TO CIPP LINED MAIN

NOTE:
SOURCE OF 2015 AERIAL IMAGERY IS FROM MADISON COUNTY GIS.

N

0' 50' 100'

SCALE: 1" = 50'

JOSEPH P. TIERNEY
REGISTERED No. 19300407
STATE OF INDIANA
PROFESSIONAL ENGINEER

Joseph P. Tierney

GRW PROJECT NO. 4447-24

SRF NO. WW16074803

ALL RIGHTS RESERVED: THIS DOCUMENT IS THE PROPERTY OF GRW ENGINEERS, INC. AND SHALL NOT BE REPRODUCED IN WHOLE OR IN PART OR USED FOR CONSTRUCTION OF OTHER THAN THIS SPECIFIC PROJECT WITHOUT WRITTEN PERMISSION

engineering | architecture | geospatial
www.grwinc.com

SANITARY SEWER REHABILITATION PLAN

SEWER REHABILITATION PROJECT PHASE II
TOWN OF PENDLETON, INDIANA

REVISIONS

NO.	DESCRIPTION	DATE	BY
----		----	----

DESIGNED: GWL
DRAWN: GCR
REVIEWED: GWL
APPROVED: JPT

SCALE CHECK: THIS MARK SHOULD MEASURE EXACTLY 1" WHEN PLOTTED

DATE: MARCH 2017
SCALE: 1"=50'
SHEET NO. C-07