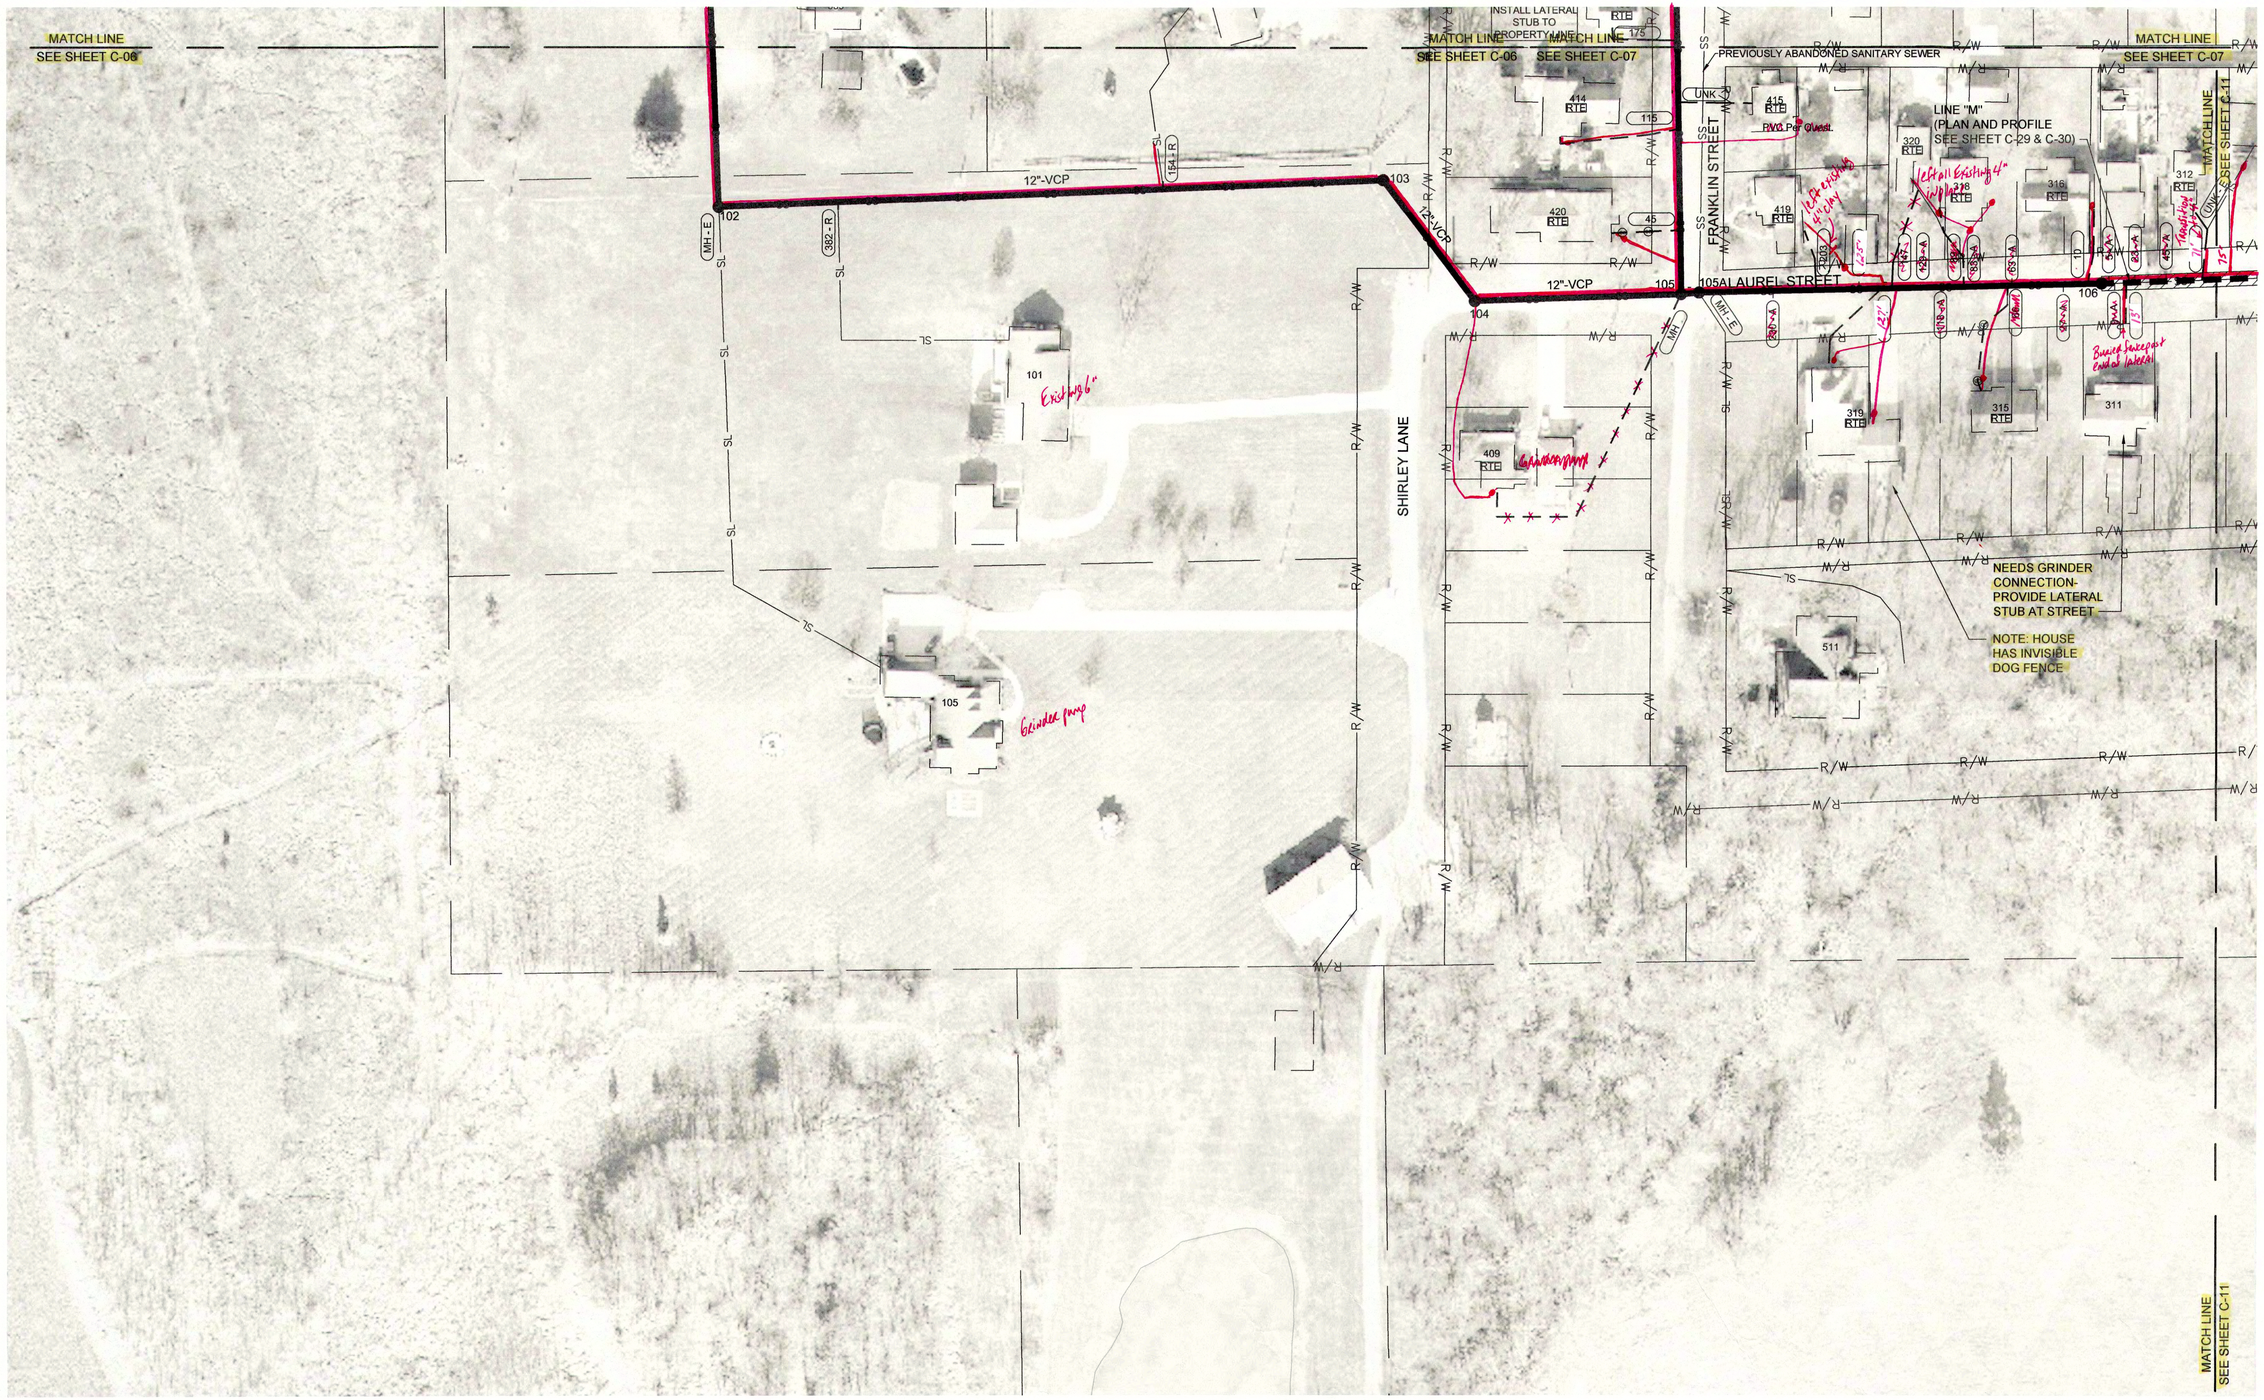
MATCH LINE
SEE SHEET C-06
MATCH LINE
SEE SHEET C-06
MATCH LINE
SEE SHEET C-07
MATCH LINE
SEE SHEET C-07
INSTALL LATERAL STUB TO PROPERTY LINE
PREVIOUSLY ABANDONED SANITARY SEWER
LINE "M"
(PLAN AND PROFILE
SEE SHEET C-29 & C-30)
MATCH LINE
SEE SHEET C-11
12"-VCP
12"-VCP
12"-VCP
SHIRLEY LANE
FRANKLIN STREET
105AL AUREL STREET
101
102
103
104
105
106
Existing 6"
Grinder pump
Remove existing 4" Wye
Install Existing 4"
Install 4" Tee
Install 4" Wye
Remove existing 4" Wye