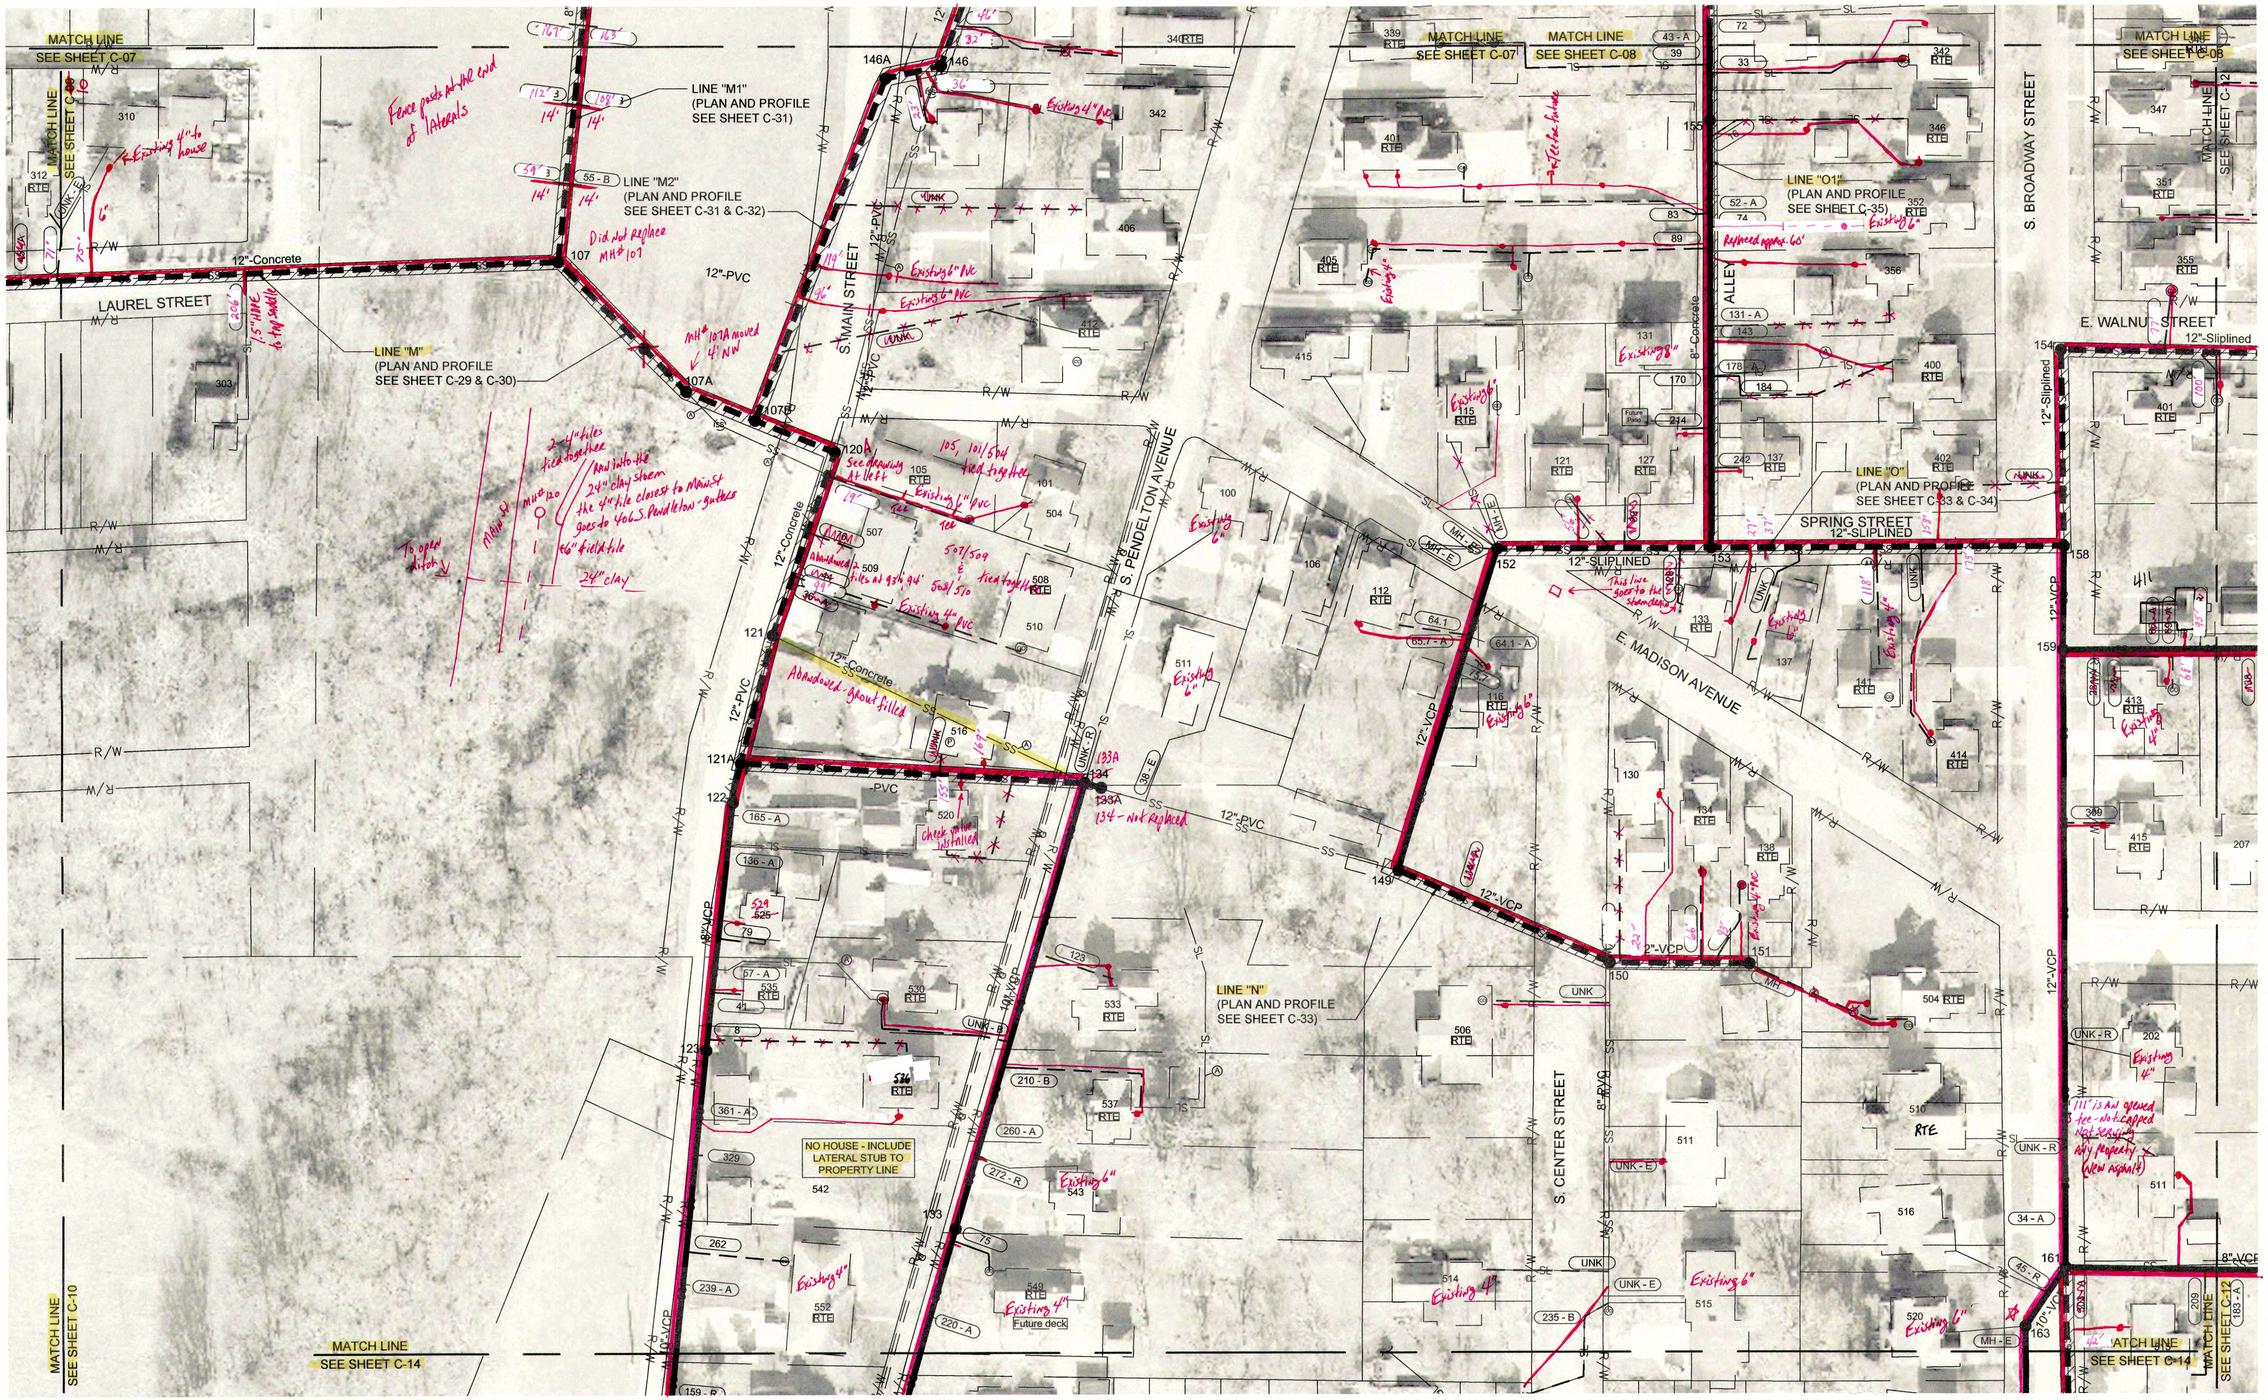
MATCH LINE SEE SHEET C-07
MATCH LINE SEE SHEET C-08
MATCH LINE SEE SHEET C-10
MATCH LINE SEE SHEET C-12
MATCH LINE SEE SHEET C-14
LAUREL STREET
S. MAIN STREET
S. PENDLETON AVENUE
S. CENTER STREET
S. BROADWAY STREET
E. MADISON AVENUE
E. WALNUT STREET
ALLEY
SPRING STREET
LINE "M" (PLAN AND PROFILE SEE SHEET C-29 & C-30)
LINE "M1" (PLAN AND PROFILE SEE SHEET C-31)
LINE "M2" (PLAN AND PROFILE SEE SHEET C-31 & C-32)
LINE "N" (PLAN AND PROFILE SEE SHEET C-33)
LINE "O" (PLAN AND PROFILE SEE SHEET C-33 & C-34)
LINE "O1" (PLAN AND PROFILE SEE SHEET C-35)
NO HOUSE - INCLUDE LATERAL STUB TO PROPERTY LINE
12"-Concrete
12"-PVC
12"-VCP
12"-SLIPLINED
12" Sliplined
8"-VCP
8"-Concrete
Fence posts at ROW end of laterals
Existing 4" to house
Existing 6" PVC
Existing 6" VC
Existing 4" PVC
Existing 6"
Existing 4"
Existing 6" VC
Existing 4" VC
Did Not Replace MH# 107
MH# 107A moved 4' NW
105, 101/504 tied together
See drawing at left
5'of1/509 & 508/510 tied together
2-4" tiles tied together
Run into the 24" clay stream the 4" tile closest to MH#120 goes to 406 S. Pendleton - gathers
66" field tile
24" clay
To open ditch
Abandoned - grout filled
Check valve installed
134 - Not Replaced
Existing 6" VC
Existing 4" VC
Existing 6" PVC
Existing 4" PVC
Existing 6" VC
Existing 6"
Existing 4"
Existing 6"
Existing 4"
Existing 6"
Existing 4"