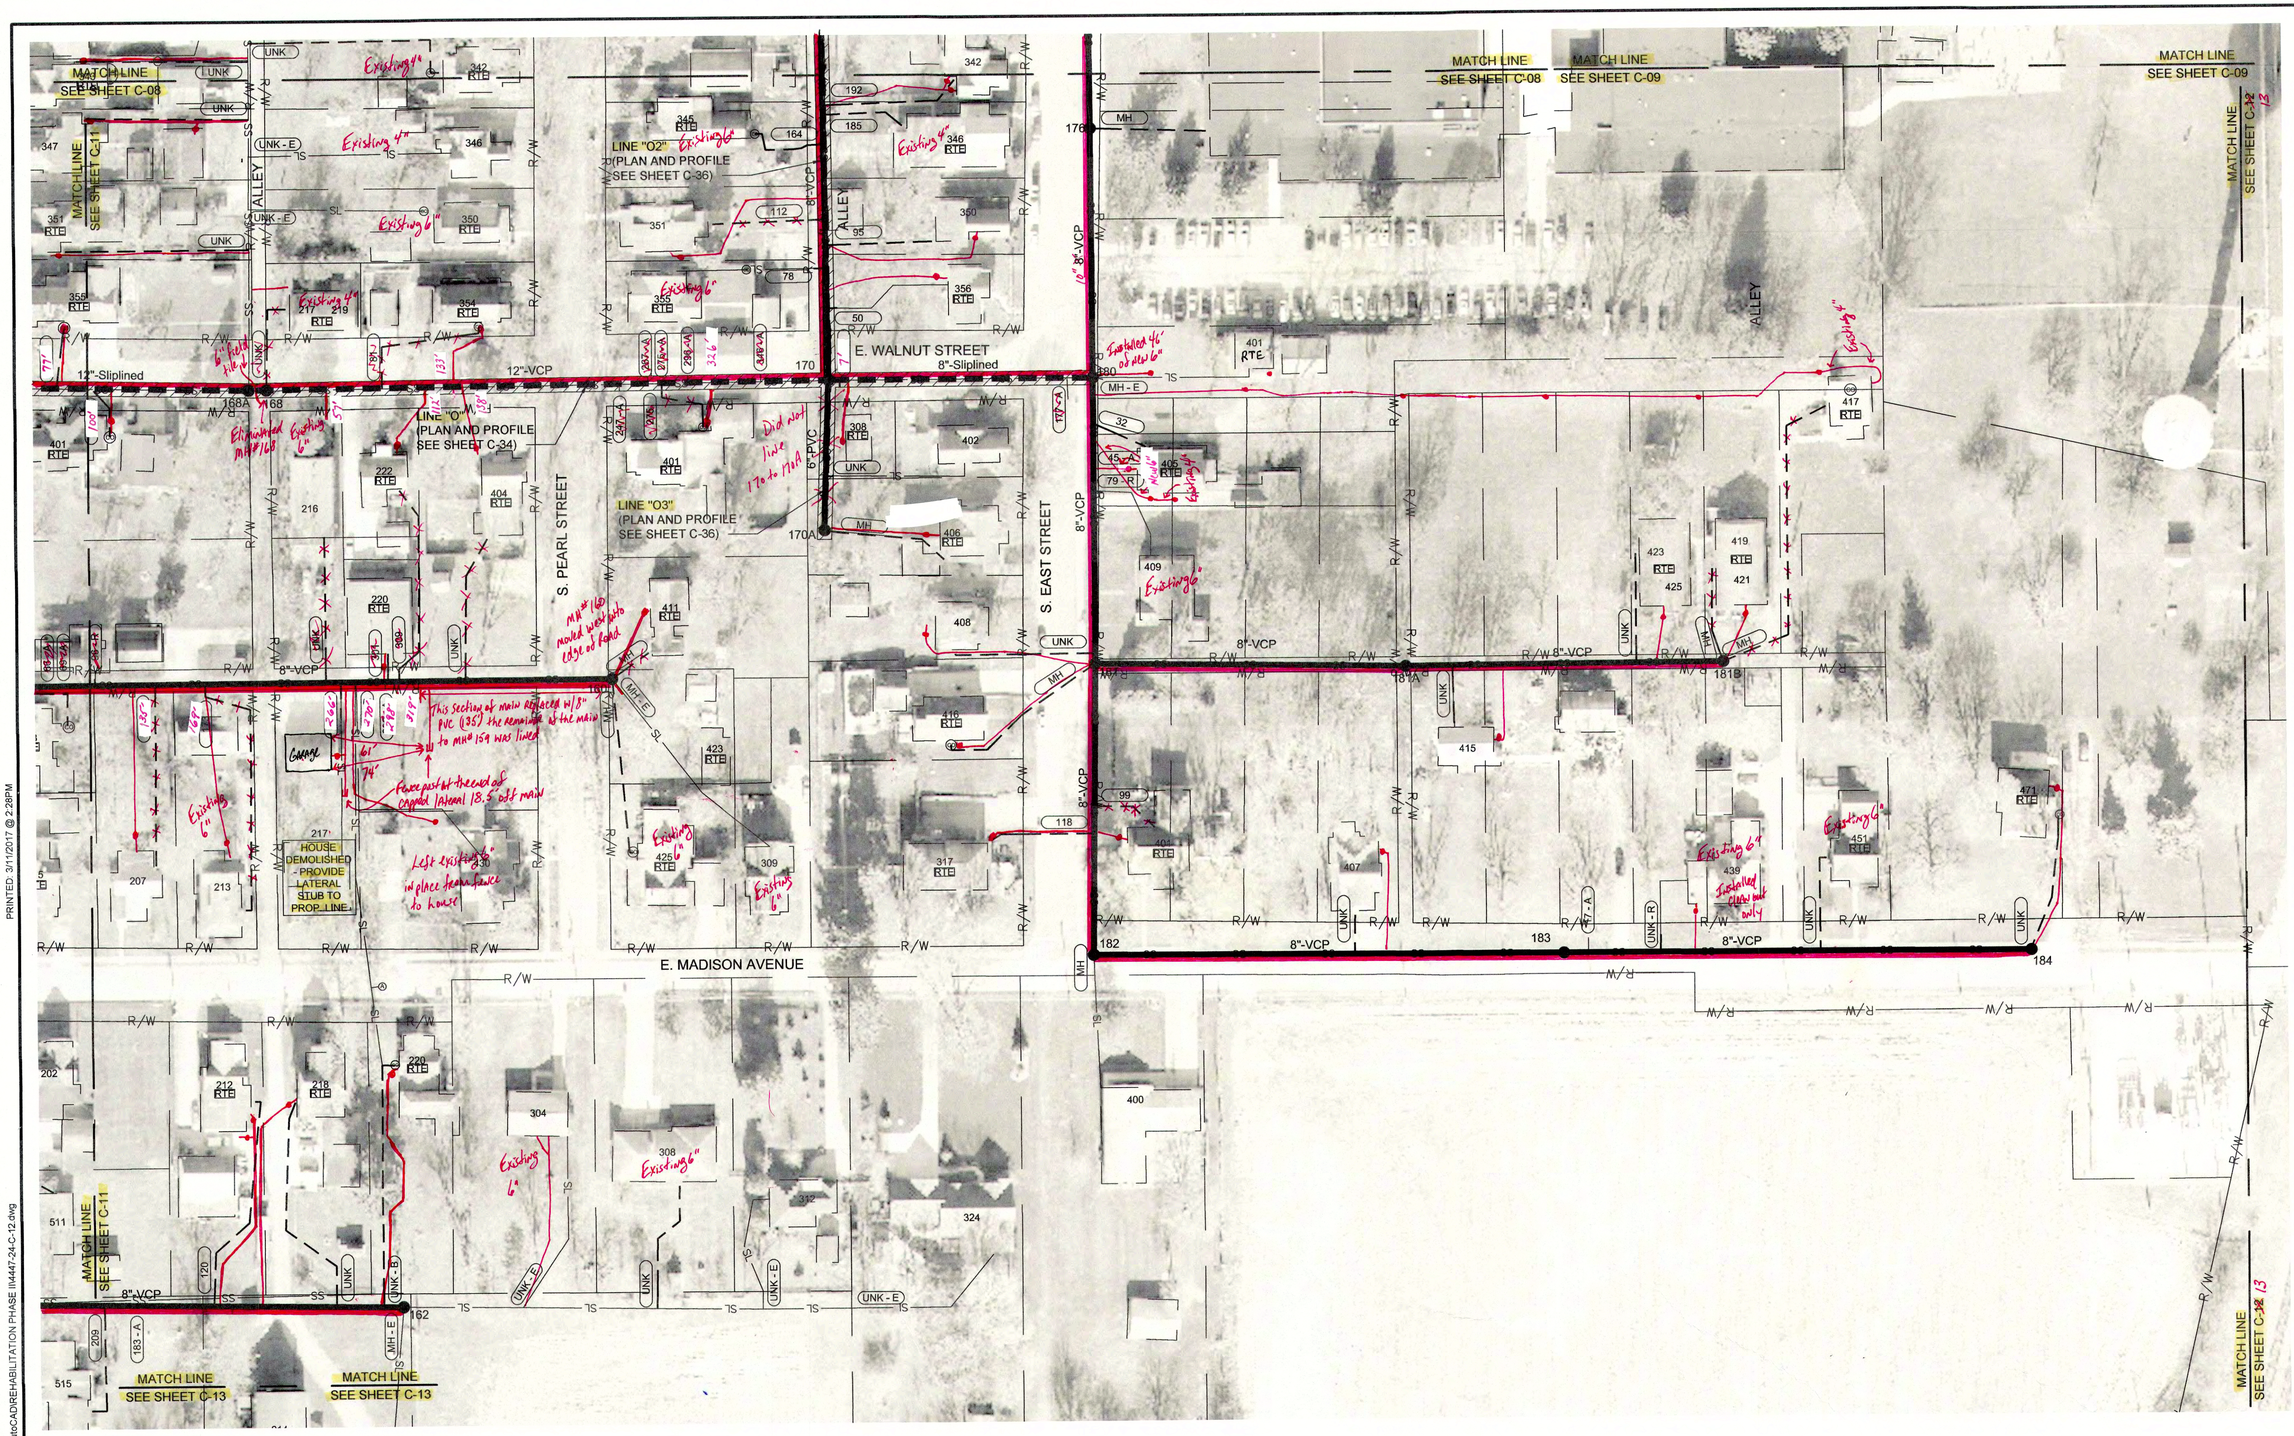
MATCH LINE SEE SHEET C-08
MATCH LINE SEE SHEET C-09
MATCH LINE SEE SHEET C-11
MATCH LINE SEE SHEET C-12
MATCH LINE SEE SHEET C-13
E. WALNUT STREET
8"-Sliplined
E. MADISON AVENUE
S. PEARL STREET
S. EAST STREET
ALLEY
12"-Sliplined
12"-VCP
8"-VCP
8"-PVC
LINE "O" (PLAN AND PROFILE SEE SHEET C-34)
LINE "O2" (PLAN AND PROFILE SEE SHEET C-36)
LINE "O3" (PLAN AND PROFILE SEE SHEET C-36)
HOUSE DEMOLISHED - PROVIDE LATERAL STUB TO PROP. LINE -
Garage
Existing 4"
Existing 6"
Existing 6" field tie
Eliminated MH#168
Existing 6"
Did not line 170 to MH
MH#168 marked broken top edge of board
This section of main replaced w/8" pvc (135') the remainder of the main to mh#159 was lined
Piece past the end of capped lateral 18.5 off main
Left existing 4" in place from piece to house
Installed 46' of new 6"
Existing 4"
Existing 6"
Existing 6"
Existing 6"
Existing 6"
Existing 6"
Existing 6"
Existing 6"
Existing 6"
Installed CIPP liner only
Installed CIPP liner only
Existing 6"
Existing 6"
Existing 6"
Existing 6"
Existing 6"
Existing 6"
Existing 6"
Existing 6"