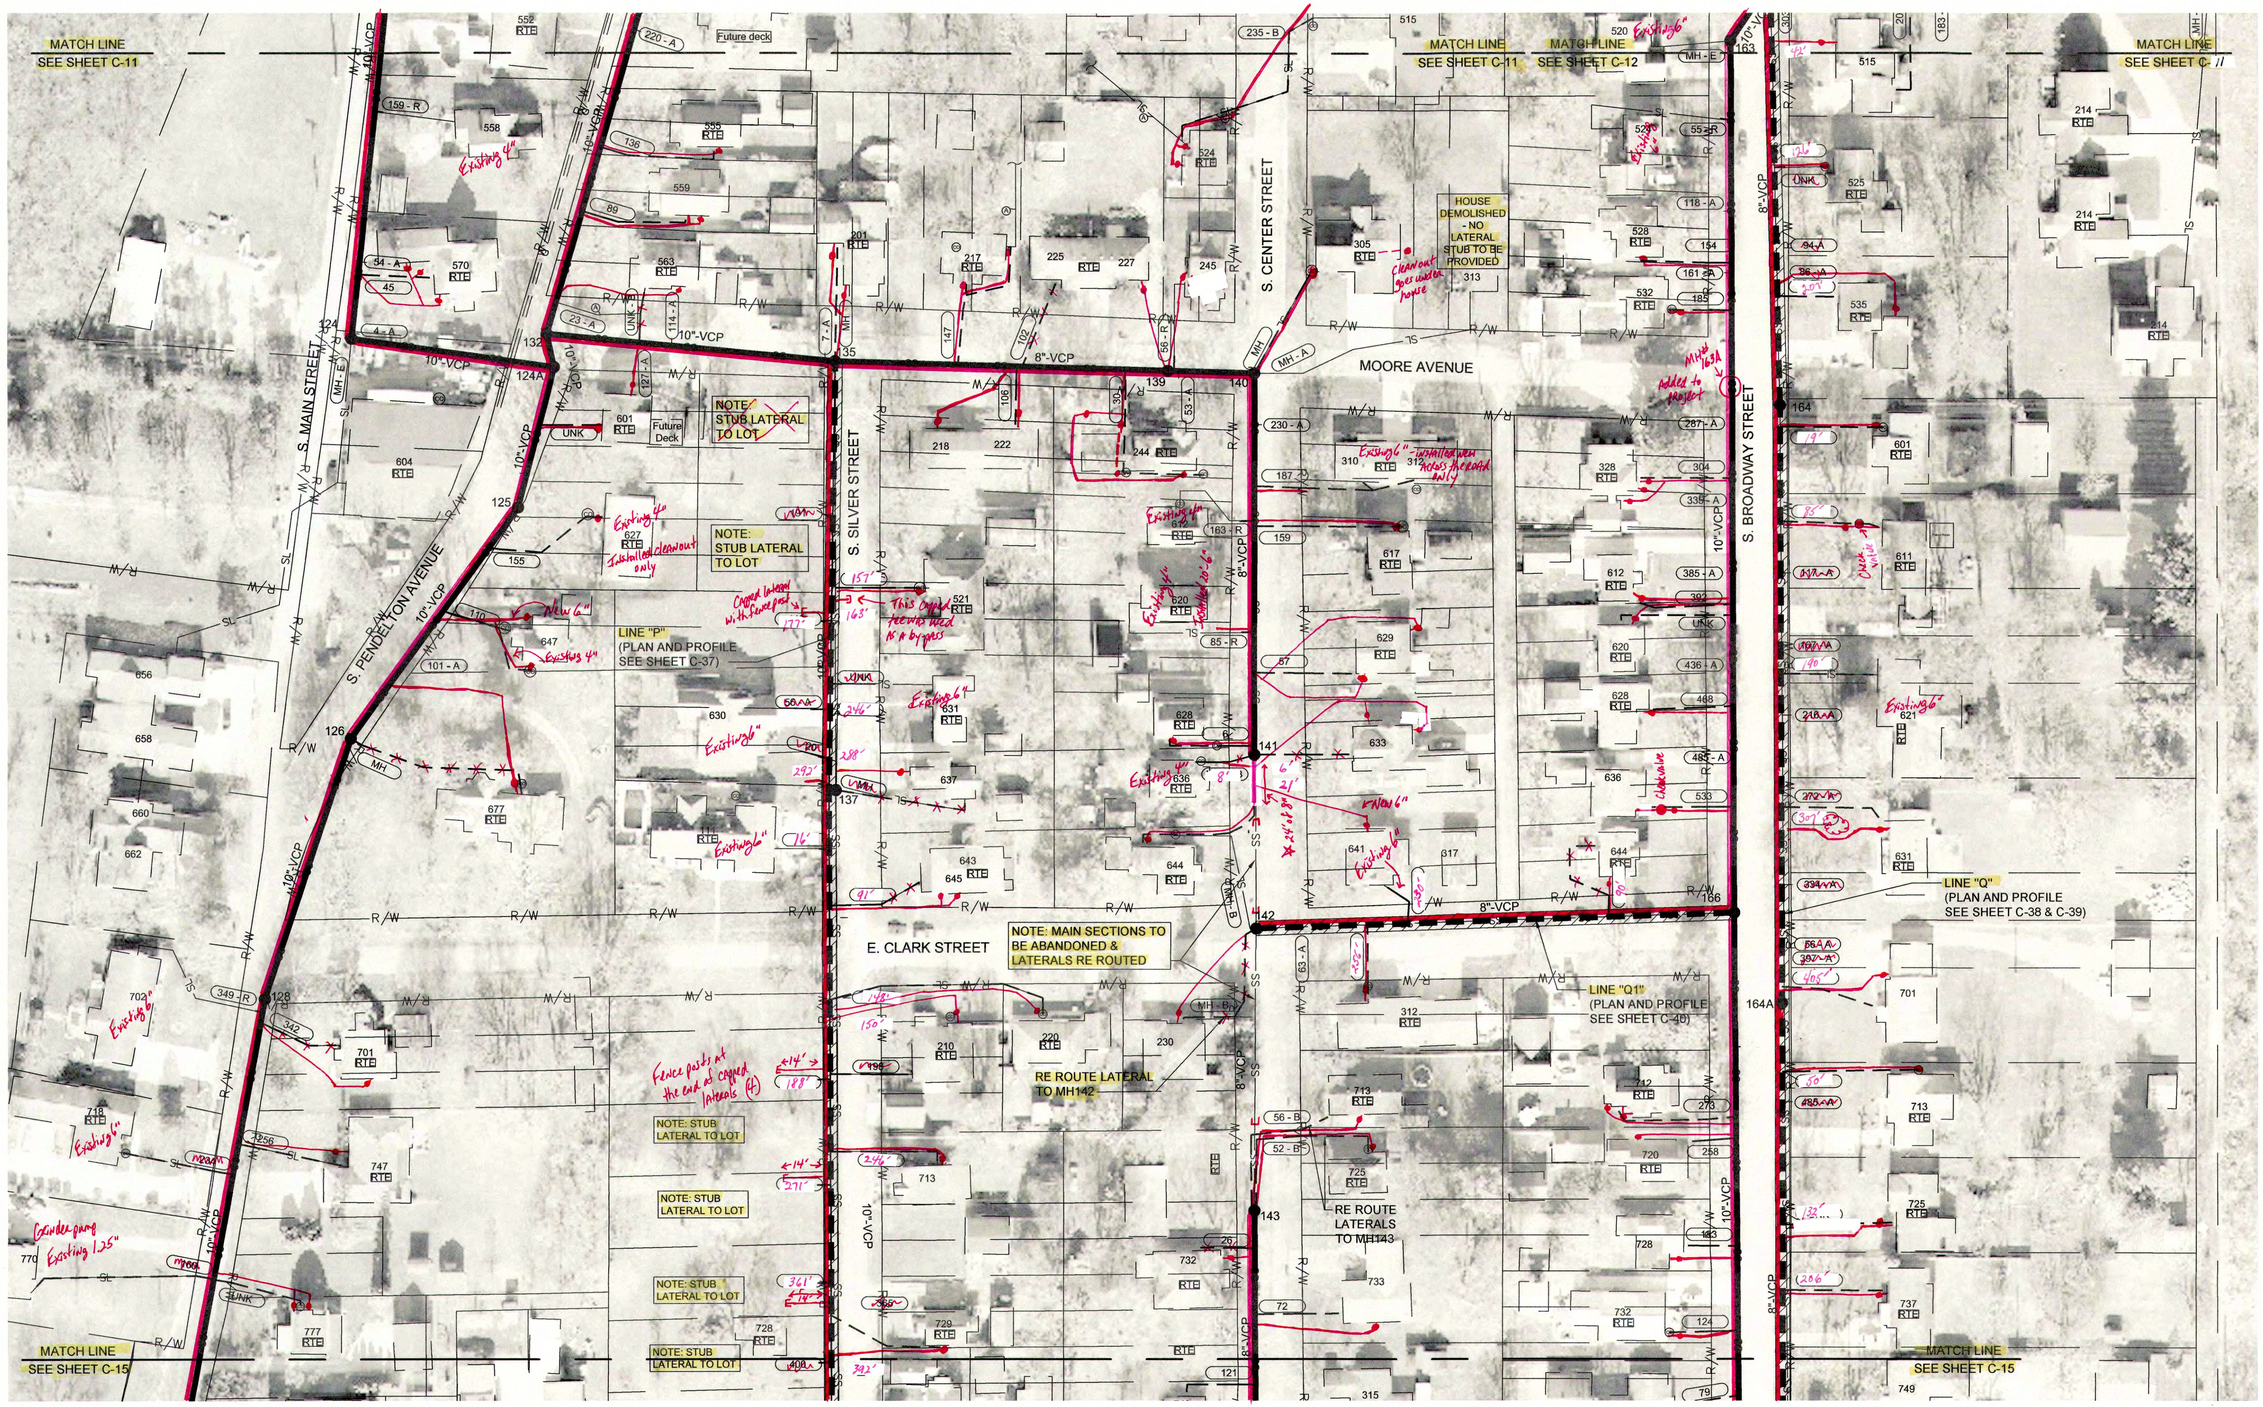

NOTES:

1. ALL LATERALS AND TAP LOCATIONS ARE BASED ON BEST INFORMATION AVAILABLE. CONTRACTOR SHALL FIELD VERIFY LOCATIONS OF LATERAL CONNECTIONS AND WHETHER LATERAL PIPES ARE ACTIVE OR ABANDONED BEFORE RECONNECTING OR ABANDONING THE CONNECTIONS.
2. UTILITY LOCATIONS ARE NOT SHOWN FOR LATERAL REPLACEMENT WORK. CONTRACTOR IS RESPONSIBLE FOR FIELD LOCATING ALL UTILITIES AND ADJUSTING PROPOSED LATERAL ROUTES AS NEEDED TO AVOID CONFLICTS.
3. FOR LATERAL REPLACEMENTS, CONTRACTOR SHALL FIRST VERIFY LOCATION OF EXISTING LATERALS & UTILITIES, THEN MEET WITH DISTRICT, ENGINEER AND PROPERTY OWNER TO DETERMINE ACTUAL ROUTE OF NEW LATERAL TO BE INSTALLED.
4. LATERAL REPLACEMENTS CONNECTING TO MAINS TO BE CIPP LINED MUST BE COMPLETED AFTER CIPP LINER IS IN PLACE SO THAT SADDLE CAN CONNECT DIRECTLY TO CIPP.

SS XX" — EXISTING SANITARY SEWER MAIN
(SS) MANHOLE NUMBER # — EXISTING SANITARY SEWER MANHOLE
SANITARY SEWER MAIN TO BE CIPP LINED
SANITARY SEWER MAIN TO DIG AND REPLACED (SEE PLAN & PROFILE SHEETS)
SANITARY MANHOLE TO BE REPLACED OR REHABILITATED (SEE SCHEDULE ON SHEET C-43)
RTE — RIGHT TO ENTER DOCUMENT SIGNED BY PROPERTY OWNER

(P) — PLUMBING IN HOME TO BE RE-ROUTED BY DISTRICT
(A) — EXISTING PIPE SEGMENT TO BE ABANDONED
SL — EXISTING SANITARY SEWER LATERAL
(CO) — EXISTING SANITARY SEWER CLEANOUT
SANITARY LATERAL REPLACEMENT
UNK — DISTANCE UNKNOWN
MH — EXISTING LATERAL TO BE CONNECTED TO EXISTING MANHOLE

xxx — EXISTING TAP LOCATION TO BE RECONNECTED - DISTANCE FROM MANHOLE
xxx - A — EXISTING TAP LOCATION TO BE ABANDONED
xxx - B — NEW TAP LOCATION TO BE ESTABLISHED
xxx - C — EXISTING TAP LOCATION TO BE DUG UP AND CAPPED/PLUGGED
xxx - E — EXISTING LATERAL CONNECTION - NO WORK NEEDED
xxx - R — DIG UP AND RECONNECT EXISTING PVC LATERAL TO CIPP LINED MAIN

NOTE:
SOURCE OF 2015 AERIAL IMAGERY IS FROM MADISON COUNTY GIS.

0' 50' 100'
SCALE: 1" = 50'

JOSEPH P. TIERNEY
REGISTERED
No. 19300407
STATE OF INDIANA
PROFESSIONAL ENGINEER

GRW PROJECT NO. 4447-24
SRF NO. WW16074803

ALL RIGHTS RESERVED.
THIS DOCUMENT IS THE PROPERTY OF GREAT RIVERS WATER & WASTEWATER AND SHALL NOT BE REPRODUCED IN WHOLE OR IN PART OR BE LOANED OUT FOR USE ON ANY OTHER PROJECT OR BE USED FOR THIS PROJECT WITHOUT WRITTEN PERMISSION.

engineering | architecture | geospatial
www.gwinc.com

SANITARY SEWER REHABILITATION PLAN
SEWER REHABILITATION PROJECT PHASE II
TOWN OF PENDLETON, INDIANA

DESIGNED:	DRAWN:	REVIEWED:	APPROVED:
GWL	GCR	GWL	JPT

REVISIONS

NO.	DESCRIPTION	DATE	BY
---	---	---	---

THIS MARK SHOULD MEASURE EXACTLY 1" WHEN PLOTTED
SCALE CHECK:

DATE: MARCH 2017
SCALE: 1"=50'
SHEET NO. C-14

PRINTED: 3/11/2017 @ 2:31PM
FILE NAME: G:\4447-FCRWD-2015\Working Drawings\AutoCAD\REHABILITATION PHASE II\4447-24-C-14.dwg