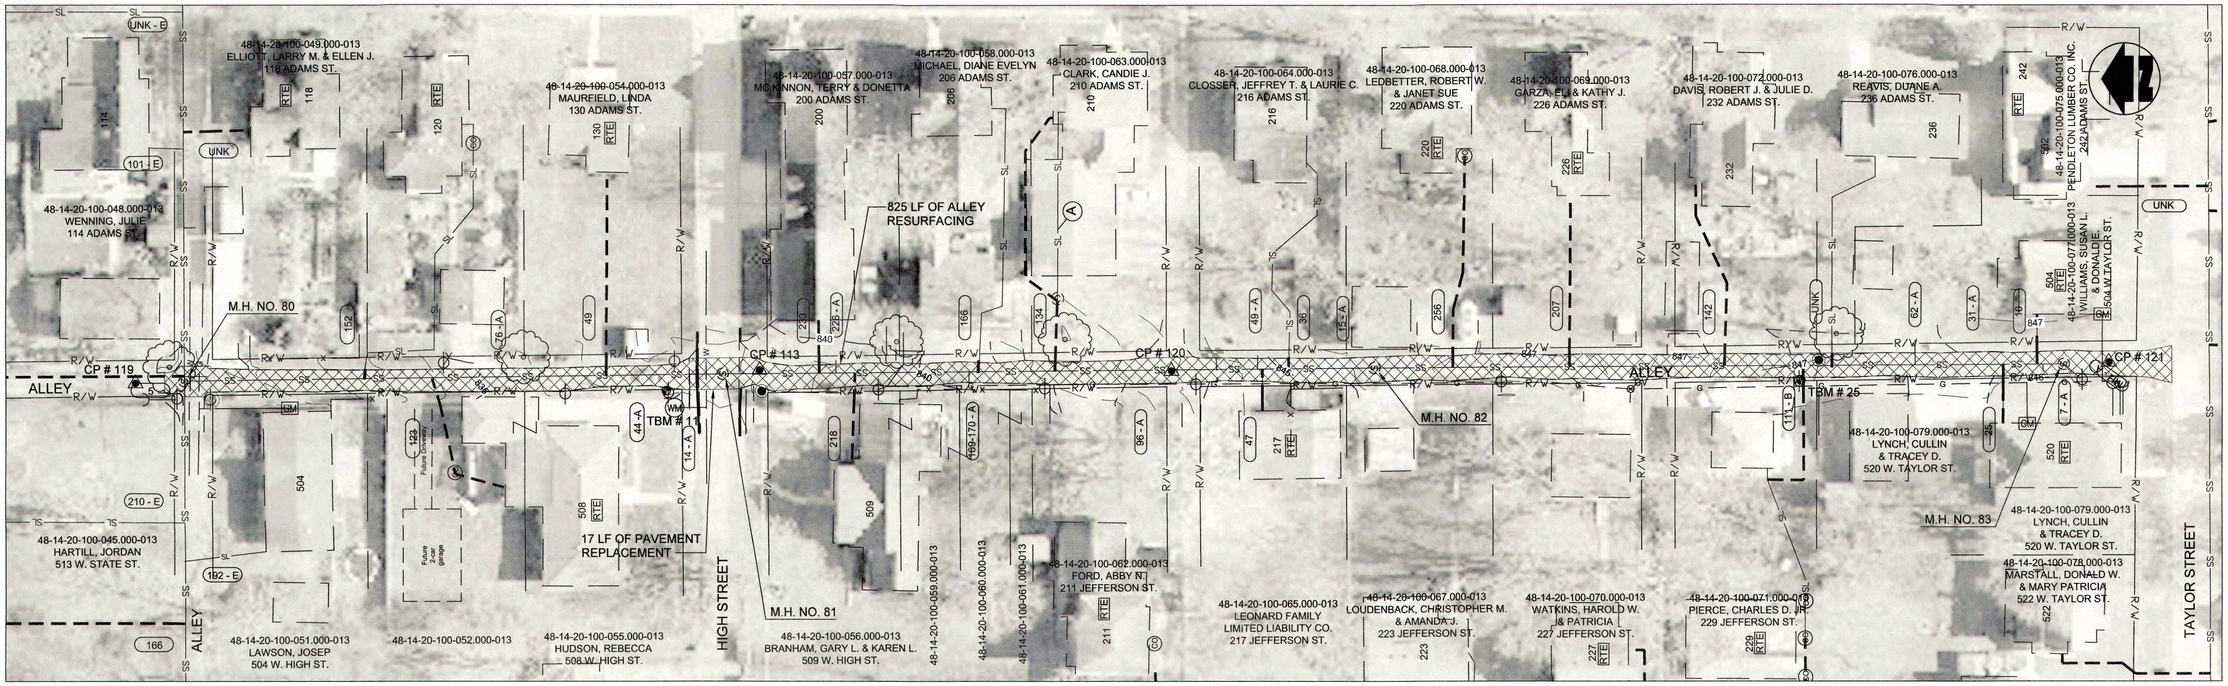

PLAN VIEW - STA. 0+00 TO STA. 8+05 LINE "A" CIPP LINED PER BID ALTERNATE

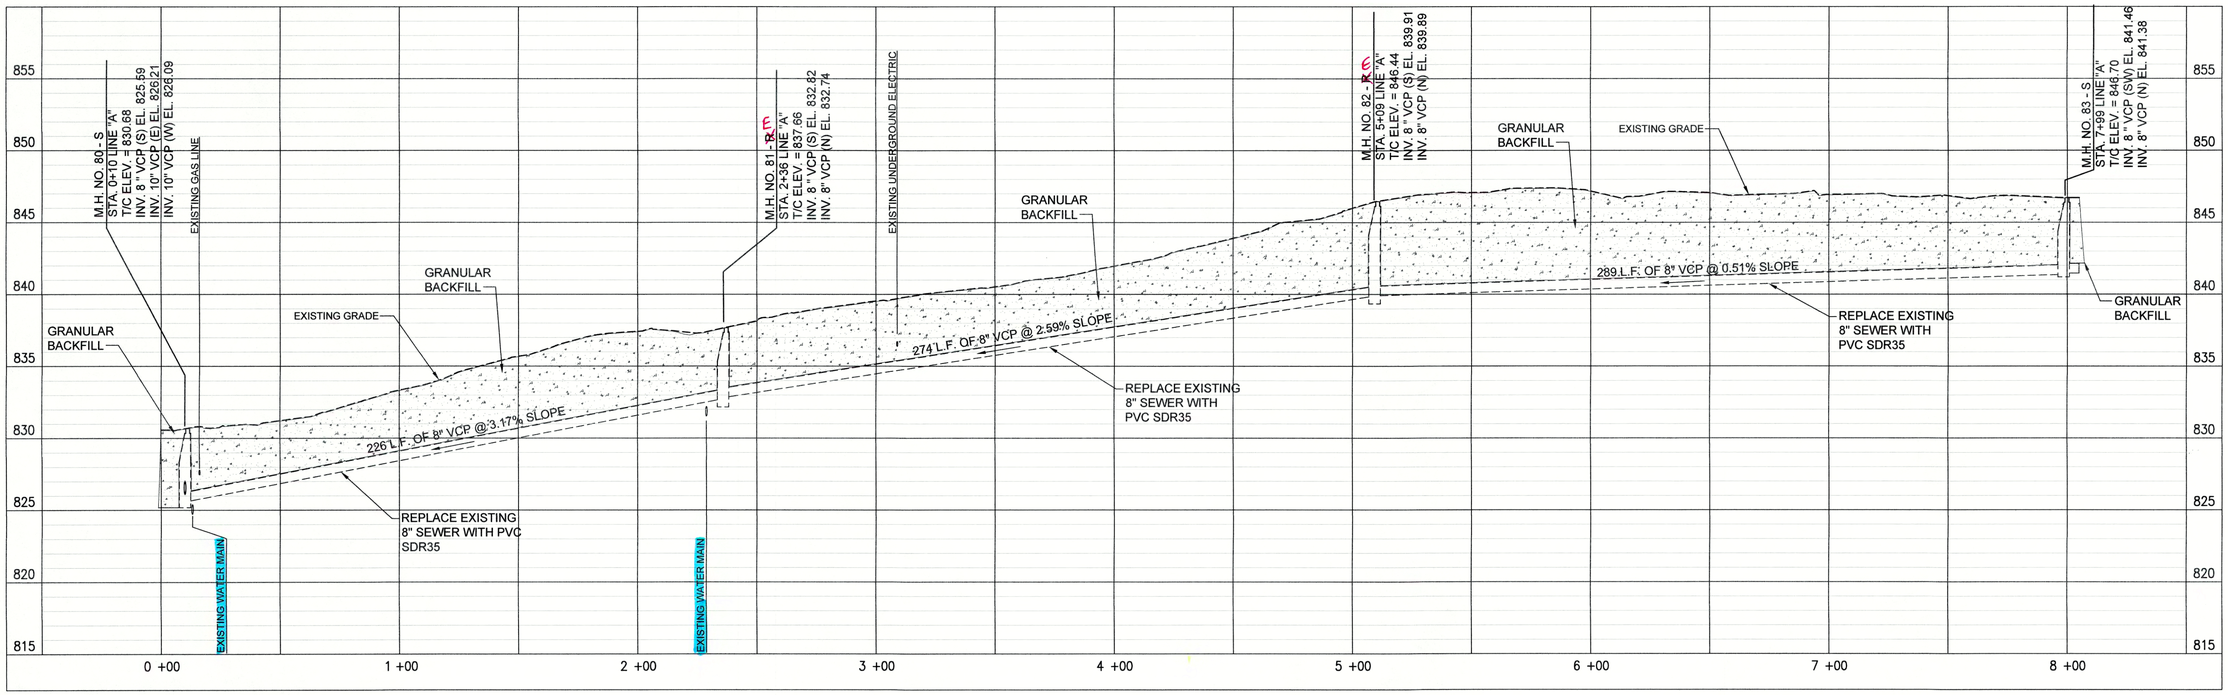

PROFILE - STA. 0+00 TO STA. 8+05 LINE "A"

(A) PIPE SEGMENT TO BE ABANDONED

NOTES:
1. LETTERS SHOWN NEXT TO MANHOLE NUMBERS IN THE PROFILE CORRESPOND TO REHABILITATION SCHEDULE ON SHEET C-42.
2. SEE SHEETS C-01 THROUGH C-15 FOR NOTES ON LATERAL REHABILITATION WORK.

PROPOSED LEGEND

- PROPOSED PERMANENT EASEMENT
- PROPOSED RIGHT-OF-WAY
- PROPOSED SANITARY SEWER
- PROPOSED SANITARY LATERAL
- SURFACE RESTORATION AND BACKFILL

SCALE: 1"=30' HORIZONTAL (0, 30, 60)
SCALE: 1"=5' VERTICAL (5, 0)

JOSEPH P. TIERNEY
REGISTERED
No. 19300407
STATE OF INDIANA
PROFESSIONAL ENGINEER

GRW PROJECT NO. 4447-24
SRF NO. WW16074803 --

ALL RIGHTS RESERVED:
THIS DOCUMENT IS THE PROPERTY OF GRW ENGINEERS, INC. AND SHALL NOT BE REPRODUCED IN WHOLE OR IN PART OR USED FOR ANY PURPOSE OTHER THAN THE SPECIFIC PROJECT WITHOUT WRITTEN PERMISSION

GRW
engineering | architecture | geospatial
www.grwinc.com

PLAN AND PROFILE
LINE "A"
SEWER REHABILITATION PROJECT PHASE II
TOWN OF PENDLETON, INDIANA

DESIGNED:	DRAWN:	REVIEWED:	APPROVED:
GWL	GCR	GWL	JPT

REVISIONS

NO.	DESCRIPTION	DATE	BY
---	---	---	---

SCALE CHECK: THIS MARK SHOULD MEASURE EXACTLY 1" WHEN PLOTTED

DATE: MARCH 2017
SCALE: H.-1"=30', V.-1"=5'
SHEET NO. C-16

PRINTED: 3/14/2017 @ 1:25PM
FILE NAME: G:\4447-FCRWD-2015\Working Drawings\AutoCAD\REHABILITATION PHASE II\4447-24-C-16.dwg