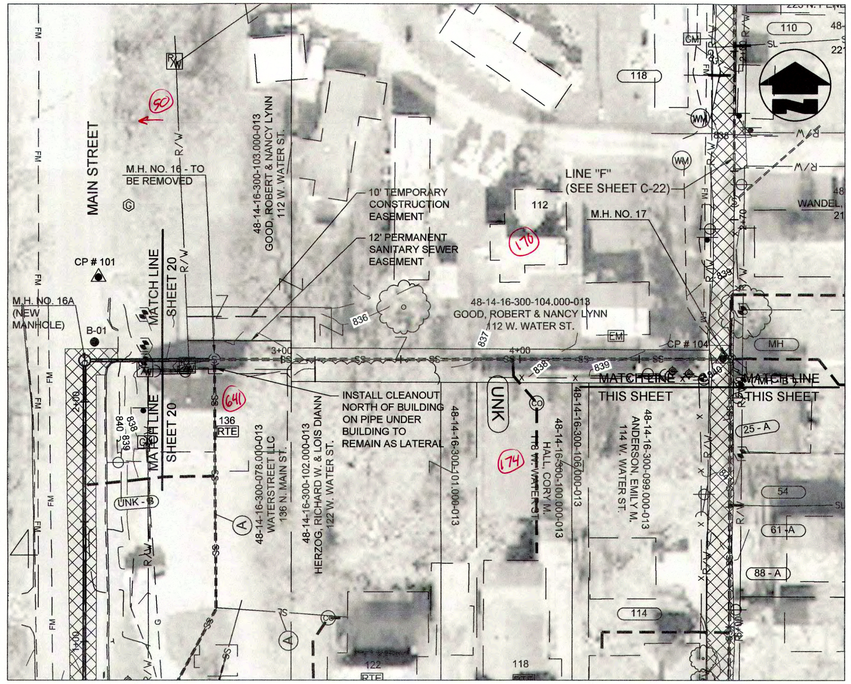

PLAN VIEW - STA. 2+50 TO STA. 5+00 LINE "E"

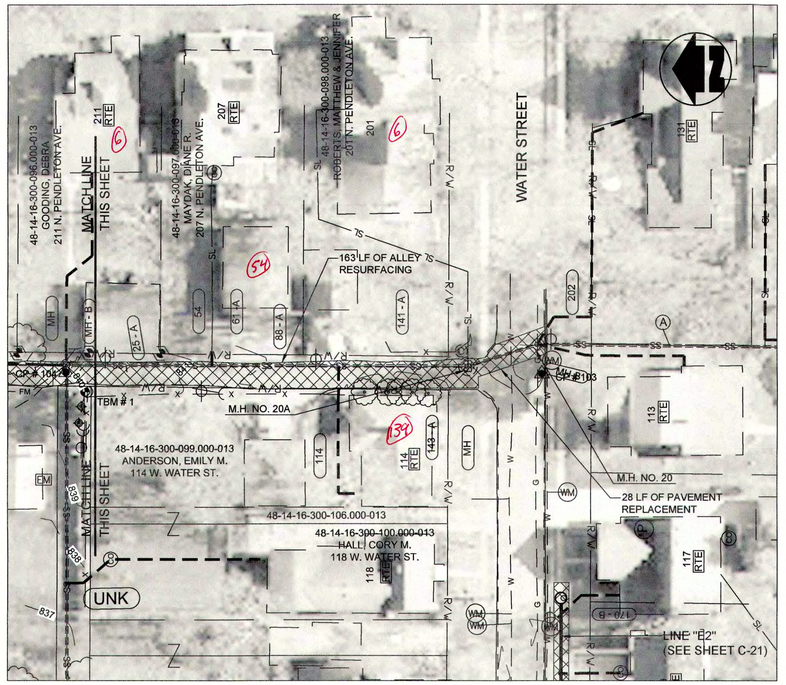

PLAN VIEW - STA. 5+00 TO STA. 7+00 LINE "E"

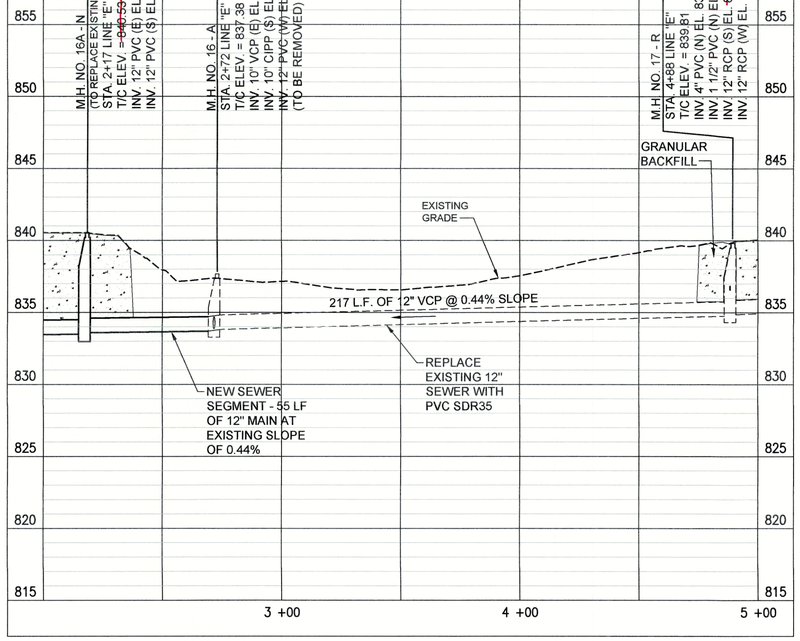

PROFILE - STA. 2+50 TO STA. 5+00 LINE "E"

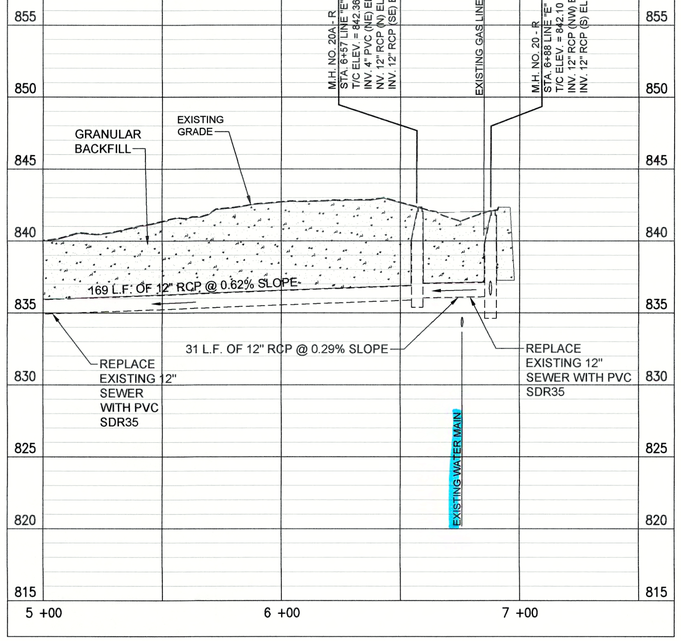

PROFILE - STA. 5+00 TO STA. 7+00 LINE "E"

(A) PIPE SEGMENT TO BE ABANDONED

NOTES:
1. LETTERS SHOWN NEXT TO MANHOLE NUMBERS IN THE PROFILE CORRESPOND TO REHABILITATION SCHEDULE ON SHEET C-42.
2. SEE SHEETS C-01 THROUGH C-15 FOR NOTES ON LATERAL REHABILITATION WORK.

PROPOSED LEGEND

- PROPOSED PERMANENT EASEMENT
- PROPOSED RIGHT-OF-WAY
- PROPOSED SANITARY SEWER
- PROPOSED SANITARY LATERAL
- SURFACE RESTORATION AND BACKFILL

SCALE: 1"=30' HORIZONTAL

SCALE: 1"=5' VERTICAL

JOSEPH P. TIERNEY REGISTERED No. 19300407 STATE OF INDIANA PROFESSIONAL ENGINEER

GRW PROJECT NO. 4447-24

SRF NO. WW160748O3 --

ALL RIGHTS RESERVED
THIS DOCUMENT IS THE PROPERTY OF GRW ENGINEERS, INC. AND SHALL NOT BE REPRODUCED OR TRANSMITTED IN PART OR USED FOR CONSTRUCTION OF ANY PROJECT WITHOUT WRITTEN PERMISSION

engineering | architecture | geospatial
www.gwinc.com

PLAN AND PROFILE
LINE "E"
SEWER REHABILITATION PROJECT PHASE II
TOWN OF PENDLETON, INDIANA

DESIGNED:	DRAWN:	REVIEWED:	APPROVED:
GWL	GCR	GWL	JPT

REVISIONS

NO.	DESCRIPTION	DATE	BY
----	----	----	----

SCALE CHECK: THIS MARK SHOULD MEASURE EXACTLY 1" WHEN PLOTTED

DATE: MARCH 2017

SCALE: H.-1"=30', V.-1"=5'

SHEET NO. C-21

PRINTED: 3/11/2017 @ 2:51PM

FILE NAME: G:\4447-FCRWD-2015\Working Drawings\AutoCAD\REHABILITATION PHASE II\4447-24-C-21.dwg