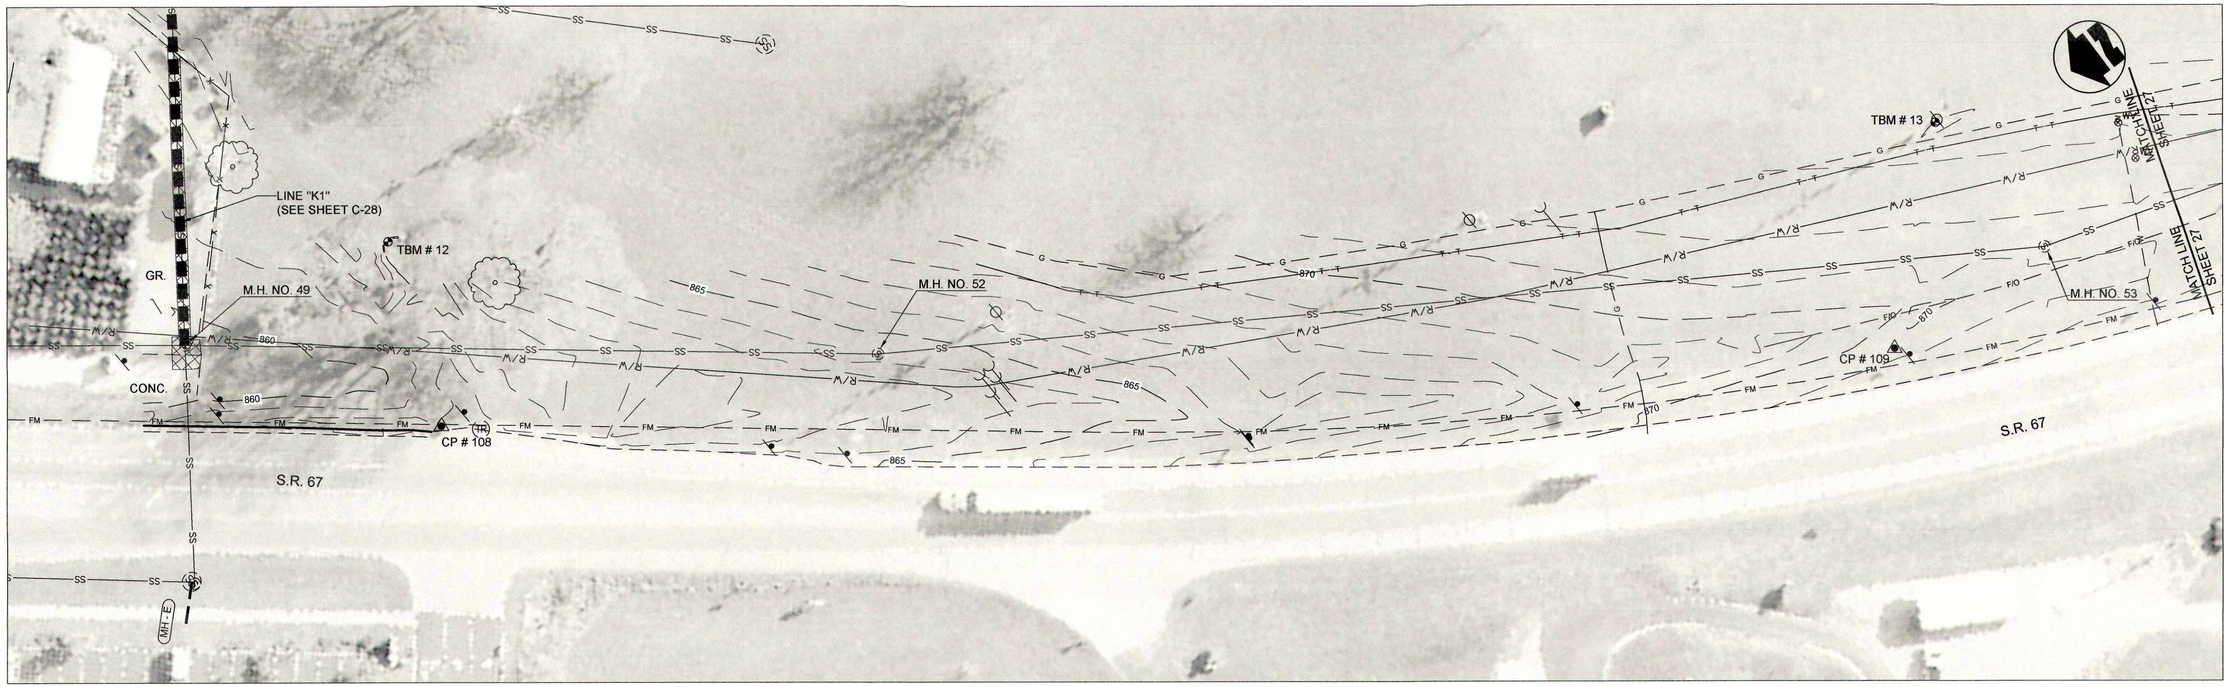

PLAN VIEW - STA. 0+00 TO STA. 8+50 LINE "K"

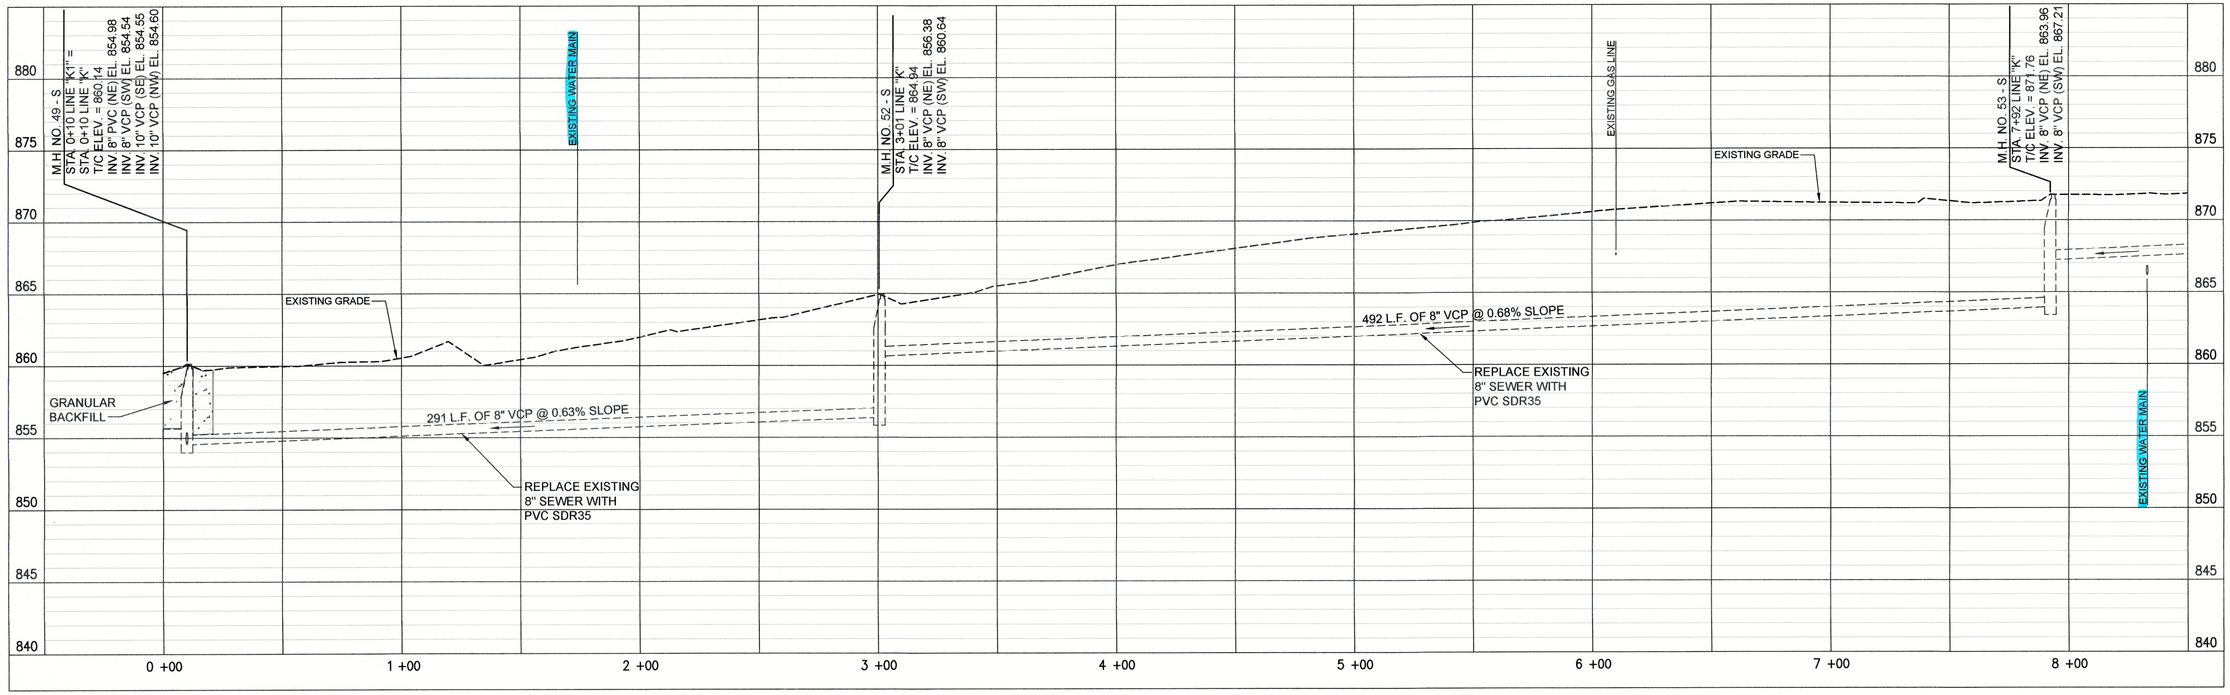

PROFILE - STA. 0+00 TO STA. 8+50 LINE "K"

(A) PIPE SEGMENT TO BE ABANDONED

NOTES:
1. LETTERS SHOWN NEXT TO MANHOLE NUMBERS IN THE PROFILE CORRESPOND TO REHABILITATION SCHEDULE ON SHEET C-42.
2. SEE SHEETS C-01 THROUGH C-15 FOR NOTES ON LATERAL REHABILITATION WORK.

PROPOSED LEGEND

- PROPOSED PERMANENT EASEMENT
- PROPOSED RIGHT-OF-WAY
- PROPOSED SANITARY SEWER
- PROPOSED SANITARY LATERAL
- SURFACE RESTORATION AND BACKFILL

SCALE: 1"=30' HORIZONTAL (0, 30, 60)
SCALE: 1"=5' VERTICAL (5, 0)

JOSEPH P. TIERNEY
REGISTERED
No. 19300407
STATE OF INDIANA
PROFESSIONAL ENGINEER

GRW PROJECT NO. 4447-24
SRF NO. WW160748O3 --

ALL RIGHTS RESERVED
THIS DRAWING IS THE PROPERTY OF GRW ENGINEERS, INC. AND SHALL NOT BE REPRODUCED, COPIED OR USED IN PART OR WHOLE OR AS AN INSTRUMENT OF SERVICE FOR ANY PROJECT WITHOUT WRITTEN PERMISSION

engineering | architecture | geospatial
www.grwinc.com

PLAN AND PROFILE
LINE "K"
SEWER REHABILITATION PROJECT PHASE II
TOWN OF PENDLETON, INDIANA

REVISIONS			
NO.	DESCRIPTION	DATE	BY
----	----	----	----

DESIGNED: GWL
DRAWN: GCR
REVIEWED: GWL
APPROVED: JPT

THIS MARK SHOULD MEASURE EXACTLY 1" WHEN PLOTTED
SCALE CHECK

DATE: MARCH 2017
SCALE: H.-1"=30', V.-1"=5'
SHEET NO. C-26

PRINTED: 3/11/2017 @ 3:06PM
FILE NAME: G:\4447-FCRWD-2015\Working Drawings\AutoCAD\REHABILITATION PHASE II\4447-24-C-26.dwg