## PLAN VIEW - STA. 2+50 TO STA. 11+50 LINE "M"

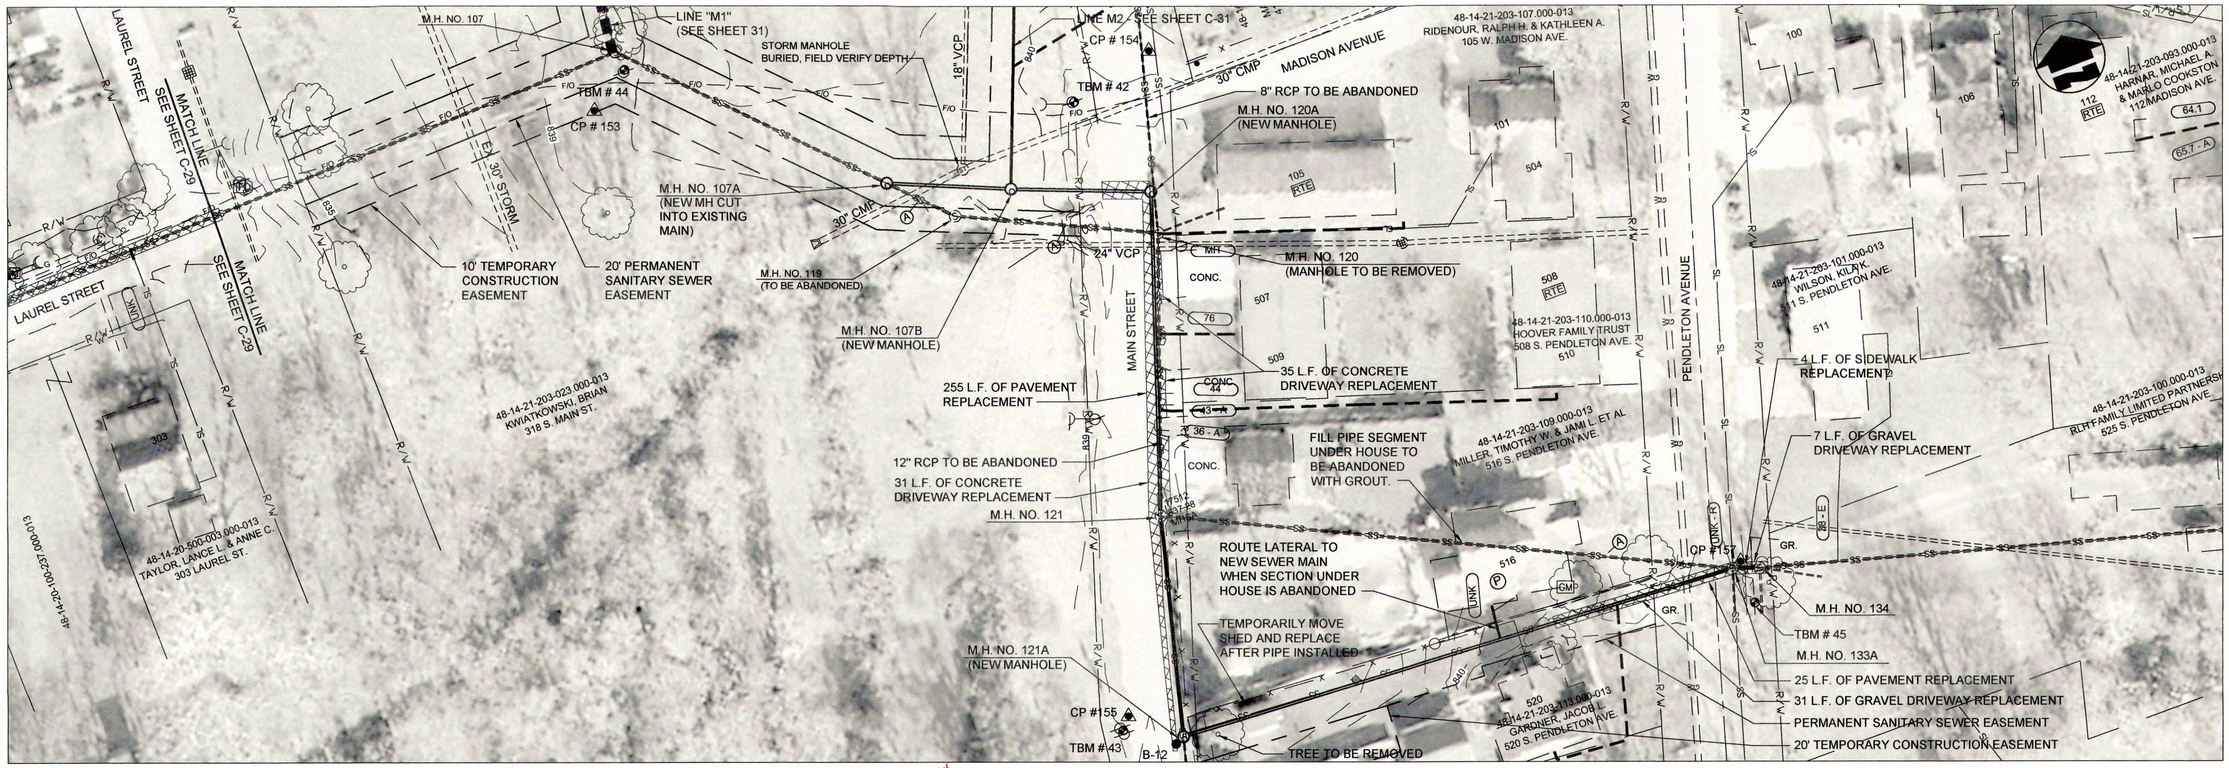


## PROFILE - STA. 2+50 TO STA. 11+50 LINE "M"

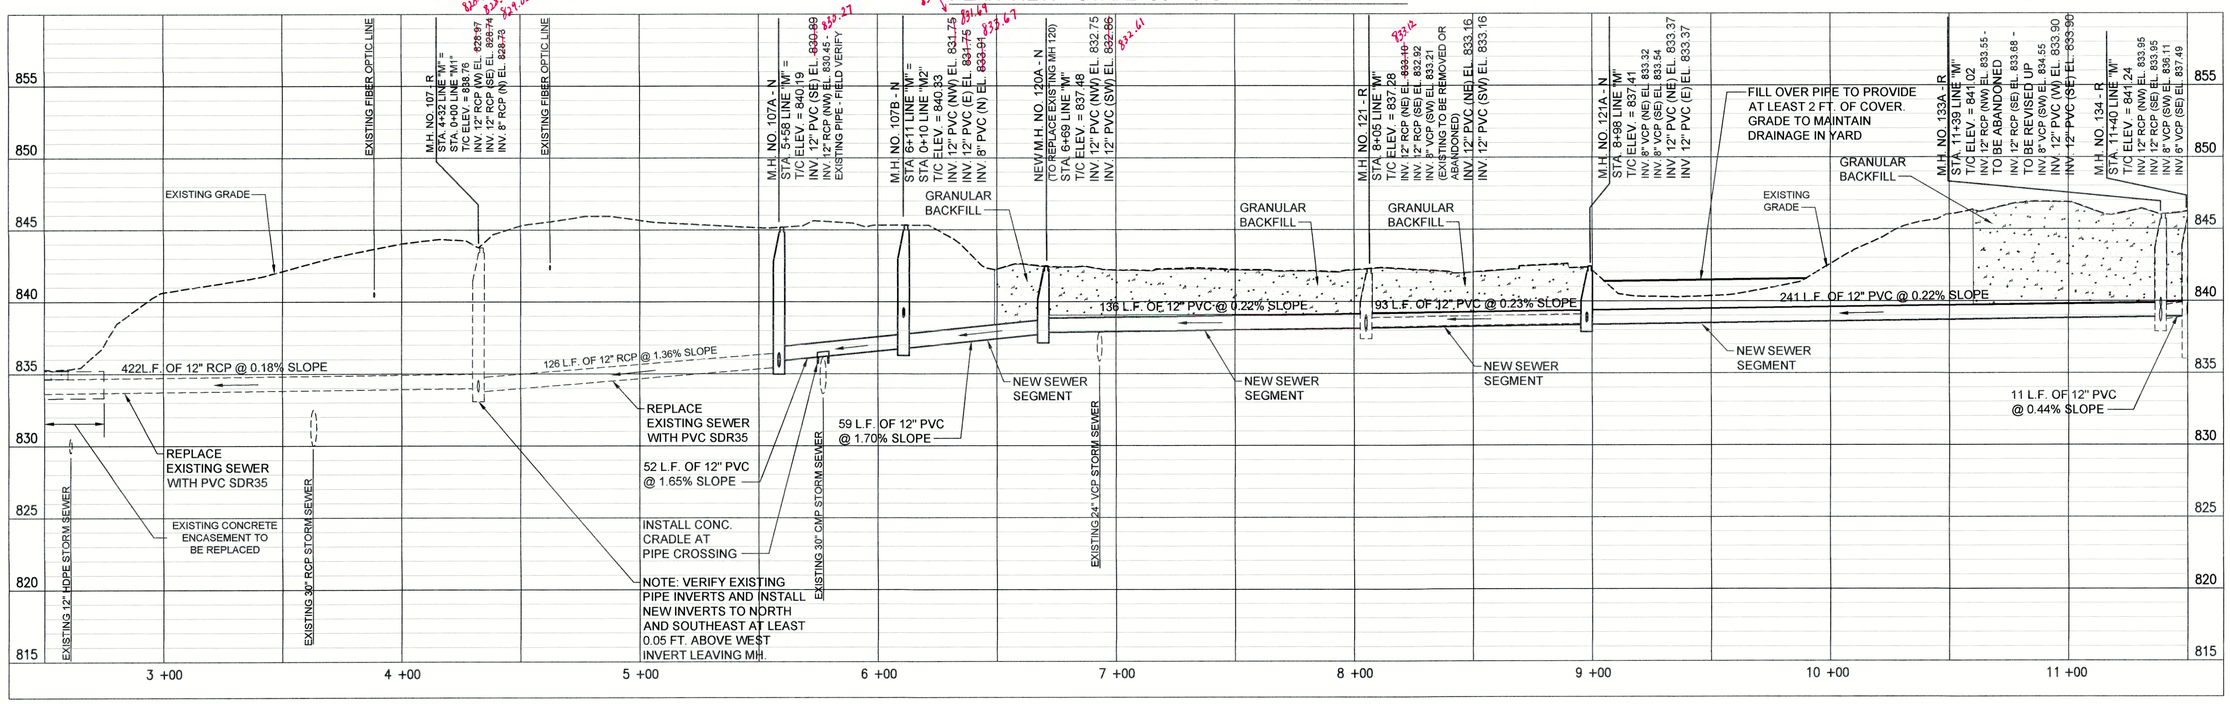


(A) PIPE SEGMENT TO BE ABANDONED

NOTES:
1. LETTERS SHOWN NEXT TO MANHOLE NUMBERS IN THE PROFILE CORRESPOND TO REHABILITATION SCHEDULE ON SHEET C-42.
2. SEE SHEETS C-01 THROUGH C-15 FOR NOTES ON LATERAL REHABILITATION WORK.

PROPOSED LEGEND

- PROPOSED PERMANENT EASEMENT
- PROPOSED RIGHT-OF-WAY
- PROPOSED SANITARY SEWER
- PROPOSED SANITARY LATERAL
- SURFACE RESTORATION AND BACKFILL

SCALE: 1"=30' HORIZONTAL (0, 30, 60)
SCALE: 1"=5' VERTICAL (5, 0)

JOSEPH P. TIERNEY REGISTERED No. 19300407 STATE OF INDIANA PROFESSIONAL ENGINEER

GRW PROJECT NO. 4447-24
SRF NO. WW16074603 --

ALL RIGHTS RESERVED
THIS DRAWING IS THE PROPERTY OF GRW ENGINEERS, INC. AND SHALL NOT BE REPRODUCED, COPIED OR USED IN WHOLE OR PART OR USED FOR CONSTRUCTION OF ANY PROJECT OTHER THAN THE SPECIFIC PROJECT FOR WHICH IT HAS BEEN PREPARED WITHOUT WRITTEN PERMISSION.

engineering | architecture | geospatial
www.gwinc.com

# PLAN AND PROFILE LINE "M"

SEWER REHABILITATION PROJECT PHASE II
TOWN OF PENDLETON, INDIANA

| REVISIONS | | | | | | |
|---|---|---|---|---|---|---|
| NO. | DESCRIPTION | DATE | BY | | | |
| --- | --- | --- | --- | | | |
| --- | --- | --- | --- | | | |

THIS MARK SHOULD MEASURE EXACTLY 1" WHEN PLOTTED

SCALE CHECK

DESIGNED: GWL
DRAWN: GCR
REVIEWED: GWL
APPROVED: JPT

DATE: MARCH 2017
SCALE: H.-1"=30', V.-1"=5'
SHEET NO: C-30

PRINTED: 3/11/2017 @ 3:18PM
FILE NAME: G:\4447-FCRWD-2015\Working Drawings\AutoCAD\REHABILITATION PHASE II\4447-24-C-30.dwg