


PLAN VIEW - STA. 0+00 TO STA. 3+70 LINE "M1"

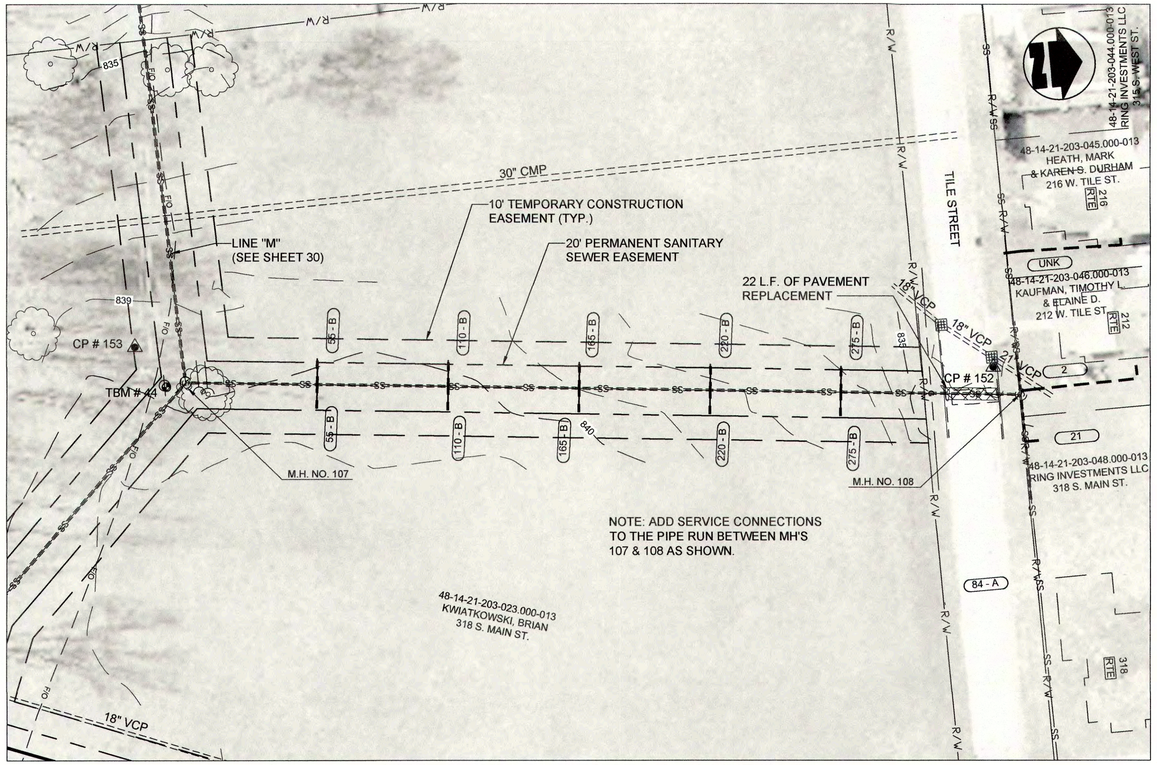


PLAN VIEW - STA. 0+00 TO STA. 3+50 LINE "M2"




PROFILE - STA. 0+00 TO STA. 3+70 LINE "M1"

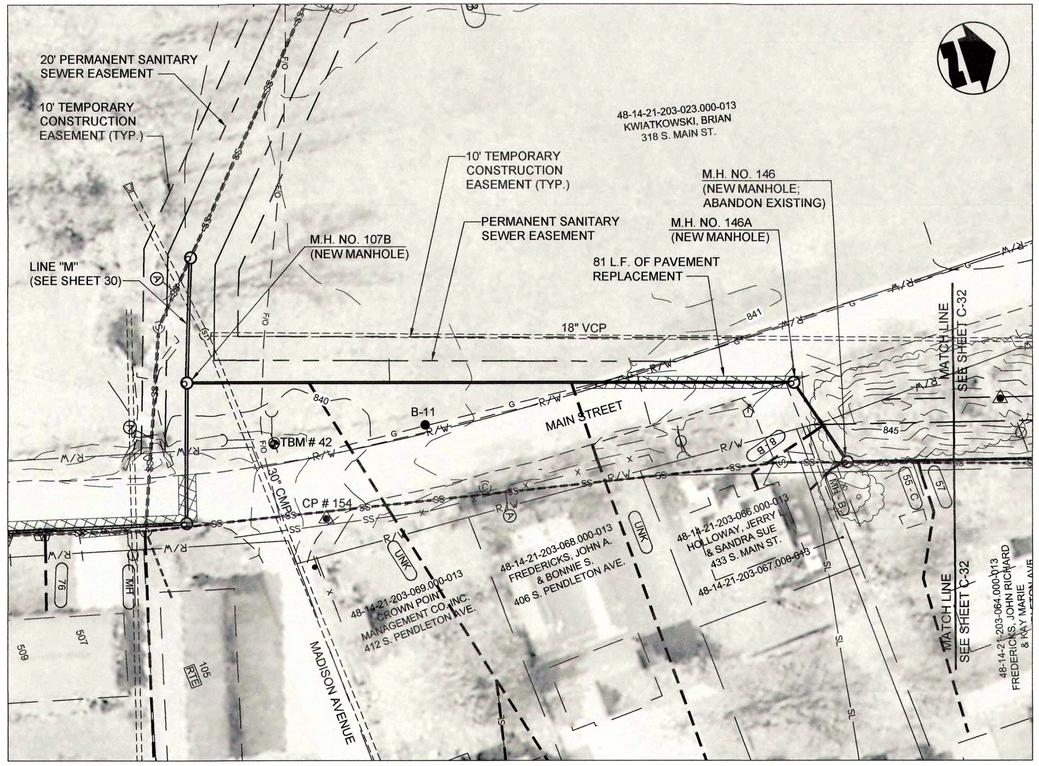


PROFILE - STA. 0+00 TO STA. 3+70 LINE "M2"

(A) PIPE SEGMENT TO BE ABANDONED

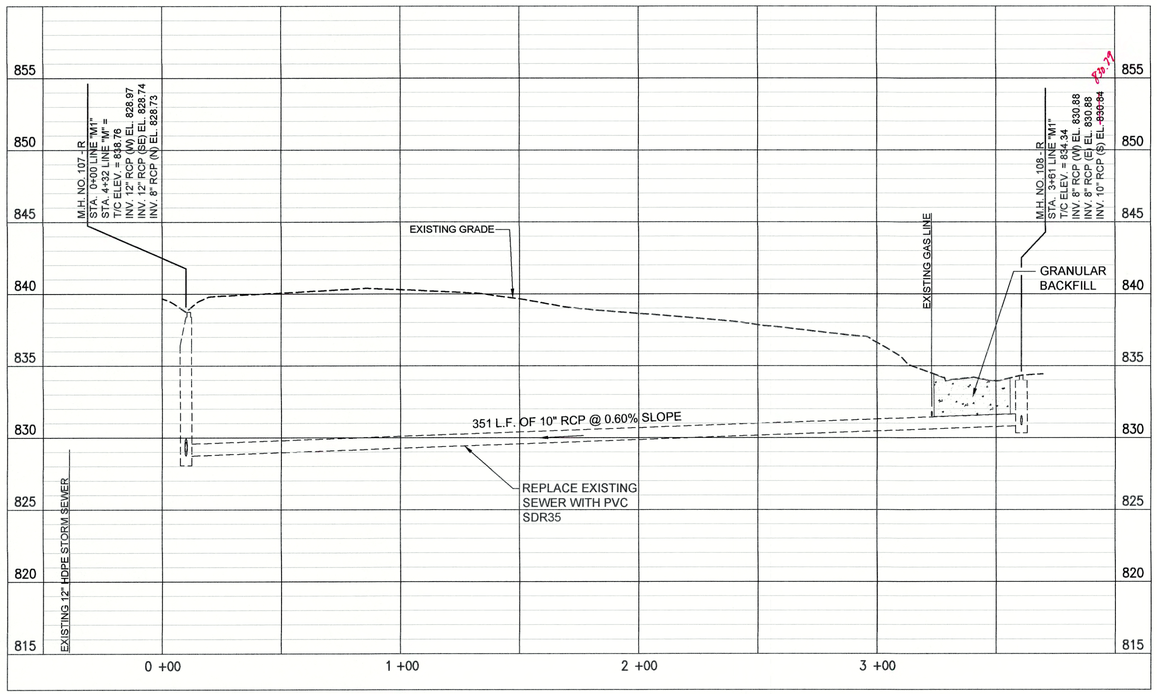NOTES:
1. LETTERS SHOWN NEXT TO MANHOLE NUMBERS IN THE PROFILE CORRESPOND TO REHABILITATION SCHEDULE ON SHEET C-42.
2. SEE SHEETS C-01 THROUGH C-15 FOR NOTES ON LATERAL REHABILITATION WORK.

PROPOSED LEGEND

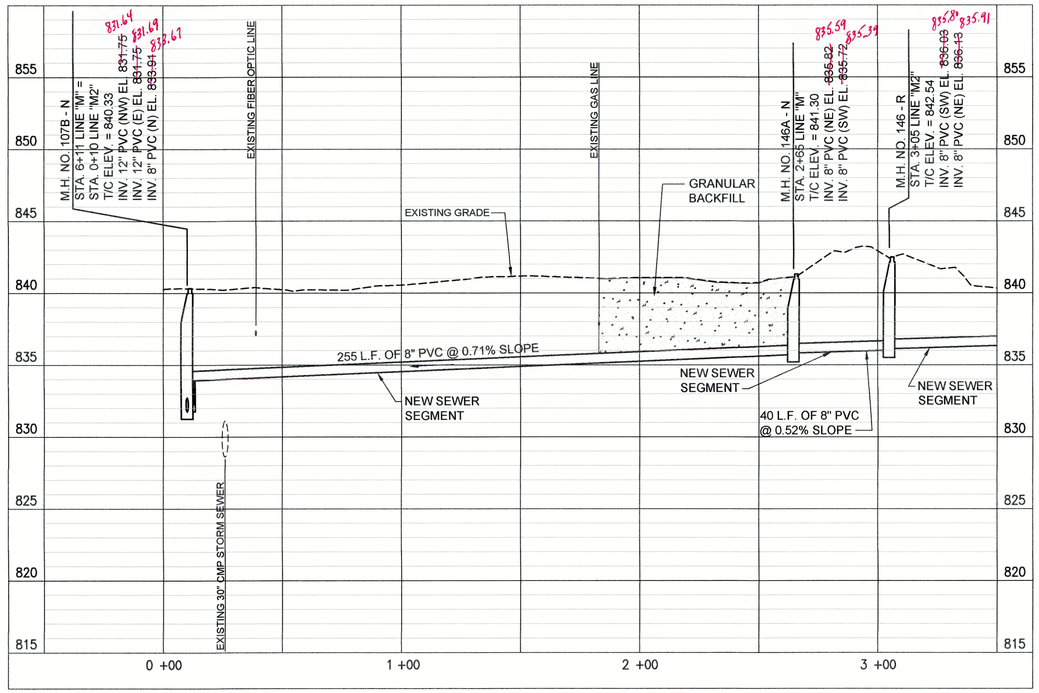- PROPOSED PERMANENT EASEMENT
- PROPOSED RIGHT-OF-WAY
- PROPOSED SANITARY SEWER
- PROPOSED SANITARY LATERAL
- SURFACE RESTORATION AND BACKFILL

SCALE: 1"=30' HORIZONTAL (0, 30, 60)
SCALE: 1"=5' VERTICAL (5, 0)

JOSEPH P. TIERNEY REGISTERED No. 19300407 STATE OF INDIANA PROFESSIONAL ENGINEER

GRW PROJECT NO. 4447-24

SRF NO. WW160748O3 --

ALL RIGHTS RESERVED
THIS DRAWING IS THE PROPERTY OF GRW ENGINEERS, INC. AND SHALL NOT BE REPRODUCED, COPIED OR USED IN PART OR USED FOR CONSTRUCTION OF ANY PROJECT OTHER THAN THE SPECIFIC PROJECT WITHOUT WRITTEN PERMISSION

engineering | architecture | geospatial
www.grwinc.com

# PLAN AND PROFILE
# LINE "M1" AND LINE "M2"
## SEWER REHABILITATION PROJECT PHASE II
## TOWN OF PENDLETON, INDIANA

| DESIGNED | DRAWN | REVIEWED | APPROVED |
|---|---|---|---|
| GWL | GCR | GWL | JPT |

REVISIONS

| NO | DESCRIPTION | DATE | BY |
|---|---|---|---|
| --- | --- | --- | --- |

SCALE CHECK: THIS MARK SHOULD MEASURE EXACTLY 1" WHEN PLOTTED

DATE: MARCH 2017

SCALE: H.-1"=30', V.-1"=5'

SHEET NO.: C-31

PRINTED: 3/11/2017 @ 3:21PM

FILE NAME: G:\4447-FCRWD-2015\Working Drawings\AutoCAD\REHABILITATION PHASE II\4447-24-C-31.dwg