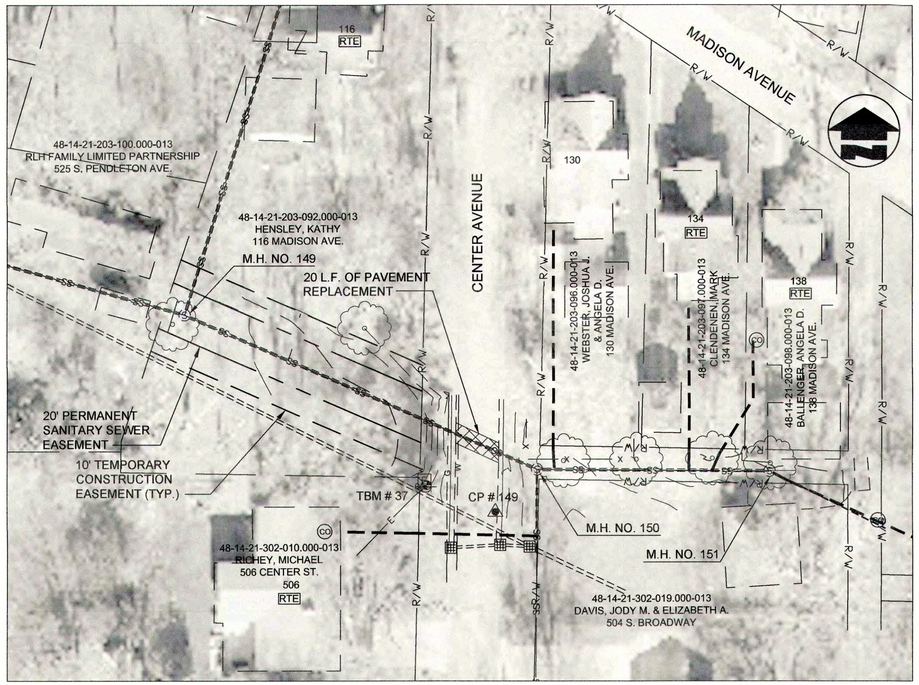

PLAN VIEW - STA. 0+00 TO STA. 2+80 LINE "N"

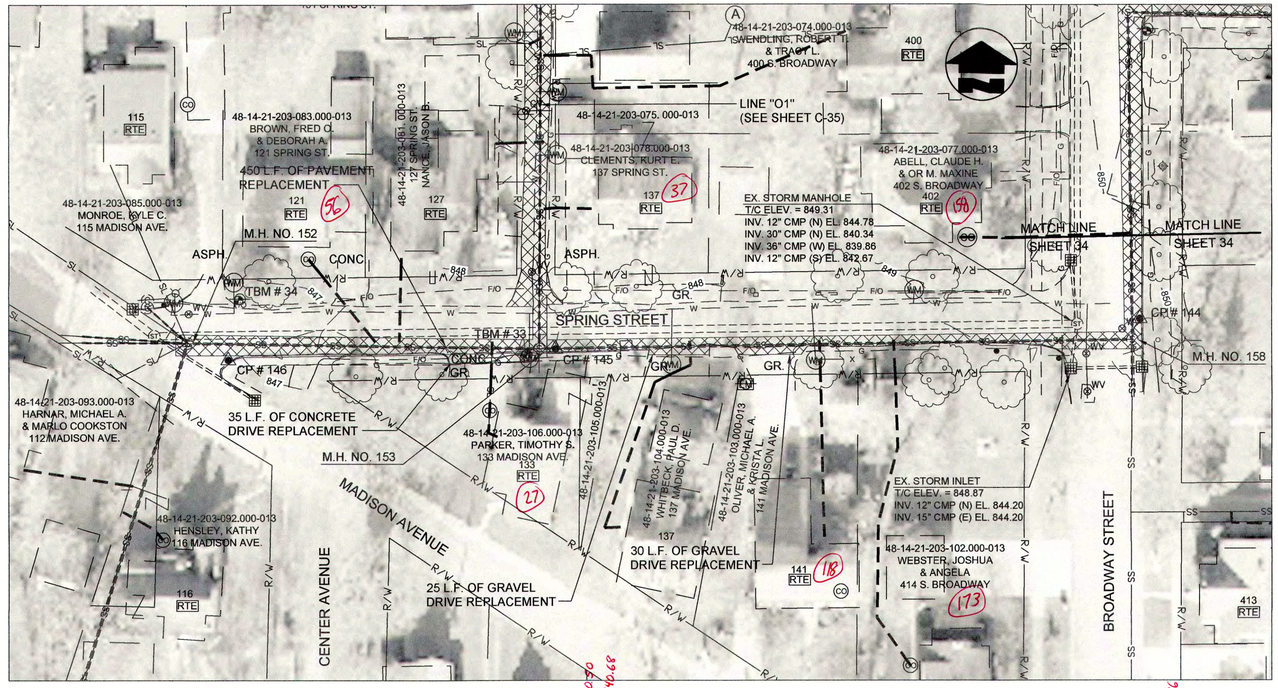

PLAN VIEW - STA. 0+00 TO STA. 4+50 LINE "O"

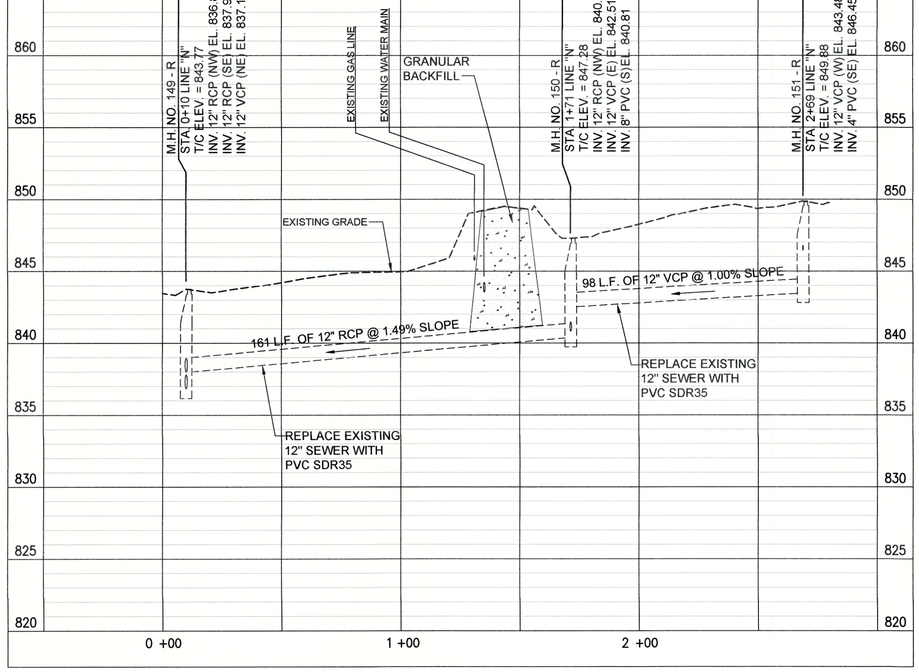

PROFILE - STA. 0+00 TO STA. 2+80 LINE "N"

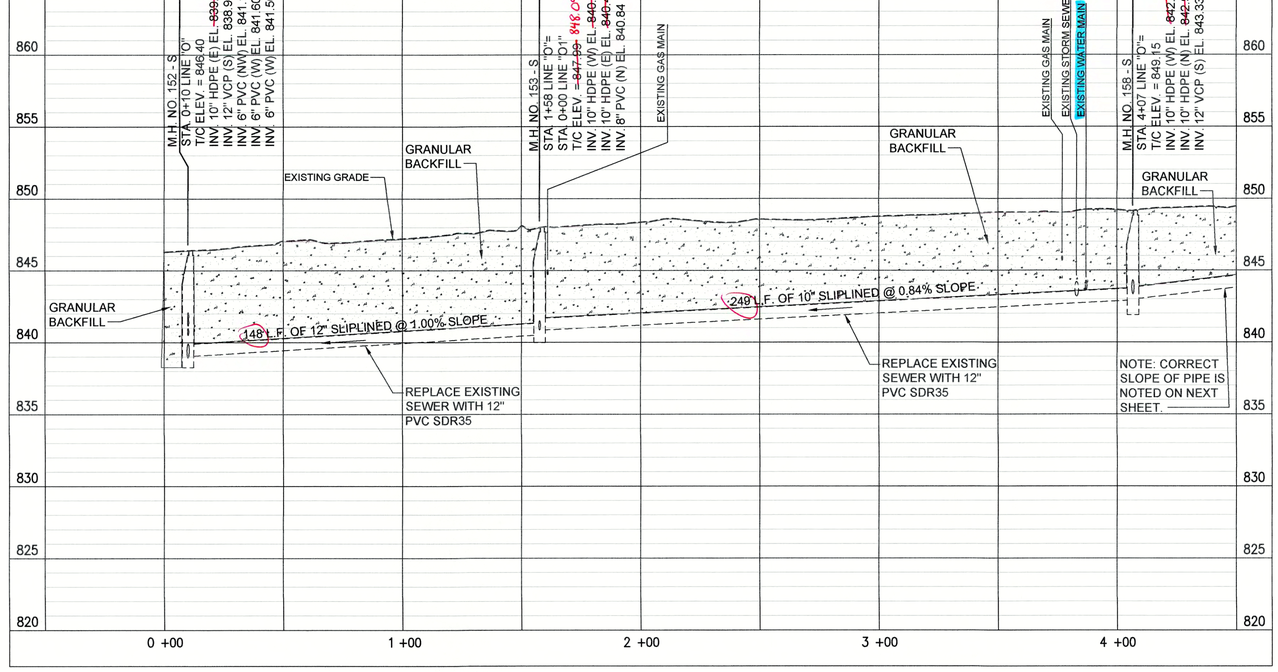

PROFILE - STA. 0+00 TO STA. 4+50 LINE "O"

(A) PIPE SEGMENT TO BE ABANDONED

NOTES:
1. LETTERS SHOWN NEXT TO MANHOLE NUMBERS IN THE PROFILE CORRESPOND TO REHABILITATION SCHEDULE ON SHEET C-42.
2. SEE SHEETS C-01 THROUGH C-15 FOR NOTES ON LATERAL REHABILITATION WORK.

PROPOSED LEGEND

- PROPOSED PERMANENT EASEMENT
- PROPOSED RIGHT-OF-WAY
- PROPOSED SANITARY SEWER
- PROPOSED SANITARY LATERAL
- SURFACE RESTORATION AND BACKFILL

SCALE: 1"=30' HORIZONTAL (0, 30, 60)
SCALE: 1"=5' VERTICAL (5, 0)

JOSEPH P. TIERNEY REGISTERED No. 19300407 STATE OF INDIANA PROFESSIONAL ENGINEER

GRW PROJECT NO. 4447-24
SRF NO. WW160174803 --

ALL RIGHTS RESERVED
THIS DRAWING IS THE PROPERTY OF GRW ENGINEERS, INC. AND SHALL NOT BE REPRODUCED OR USED IN ANY MANNER OR AS-USED FOR CONSTRUCTION OF ANY PROJECT OTHER THAN THE SPECIFIC PROJECT WITHOUT WRITTEN PERMISSION

GRW
engineering | architecture | geospatial
www.grwinc.com

PLAN AND PROFILE
LINE "N" AND LINE "O"
SEWER REHABILITATION PROJECT PHASE II
TOWN OF PENDLETON, INDIANA

DESIGNED	DRAWN	REVIEWED	APPROVED
GWL	GCR	GWL	JPT

REVISIONS

NO.	DESCRIPTION	DATE	BY
----	----	----	----

SCALE CHECK: THIS MARK SHOULD MEASURE EXACTLY 1" WHEN PLOTTED

DATE: MARCH 2017
SCALE: H.-1"=30', V.-1"=5'
SHEET NO. C-33

PRINTED: 3/1/2017 @ 3:27PM
FILE NAME: G:\4447-FCRWD-2015\Working Drawings\AutoCAD\REHABILITATION PHASE II\4447-24-C-33.dwg