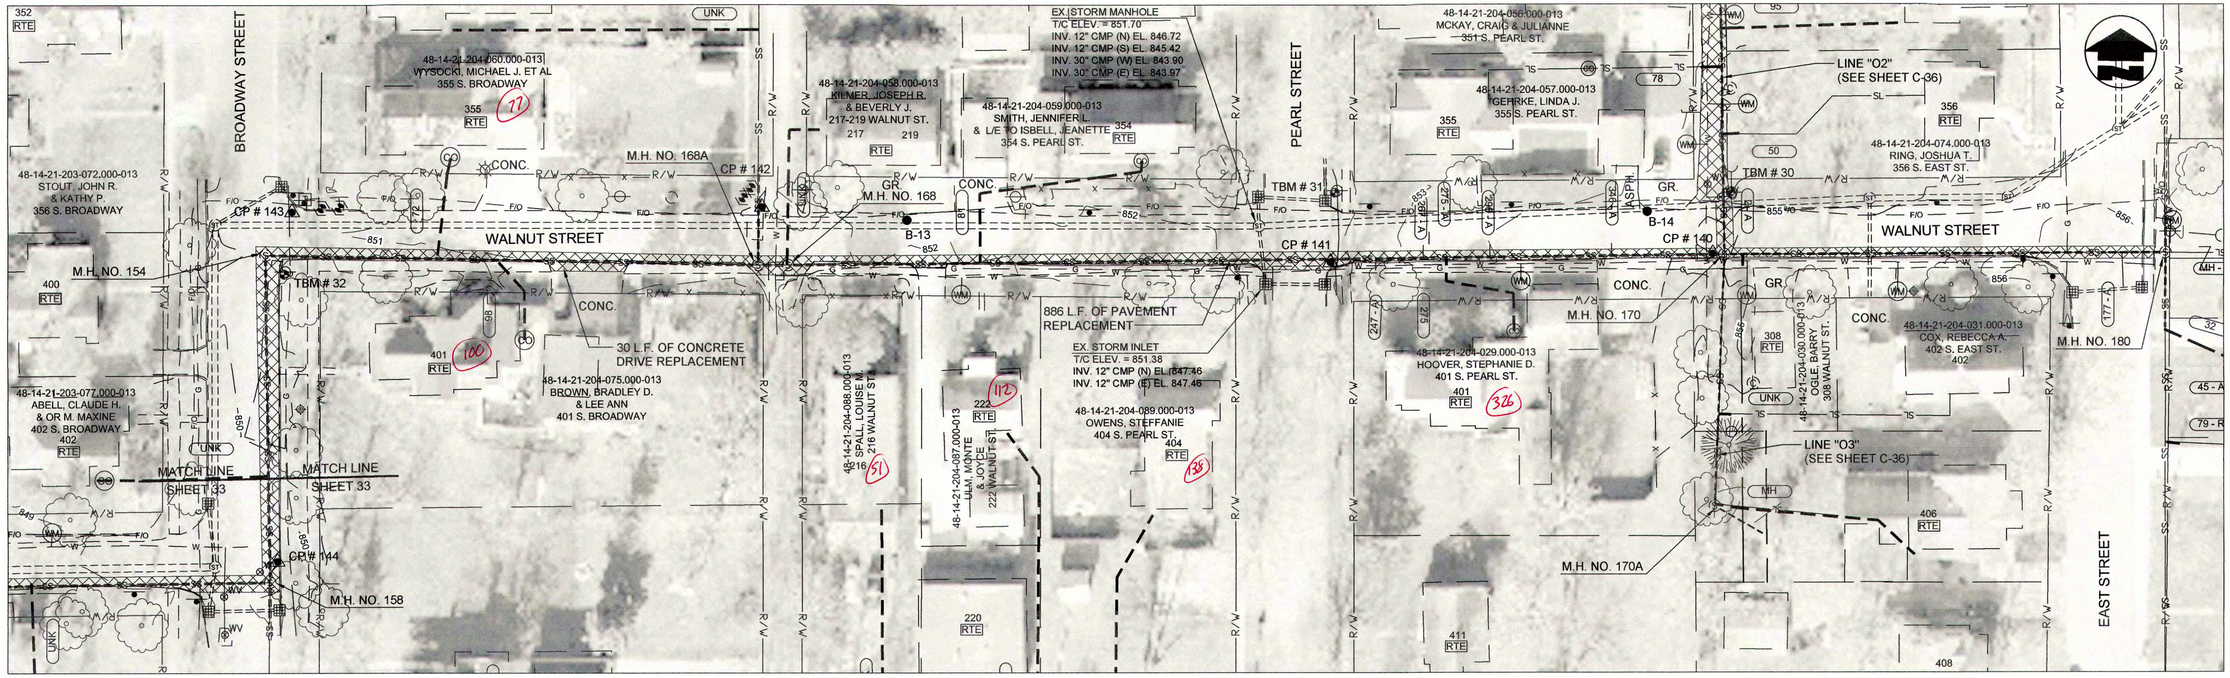

PLAN VIEW - STA. 4+50 TO STA. 13+50 LINE "O"

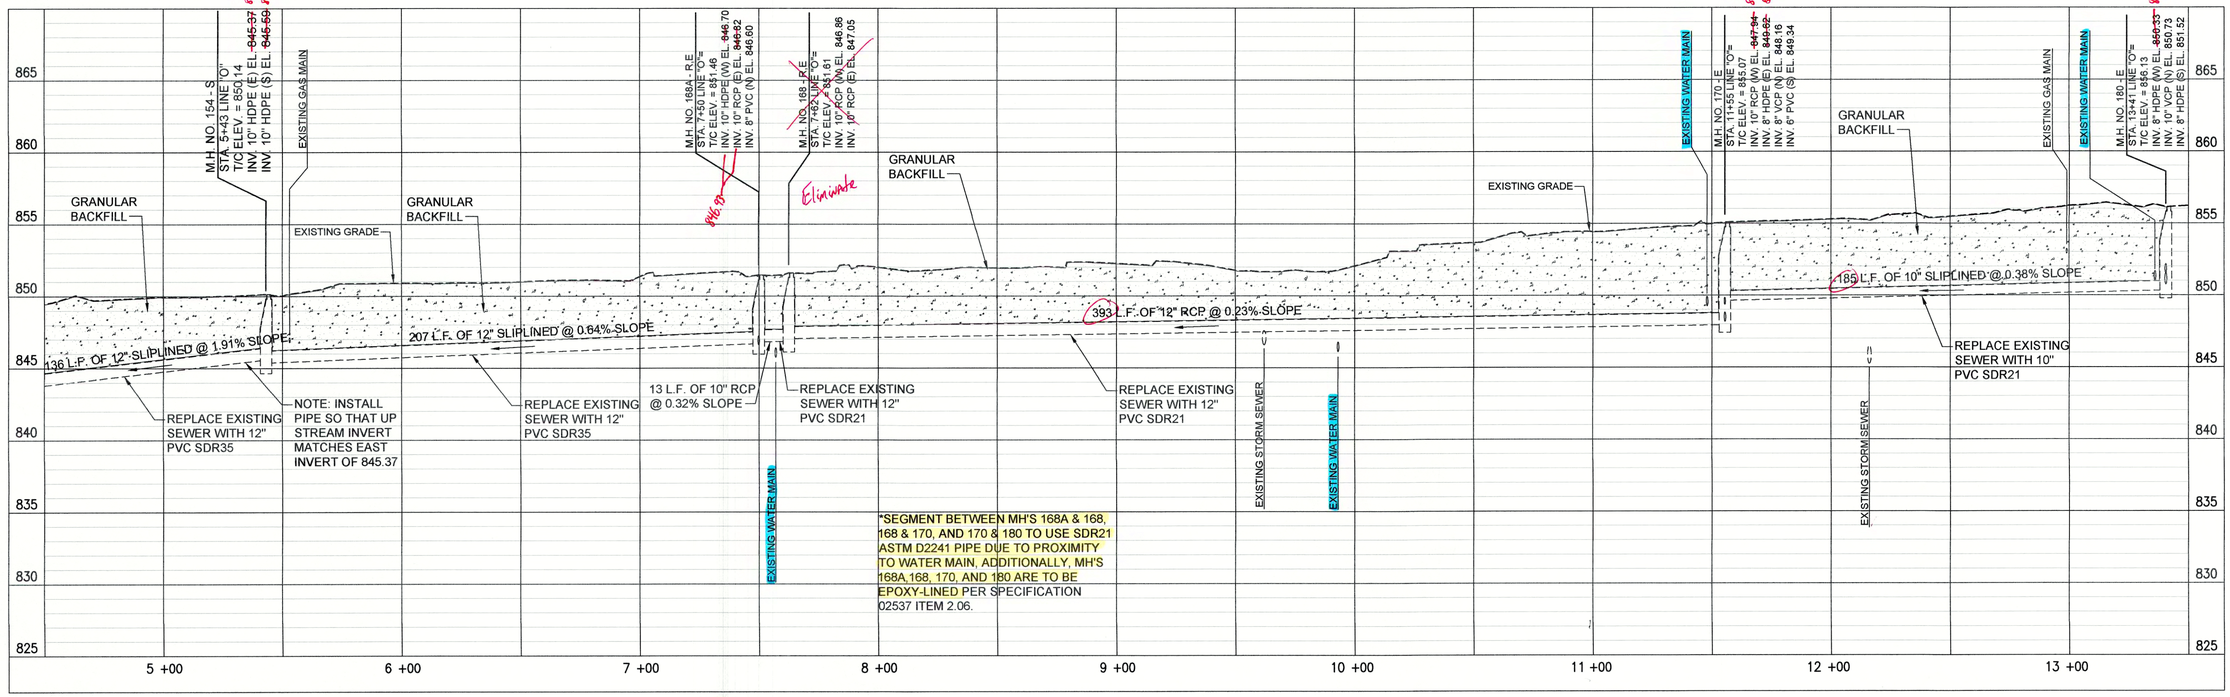

PROFILE - STA. 4+50 TO STA. 13+50 LINE "O"

(A) PIPE SEGMENT TO BE ABANDONED

NOTES:
1. LETTERS SHOWN NEXT TO MANHOLE NUMBERS IN THE PROFILE CORRESPOND TO REHABILITATION SCHEDULE ON SHEET C-42.
2. SEE SHEETS C-01 THROUGH C-15 FOR NOTES ON LATERAL REHABILITATION WORK.

PROPOSED LEGEND

- PROPOSED PERMANENT EASEMENT
- PROPOSED RIGHT-OF-WAY
- PROPOSED SANITARY SEWER
- PROPOSED SANITARY LATERAL
- SURFACE RESTORATION AND BACKFILL

SCALE: 1"=30' HORIZONTAL (0, 30, 60)
SCALE: 1"=5' VERTICAL (5, 0)

JOSEPH P. TIERNEY
REGISTERED
No. 19300407
STATE OF INDIANA
PROFESSIONAL ENGINEER

GRW PROJECT NO. 4447-24
SRF NO. WW160748O3 --

ALL RIGHTS RESERVED
THIS DRAWING IS THE PROPERTY OF GRW ENGINEERS, INC. AND SHALL NOT BE REPRODUCED, COPIED OR USED IN PART OR WHOLE OR AS AN INSTRUMENT OF SERVICE FOR ANY PROJECT OR USED FOR CONSTRUCTION OF ANY PROJECT WITHOUT WRITTEN PERMISSION

engineering | architecture | geospatial
www.grwinc.com

PLAN AND PROFILE LINE "O"
SEWER REHABILITATION PROJECT PHASE II
TOWN OF PENDLETON, INDIANA

DESIGNED	DRAWN	REVIEWED	APPROVED
GWL	GCR	GWL	JPT

REVISIONS

NO.	DESCRIPTION	DATE	BY
----	----	----	----

THIS MARK SHOULD MEASURE EXACTLY 1" WHEN PLOTTED
SCALE CHECK

DATE: MARCH 2017
SCALE: H.-1"=30', V.-1"=5'
SHEET NO. C-34

PRINTED: 3/11/2017 @ 3:30PM
FILE NAME: G:\4447-FCRWD-2015\Working Drawings\AutoCAD\REHABILITATION PHASE II\4447-24-C-34.dwg