


PLAN VIEW - STA. 0+00 TO STA. 8+50 LINE "Q"

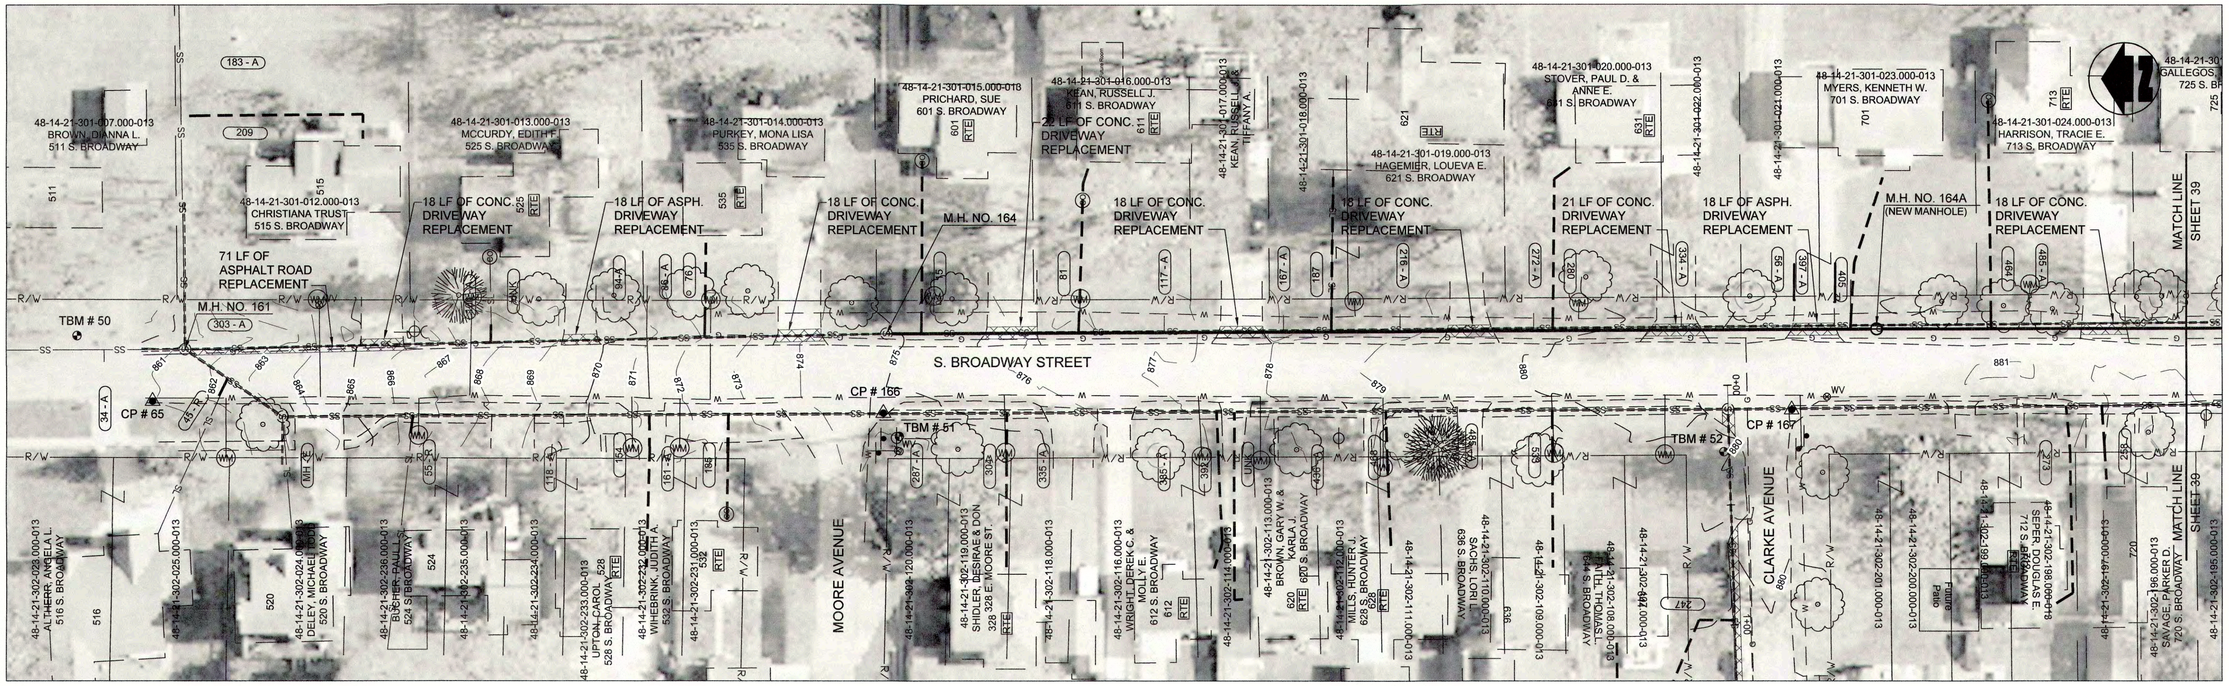


PROFILE - STA. 0+00 TO STA. 8+50 LINE "Q"

SHEET NOTE:
SEWER IN PROFILE IS ON EAST SIDE OF ROAD. SEWER ON WEST SIDE OF ROAD TO BE CIPP LINED.

(A) PIPE SEGMENT TO BE ABANDONED

NOTES:
1. LETTERS SHOWN NEXT TO MANHOLE NUMBERS IN THE PROFILE CORRESPOND TO REHABILITATION SCHEDULE ON SHEET C-42.
2. SEE SHEETS C-01 THROUGH C-15 FOR NOTES ON LATERAL REHABILITATION WORK.
3. NEW SEWER HAS ALIGNMENT SHIFTED WEST FROM EXISTING TO INCREASE DISTANCE FROM WATER MAIN. SERVICE REPLACEMENTS SHALL BE EXTENDED TO NEW MAIN LOCATION.

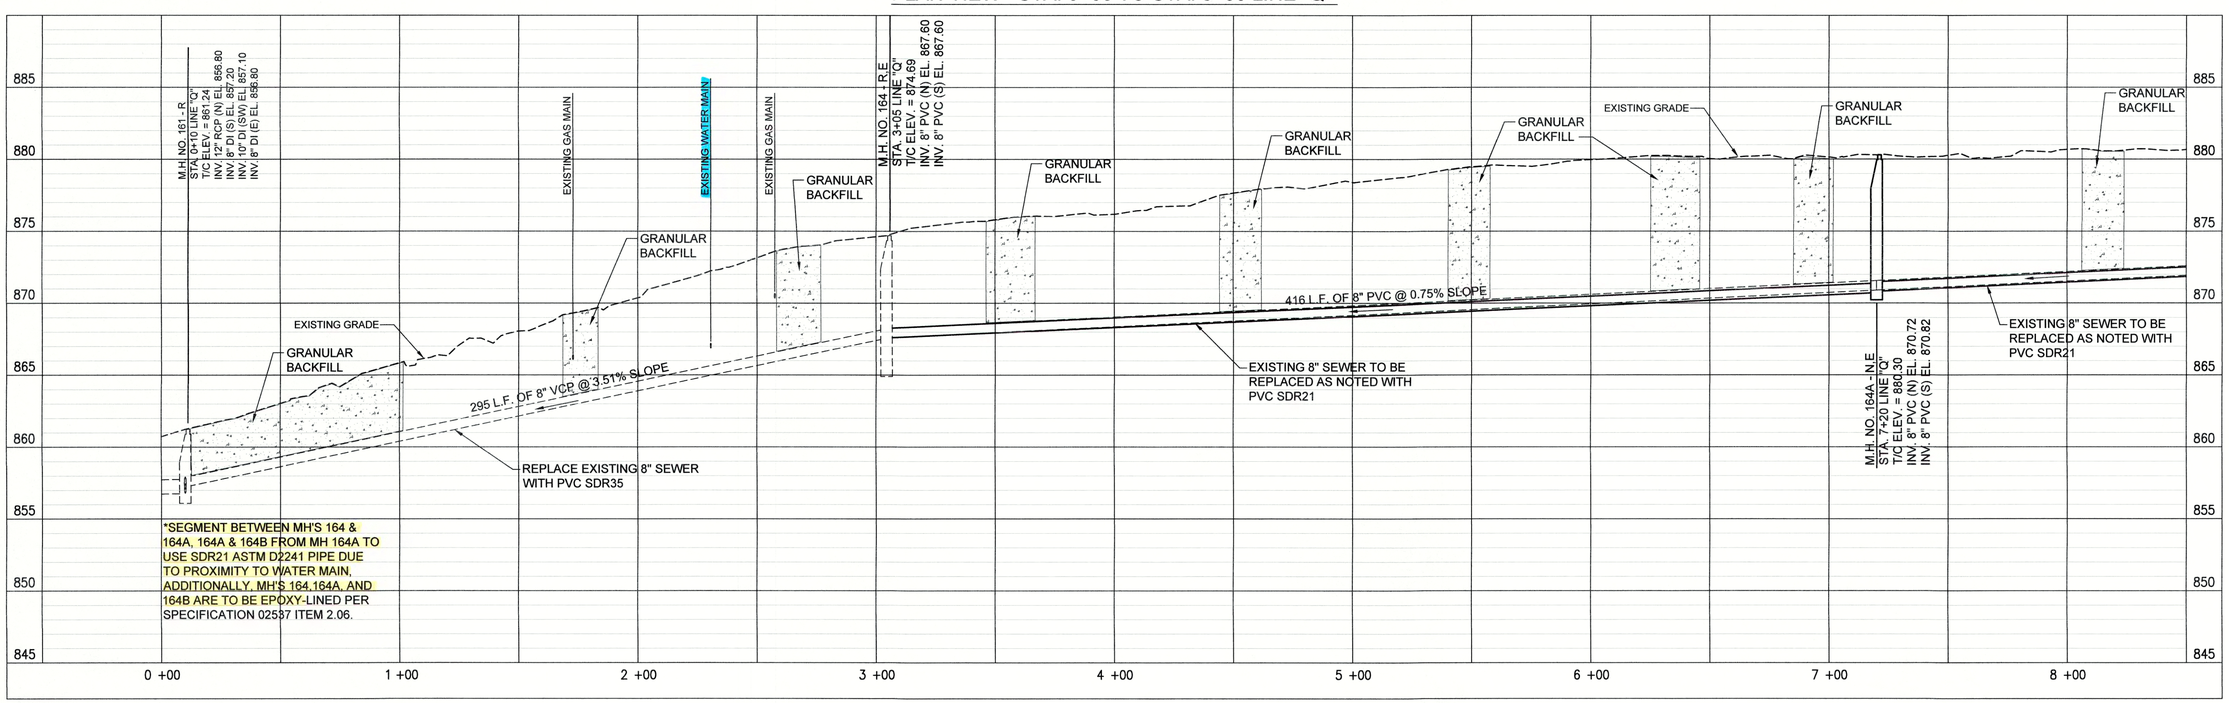PROPOSED LEGEND

- PROPOSED PERMANENT EASEMENT
- PROPOSED RIGHT-OF-WAY
- PROPOSED SANITARY SEWER
- PROPOSED SANITARY LATERAL
- SURFACE RESTORATION AND BACKFILL

SCALE: 1"=30' HORIZONTAL (0, 30, 60)
SCALE: 1"=5' VERTICAL (5, 0)

JOSEPH P. TIERNEY
REGISTERED
No. 19300407
STATE OF INDIANA
PROFESSIONAL ENGINEER

GRW PROJECT NO. 4447-24
SRF NO. WW16074803 --

ALL RIGHTS RESERVED.
THIS DRAWING IS THE PROPERTY OF GRW ENGINEERS, INC. AND SHALL NOT BE REPRODUCED IN WHOLE OR IN PART OR USED FOR ANY PURPOSE WHATSOEVER OTHER THAN THE SPECIFIC PROJECT WITHOUT WRITTEN PERMISSION.

engineering | architecture | geospatial
www.grwinc.com

# PLAN AND PROFILE LINE "Q"
SEWER REHABILITATION PROJECT PHASE II
TOWN OF PENDLETON, INDIANA

| DESIGNED: | DRAWN: | REVIEWED: | APPROVED: |
|---|---|---|---|
| GWL | GCR | GWL | JPT |

REVISIONS

| NO. | DESCRIPTION | DATE | BY |
|---|---|---|---|
| --- | --- | --- | --- |

THIS MARK SHOULD MEASURE EXACTLY 1" WHEN PLOTTED
SCALE CHECK

DATE: MARCH 2017
SCALE: H.-1"=30', V.-1"=5'
SHEET NO. C-38

PRINTED: 3/14/2017 @ 2:11PM
FILE NAME: G:\4447-FCRWD-2015\Working Drawings\AutoCAD\REHABILITATION PHASE II\4447-24-C-38.dwg