## TYPICAL APPLICATIONS OF TRAFFIC DEVICES FOR AN URBAN DETOUR

## NOTES:

- FOR DETOUR ROUTE MARKER ASSEMBLIES (B) (C), AND (D) SEE INDOT STANDARD DRAWINGS E 801-TCDT-03.
- 2. SEE INDOT STANDARD DRAWING E 801-TCLG-01 FOR STANDARD NOTES AND LEGEND.

## DETAIL - TRAFFIC CONTROL PLAN FOR LOCAL DETOUR SCALE: N.T.S.

NOTE: TRAFFIC CONTROL PLANS ARE GUIDELINES ONLY. ALL TRAFFIC CONTROL PLANS AND LANE CLOSURES MUST BE APPROVED BY THE APPROPRIATE AGENCY. TOWN OF PENDLETON: (765) 778-2173

No.

19300407 \*

STATE OF

NOIANA CHANGE
































GRW PROJECT NO. 4447-24 SRF NO. WW16074803 -
SRF NO. WW16074803 -
ALL RIGHTS RESERVED:
THIS DOCUMENT IS THE PROPERTY OF

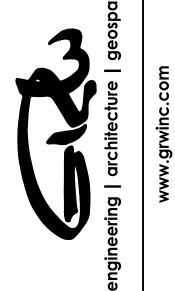

## MAINTENANCE OF TRAFFIC SANITARY SEWER REHABILITATION SEWER REHABILITATION PROJECT PHASE II TOWN OF PENDLETON, INDIANA

DATE BY GWL

---- DRAWN:
GCR
REVIEWED:
JPT
IDT

DESCRIPTION

---

MARCH 2017
SCALE:
N.T.S.

N. I.S.

C-48