



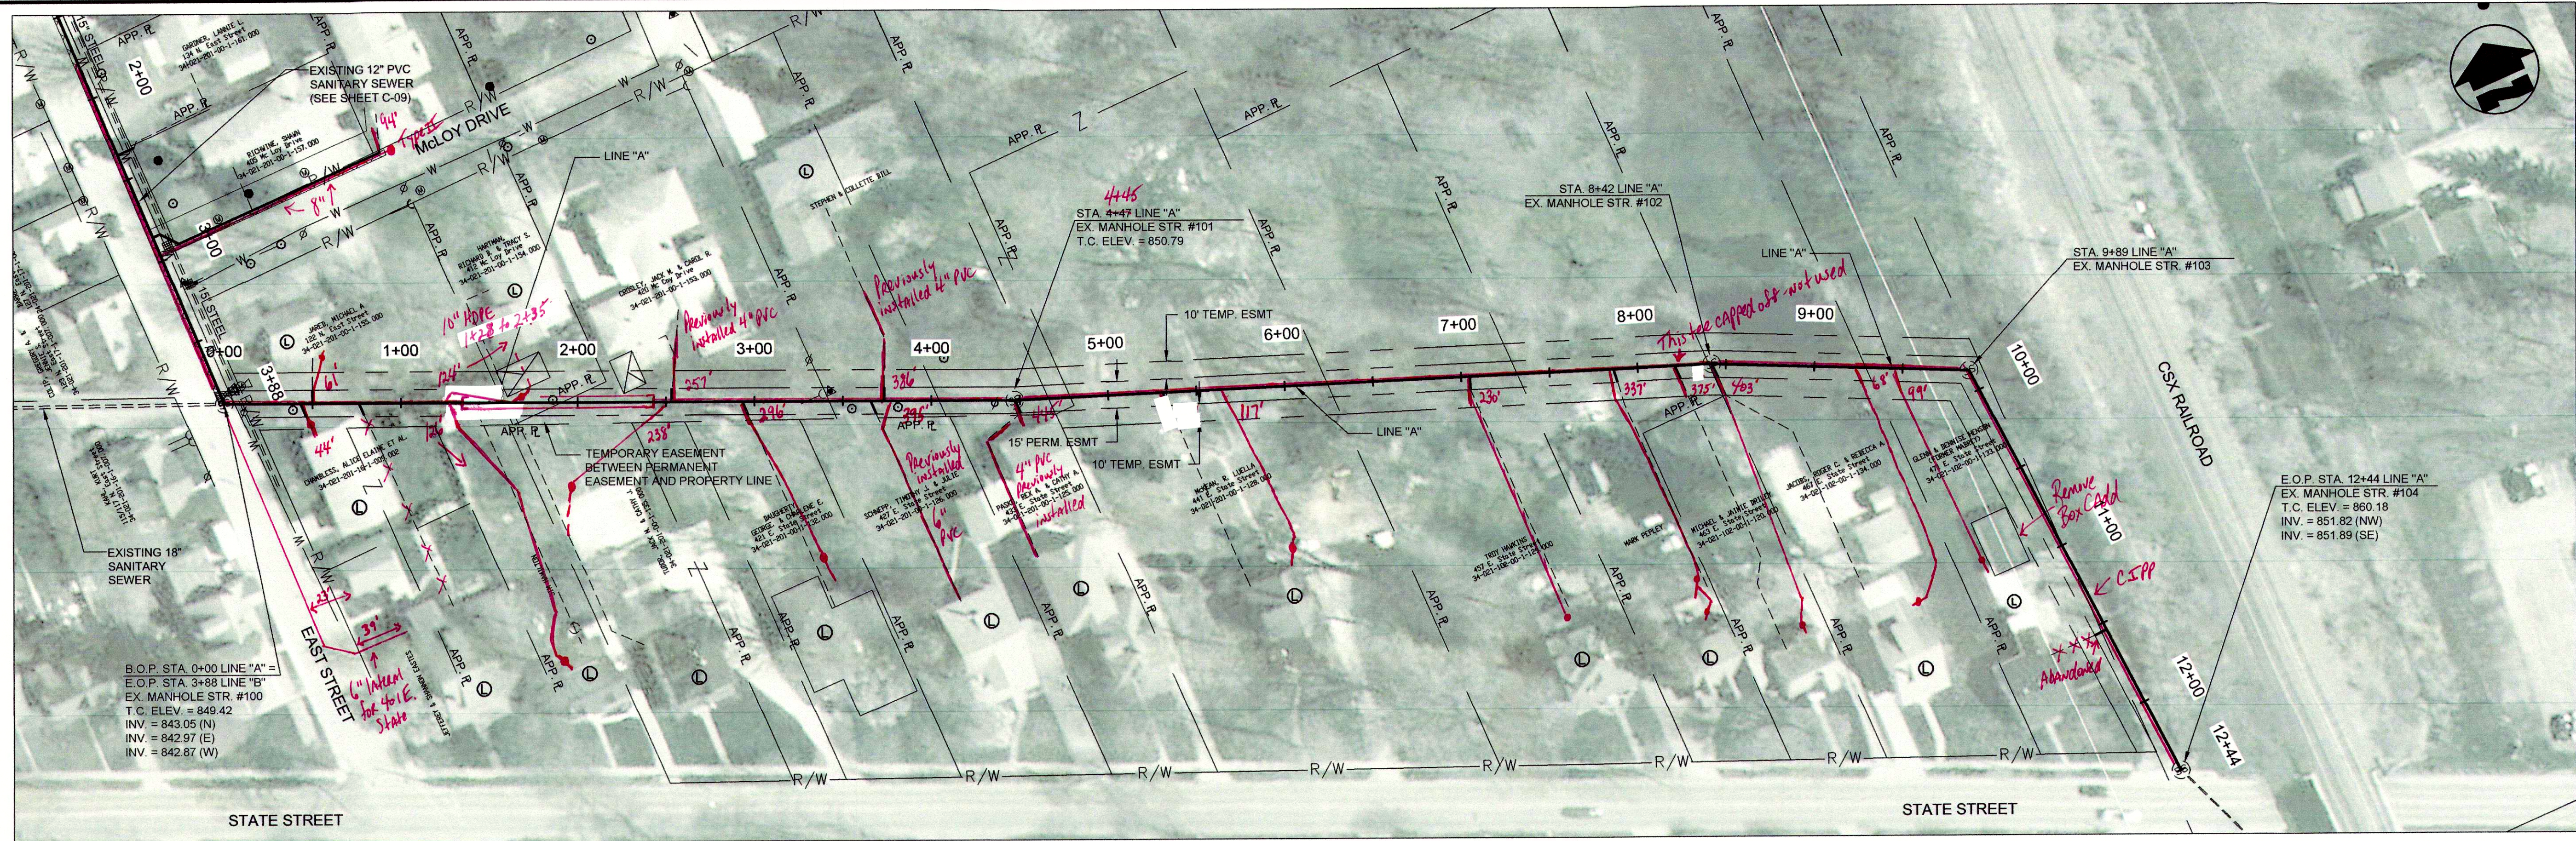

PLAN VIEW - B.O.P. STA. 0+00 TO E.O.P. STA. 12+44 LINE "A"

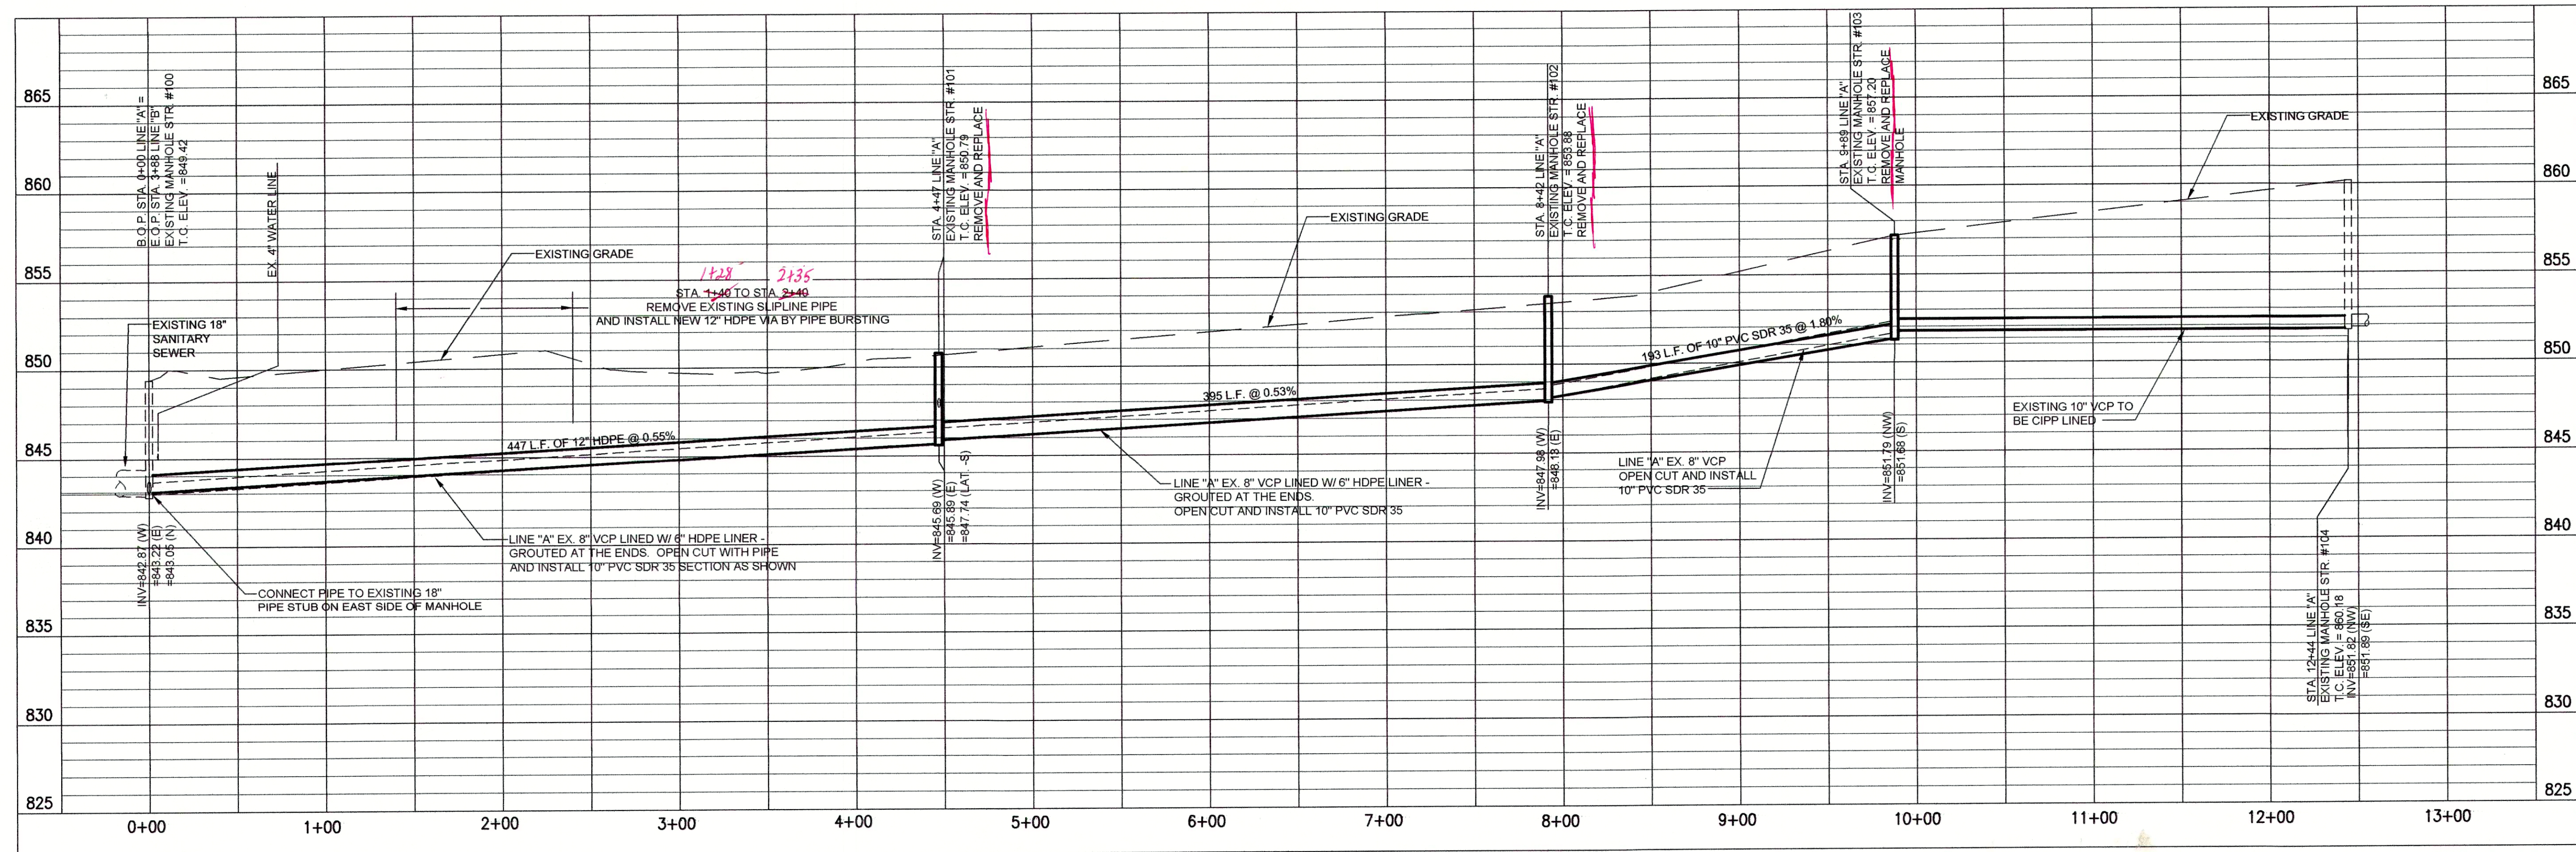

PROFILE - B.O.P. STA. 0+00 TO E.O.P. STA. 12+44 LINE "A"

① PRIVATE LATERALS TO BE REPLACED.
SEE WORK DESCRIPTION IN MEASUREMENT
AND PAYMENT SPECIFICATION.

NOTE:
1. THE WORK ON THIS SHEET TO REPLACE THE MAIN AND RECONNECT TO THE LATERALS WITHIN PERMANENT EASEMENT SHALL BE INCLUDED IN ADDITIVE ALTERNATE NO. 1.
2. THE WORK TO REPLACE THE PRIVATE LATERALS SHALL BE INCLUDED IN ADDITIVE ALTERNATE NO. 2
3. LATERAL LOCATIONS SHOWN ARE BASED ON BEST AVAILABLE INFORMATION. CONTRACTOR SHALL FIELD VERIFY EXISTING LATERAL LOCATIONS AND DEPTHS.

JOSEPH P. TURLEY
No. 19300407
STATE OF INDIANA
PROFESSIONAL ENGINEER

GRW PROJECT NO. 4447-14
SRF NO. WW16074803

GCR
engineering | architecture | geospatial

www.gwinc.com

PLAN & PROFILE
SANITARY SEWER REHABILITATION
FALL CREEK REGIONAL WASTE DISTRICT
PENDLETON, INDIANA

REVISIONS		DATE	BY	DATE	BY
NO.	DESCRIPTION				

DESIGNED	GWL	DRAWN	GCR	REVIEWED	JPT	APPROVED	JPT

DATE: APRIL 2016
SCALE: H: 1"=50' V: 1"=10'
SHEET NO.

C-12