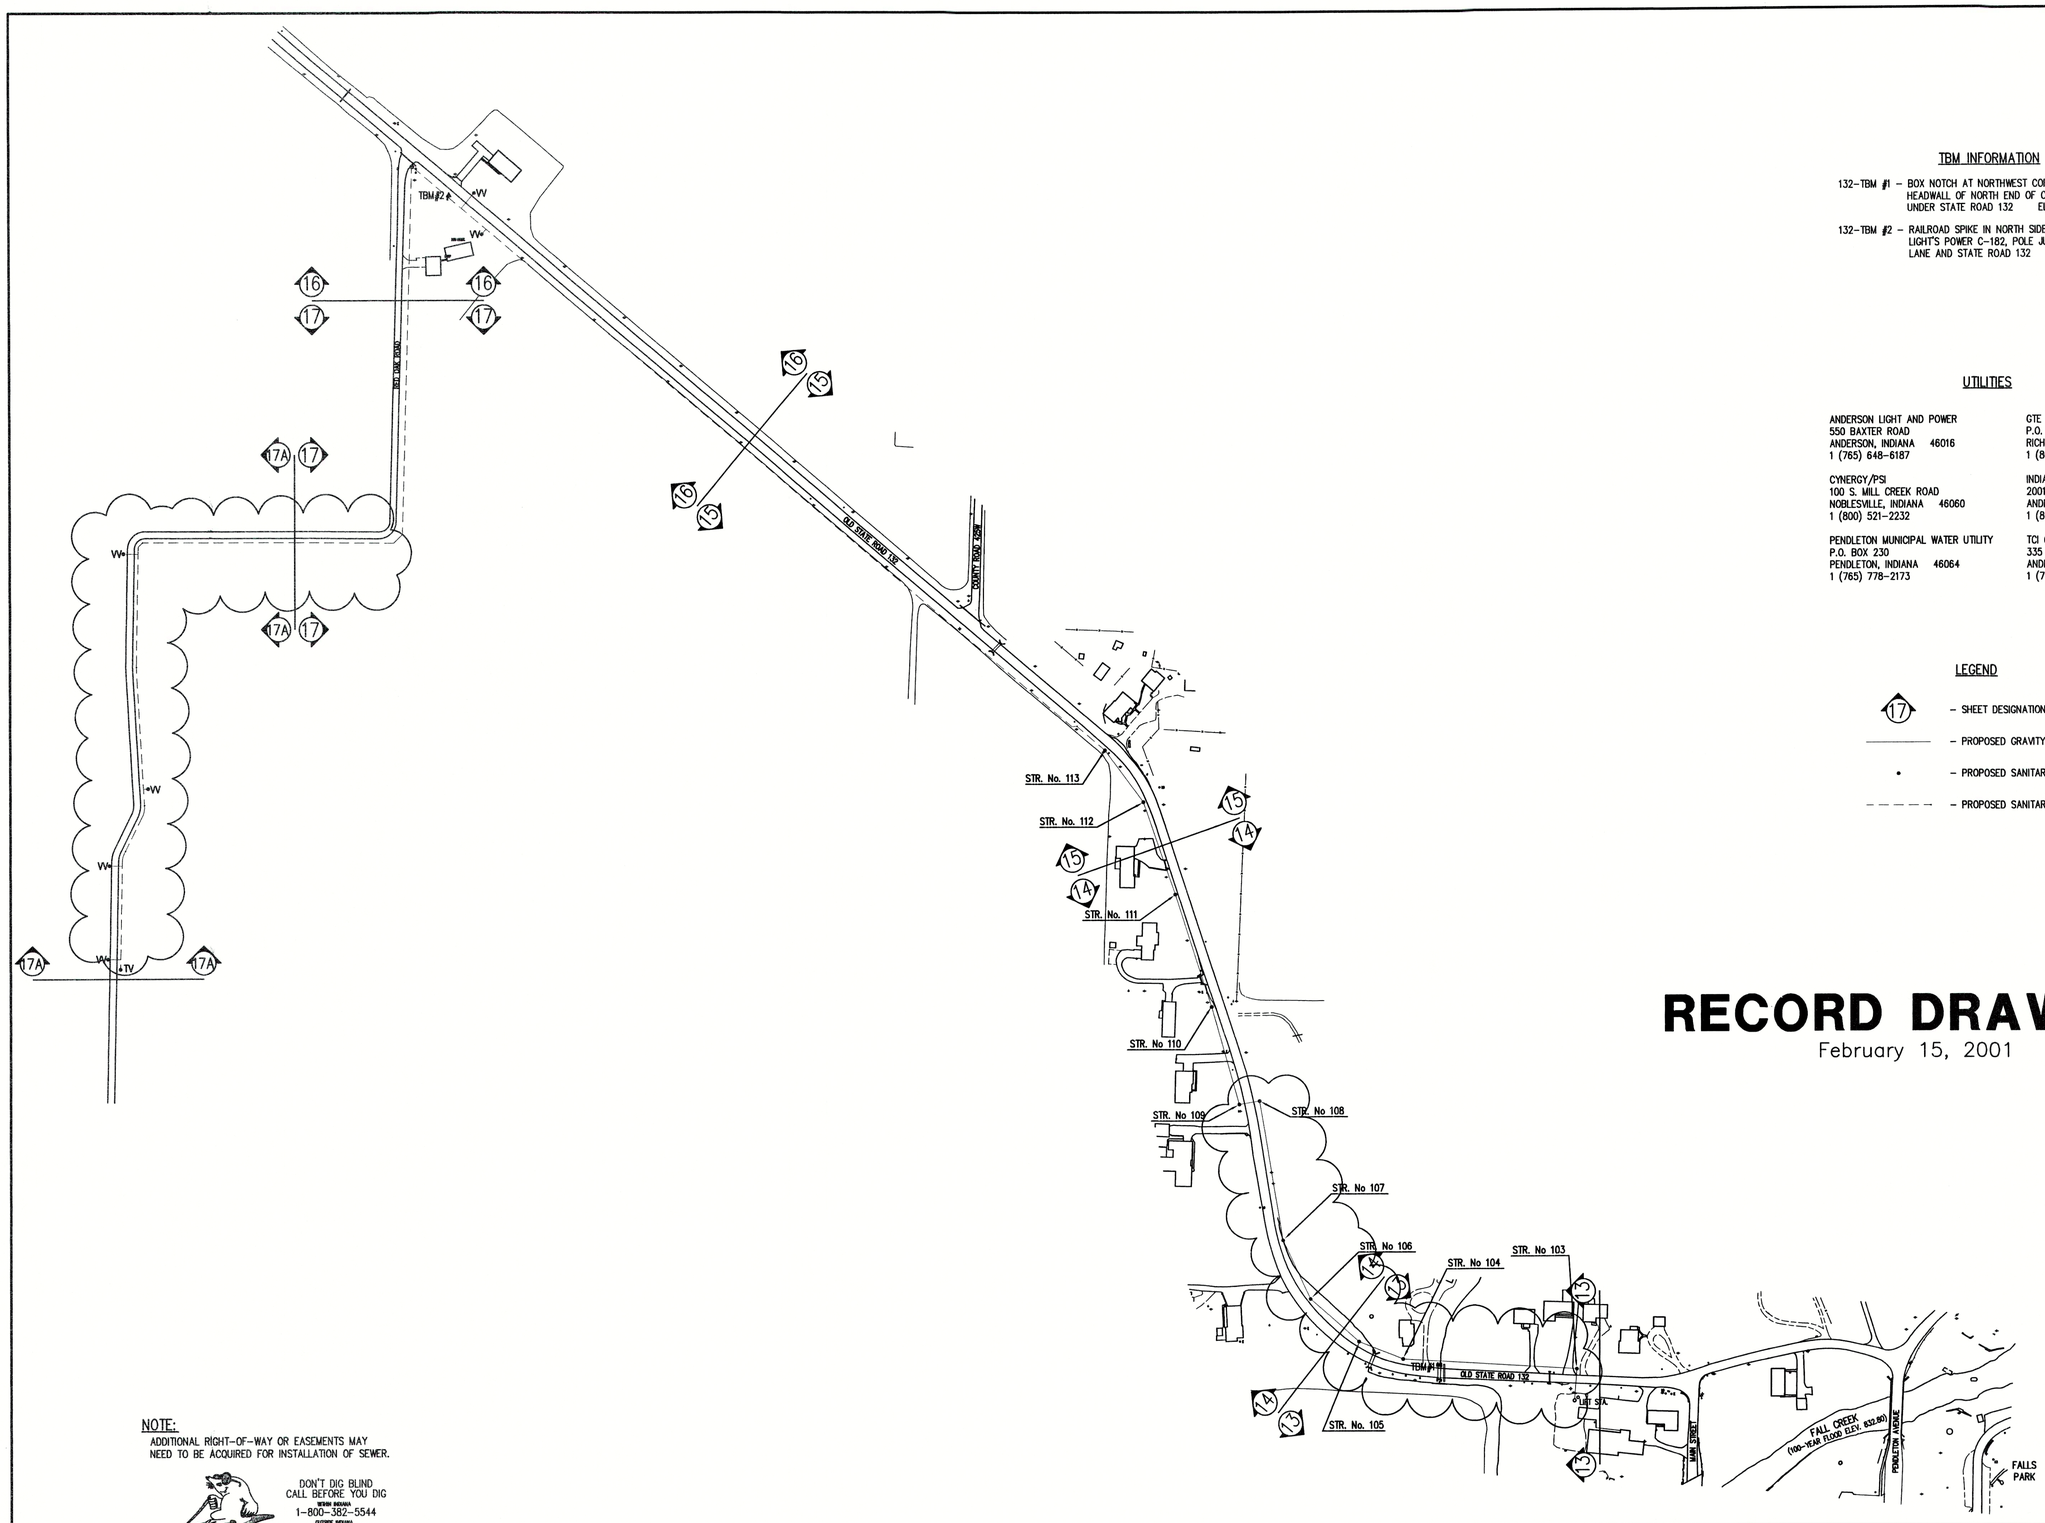

TBM INFORMATION

132-TBM #1 – BOX NOTCH AT NORTHWEST CORNER OF WEST HEADWALL OF NORTH END OF CONCRETE CULVERT UNDER STATE ROAD 132 ELEV. – 838.40

132-TBM #2 – RAILROAD SPIKE IN NORTH SIDE OF POWERPOLE PEND LIGHT'S POWER C-182, POLE JUST SOUTH OF RED OAKS LANE AND STATE ROAD 132 ELEV. – 870.43

UTILITIES

ANDERSON LIGHT AND POWER
550 BAXTER ROAD
ANDERSON, INDIANA 46016
1 (765) 648-6187

CYNERGY/PSI
100 S. MILL CREEK ROAD
NOBLESVILLE, INDIANA 46060
1 (800) 521-2232

PENDLETON MUNICIPAL WATER UTILITY
P.O. BOX 230
PENDLETON, INDIANA 46064
1 (765) 778-2173

GTE
P.O. BOX 1406
RICHMOND, INDIANA 47375
1 (800) 483-5600

INDIANA GAS COMPANY, INC.
2001 LOUISE STREET
ANDERSON, INDIANA 46016
1 (800) 777-2060

TCI OF CENTRAL INDIANA
335 E. 10th STREET
ANDERSON, INDIANA 46016
1 (765) 649-0407

LEGEND

- 17 – SHEET DESIGNATION
- ——— – PROPOSED GRAVITY SEWER
- • – PROPOSED SANITARY MANHOLE
- – – – – – PROPOSED SANITARY FORCEMAIN

RECORD DRAWING

February 15, 2001

GROUND CONTROL FOR THIS SITE WAS RUN BY ACCU-AIR SURVEYS, INC.
THE VERTICAL CONTROL IS TIED INTO NAVD 88 DATUM.
THE HORIZONTAL CONTROL IS LOCAL ASSUMED

NOTE:

ADDITIONAL RIGHT-OF-WAY OR EASEMENTS MAY NEED TO BE ACQUIRED FOR INSTALLATION OF SEWER.

DON'T DIG BLIND
CALL BEFORE YOU DIG
NORTH REGION
1-800-382-5544
SOUTH REGION
1-800-428-5200

PER INDIANA STATE LAW IS-69-1991, IT IS AGAINST THE LAW TO EXCAVATE WITHOUT NOTIFYING THE UNDERGROUND LOCATION SERVICE TWO (2) WORKING DAYS BEFORE COMMENCING WORK.

NOTE: CONTRACTOR TO VERIFY ALL UTILITY LOCATIONS PRIOR TO THE START OF CONSTRUCTION

NO.	DATE	DESCRIPTION	BY

FILE NAME: SRD132_SR-RD PLOT SCALE: 1=125 PLOT DATE: 11/14

TRIAD ASSOCIATES INC.
INDIANAPOLIS, INDIANA

APPROVED BY: THOMAS W. SCHUBERT REGISTERED No. 15614 STATE OF INDIANA PROFESSIONAL ENGINEER
Thomas M. Schubert, P.E.

OLD STATE ROAD No. 132
FALL CREEK REGIONAL WASTE DISTRICT

PROJECT BASE MAP

DRAWN BY:	DATE 04/12/98	PROJECT No.	SHEET No.
DAP	SCALE AS NOTED	98008A	4 OF 19
DESIGNED BY:	D.A. Pauling		
CHECKED BY:	James W. Frazell, P.E.		

C:\Dwg\hanshard132\Record\Srd132_SR-RD.dwg, 11/14/01 02:08:39 PM, 1:125