
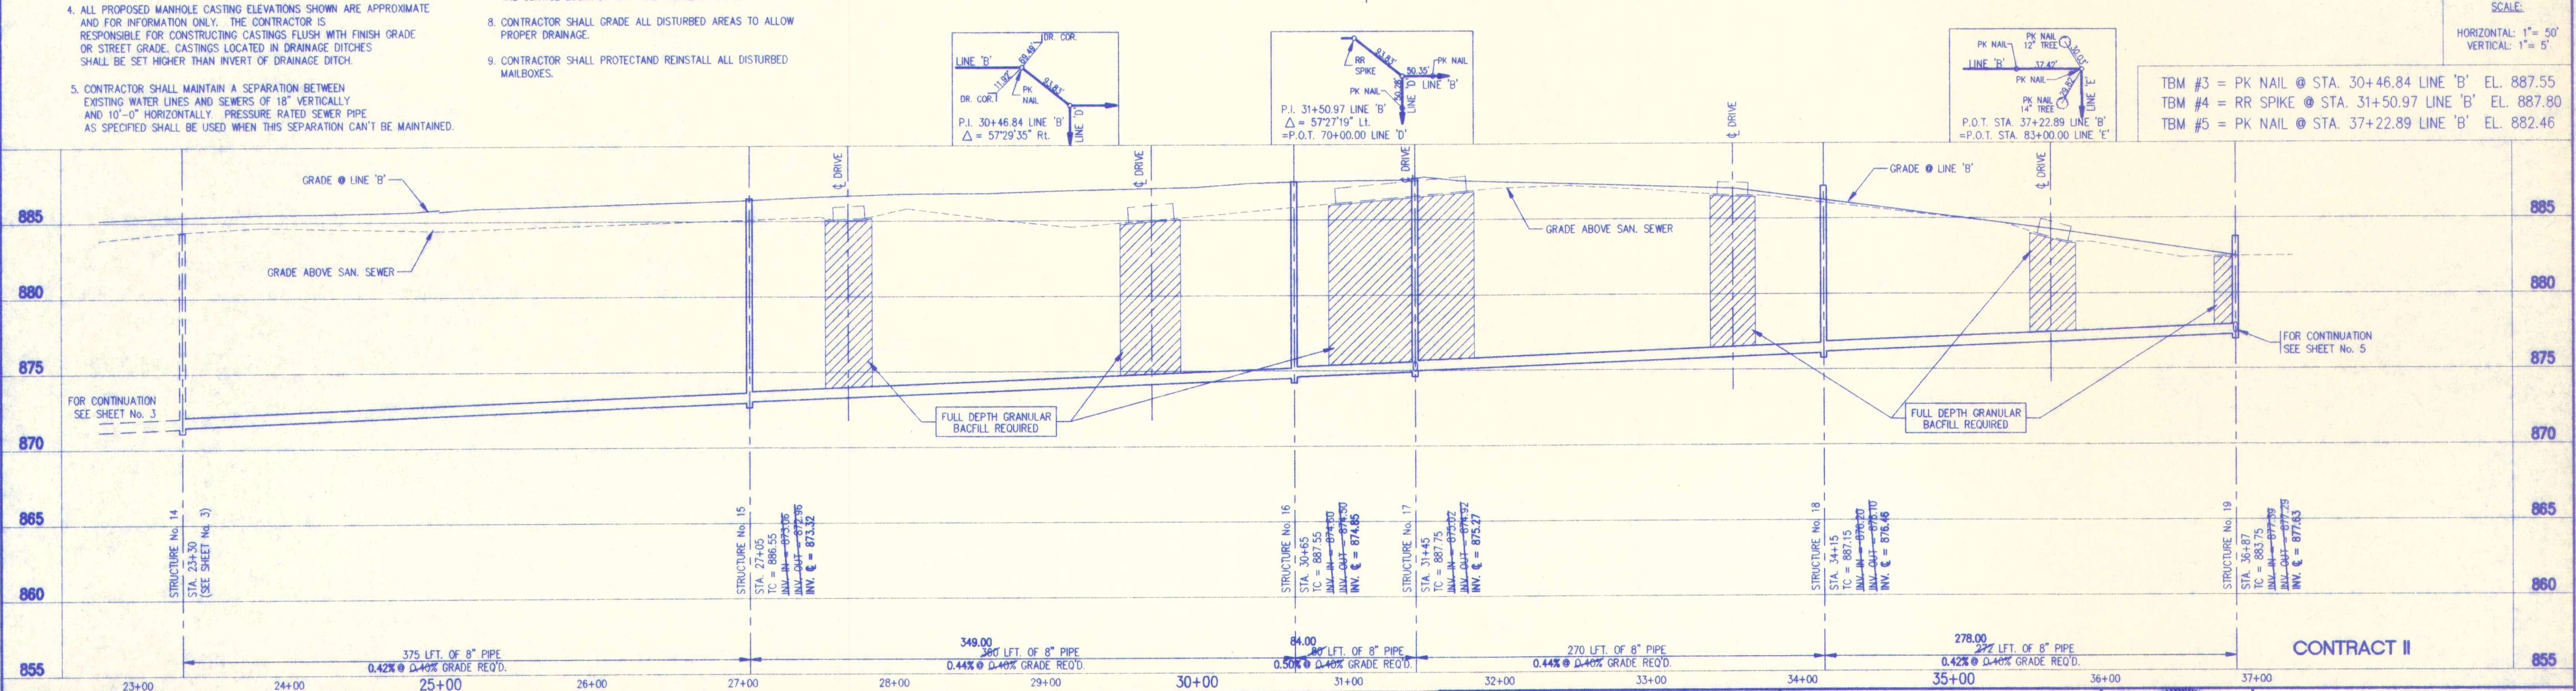


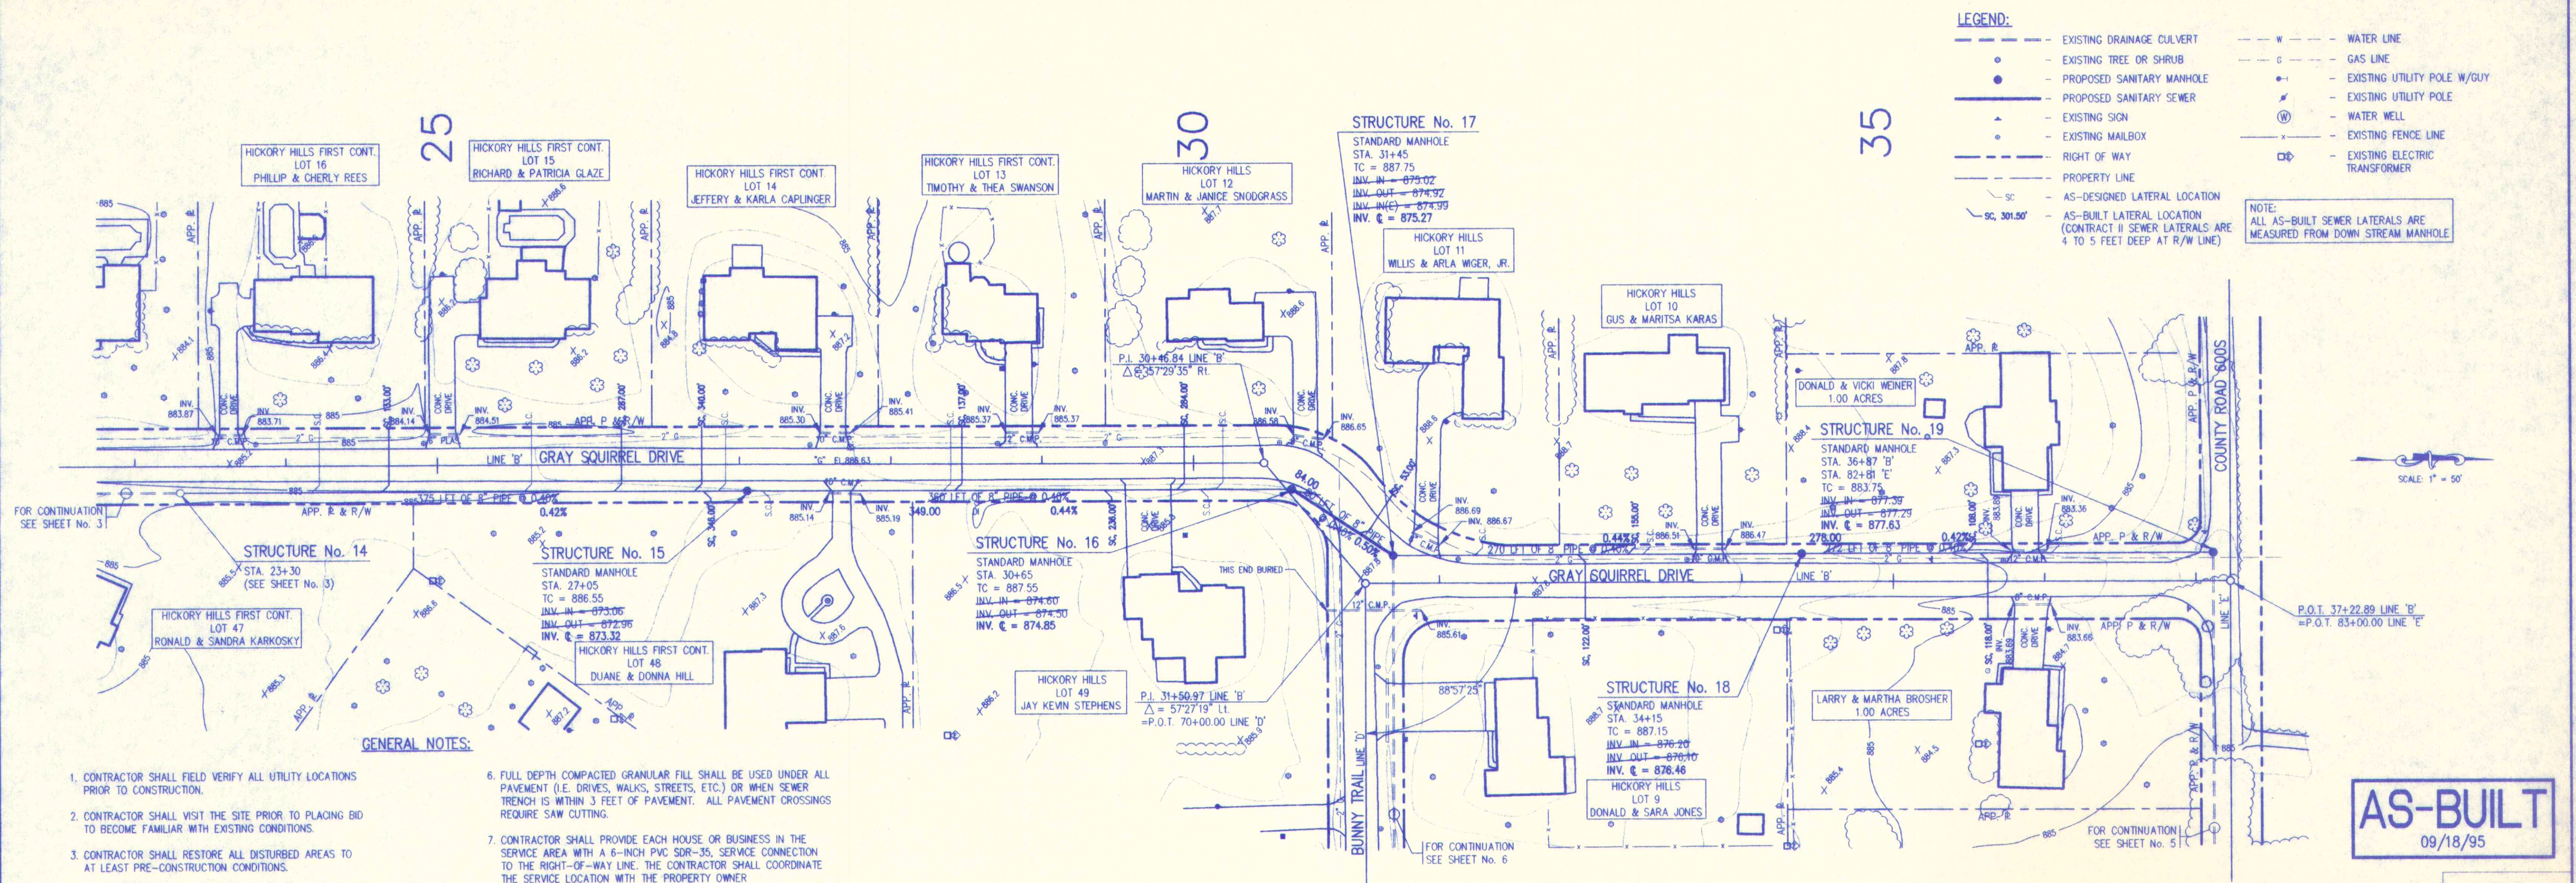

SURVEY LINE "B"

FILE NAME: 94025AB4 PLOT SCALE: 1"=50' PLOT DATE: 11/03

NO.	DATE	DESCRIPTION	BY

TRIAD ASSOCIATES INC.

INDIANAPOLIS, INDIANA

APPROVED: JAMES W. FRAZEL, REGISTERED PROFESSIONAL ENGINEER, No. 17208, STATE OF INDIANA

PROJECT No. 94025 SHEET No. 4 OF 13

DESIGNED BY: Robert P. Walker

CHECKED BY: James W. Frazel, P.E.