
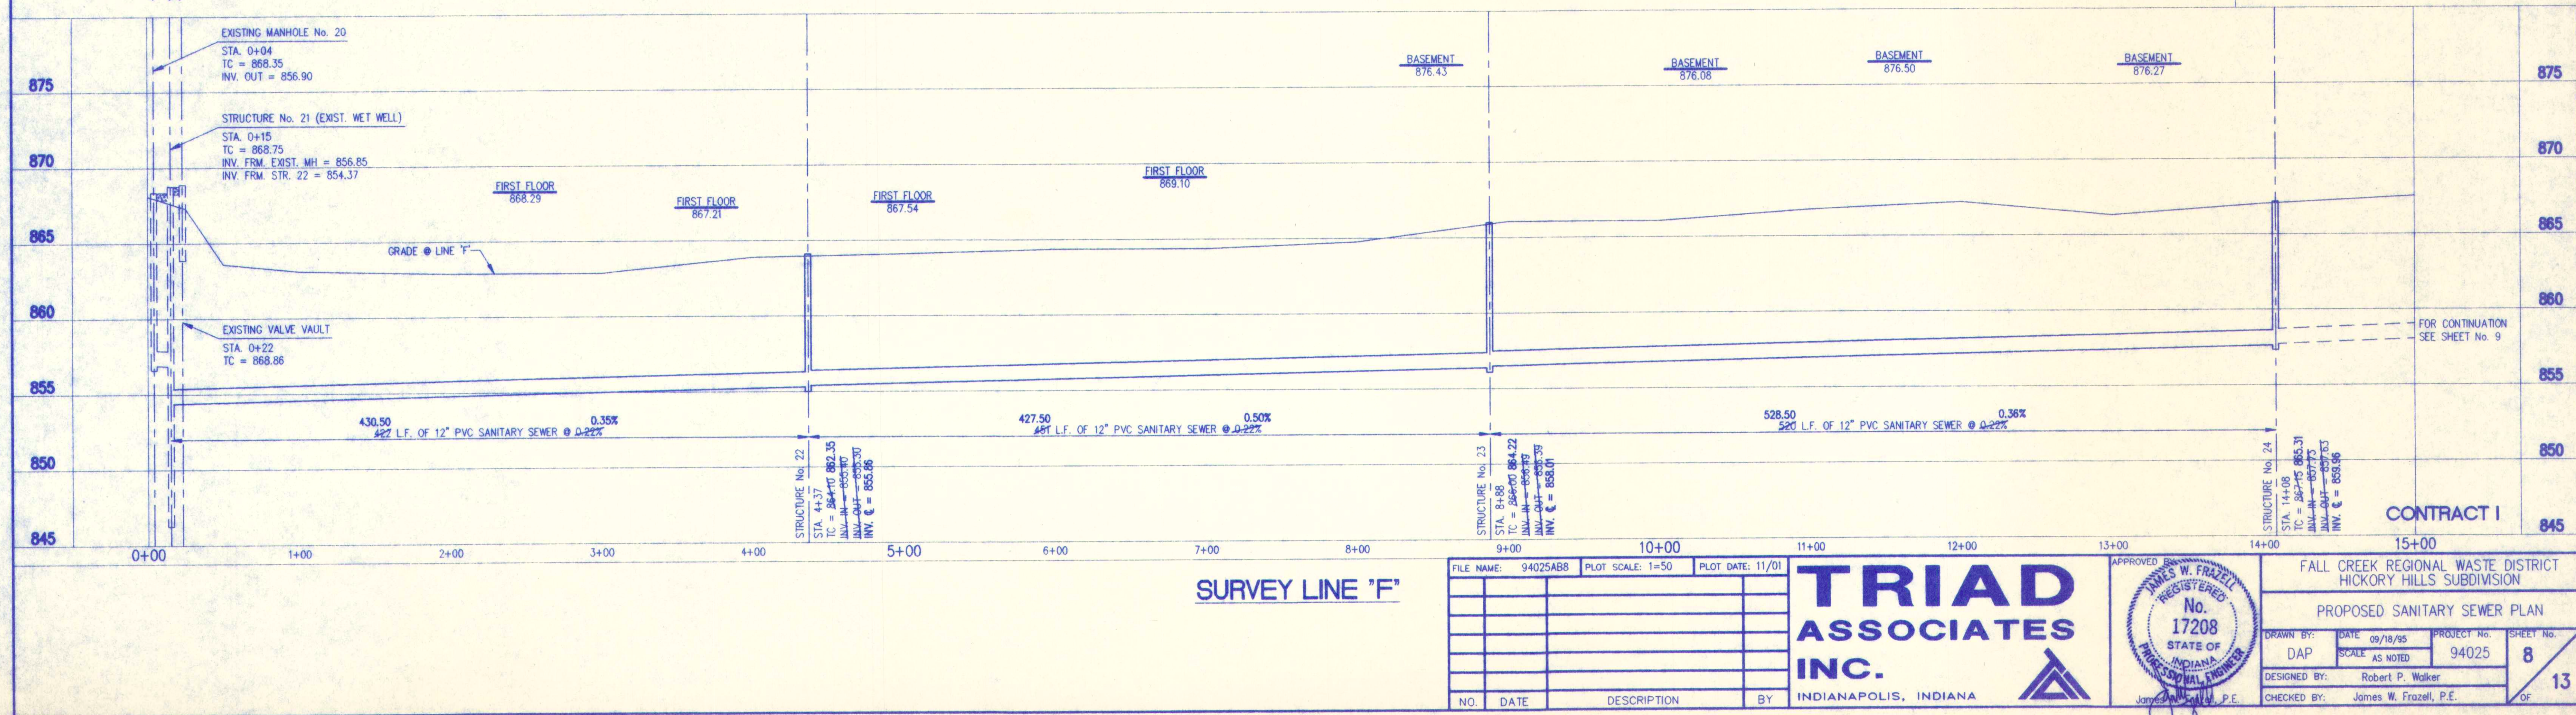


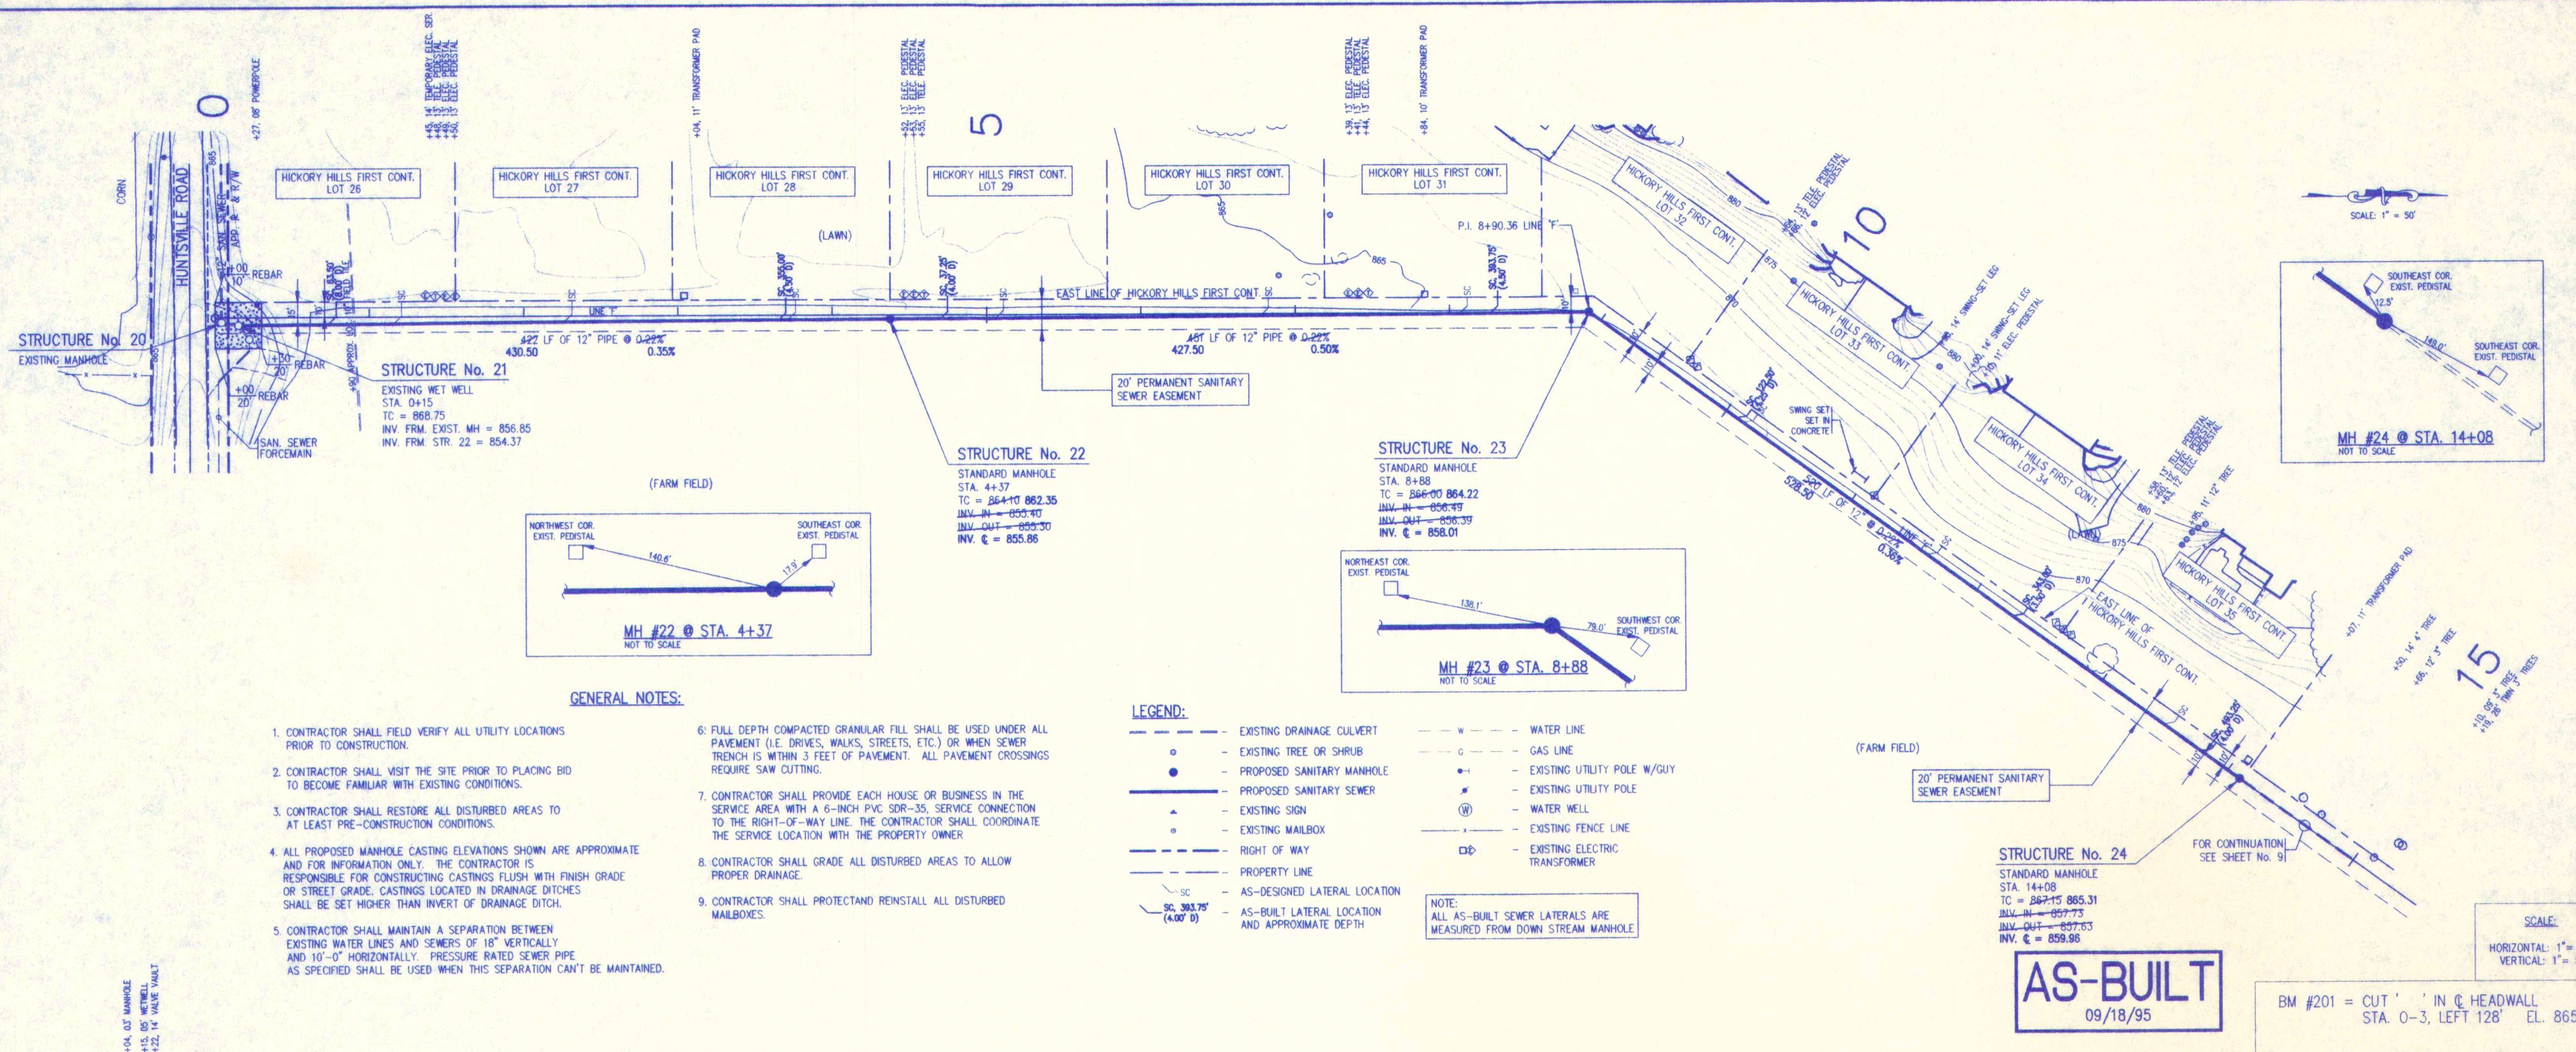

SURVEY LINE "F"

FILE NAME: 94025AB8	PLOT SCALE: 1"=50'	PLOT DATE: 11/01
TRIAD ASSOCIATES INC. INDIANAPOLIS, INDIANA		
APPROVED BY: JAMES W. FRAZELL REGISTERED No. 17208 STATE OF INDIANA PROFESSIONAL ENGINEER		
FALL CREEK REGIONAL WASTE DISTRICT HICKORY HILLS SUBDIVISION PROPOSED SANITARY SEWER PLAN		
DRAWN BY: DAP SCALE: AS NOTED DESIGNED BY: Robert P. Walker CHECKED BY: James W. Frazell, P.E.	PROJECT No. 94025 SHEET No. 8 OF 13	DATE: 09/18/95 PROJECT No. 94025 SHEET No. 8 OF 13