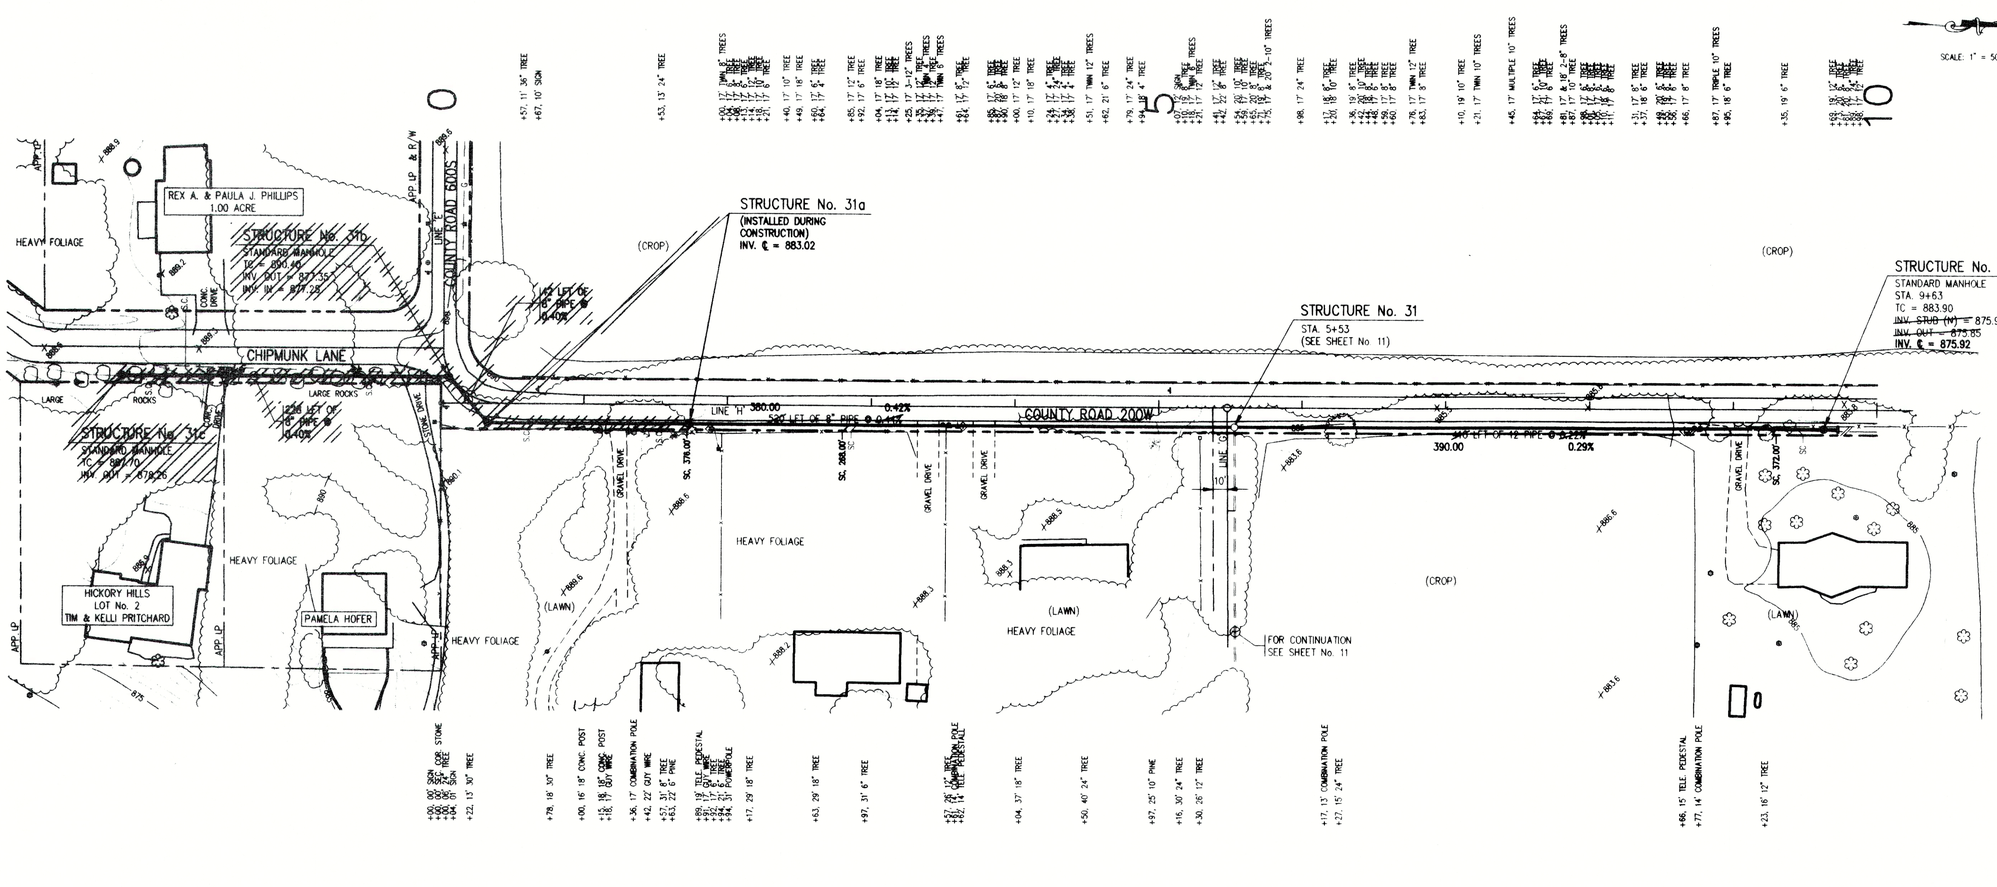

LEGEND:

- EXISTING DRAINAGE CULVERT
- EXISTING TREE OR SHRUB
- PROPOSED SANITARY MANHOLE
- PROPOSED SANITARY SEWER
- EXISTING SIGN
- EXISTING MAILBOX
- RIGHT OF WAY
- PROPERTY LINE
- W — WATER LINE
- G — GAS LINE
- EXISTING UTILITY POLE W/GUY
- EXISTING UTILITY POLE
- (W) WATER WELL
- EXISTING FENCE LINE
- EXISTING ELECTRIC TRANSFORMER
- SC — AS-DESIGNED LATERAL LOCATION
- SC. 301.50' — AS-BUILT LATERAL LOCATION (CONTRACT II SEWER LATERALS ARE 4 TO 5 FEET DEEP AT R/W LINE)

NOTE:
ALL AS-BUILT SEWER LATERALS ARE MEASURED FROM DOWN STREAM MANHOLE

GENERAL NOTES:

1. CONTRACTOR SHALL FIELD VERIFY ALL UTILITY LOCATIONS PRIOR TO CONSTRUCTION.
2. CONTRACTOR SHALL VISIT THE SITE PRIOR TO PLACING BID TO BECOME FAMILIAR WITH EXISTING CONDITIONS.
3. CONTRACTOR SHALL RESTORE ALL DISTURBED AREAS TO AT LEAST PRE-CONSTRUCTION CONDITIONS.
4. ALL PROPOSED MANHOLE CASTING ELEVATIONS SHOWN ARE APPROXIMATE AND FOR INFORMATION ONLY. THE CONTRACTOR IS RESPONSIBLE FOR CONSTRUCTING CASTINGS FLUSH WITH FINISH GRADE OR STREET GRADE. CASTINGS LOCATED IN DRAINAGE DITCHES SHALL BE SET HIGHER THAN INVERT OF DRAINAGE DITCH.
5. CONTRACTOR SHALL MAINTAIN A SEPARATION BETWEEN EXISTING WATER LINES AND SEWERS OF 18" VERTICALLY AND 10'-0" HORIZONTALLY. PRESSURE RATED SEWER PIPE AS SPECIFIED SHALL BE USED WHEN THIS SEPARATION CAN'T BE MAINTAINED.
6. FULL DEPTH COMPACTED GRANULAR FILL SHALL BE USED UNDER ALL PAVEMENT (I.E. DRIVES, WALKS, STREETS, ETC.) OR WHEN SEWER TRENCH IS WITHIN 3 FEET OF PAVEMENT. ALL PAVEMENT CROSSINGS REQUIRE SAW CUTTING.
7. CONTRACTOR SHALL PROVIDE EACH HOUSE OR BUSINESS IN THE SERVICE AREA WITH A 6-INCH PVC SDR-35, SERVICE CONNECTION TO THE RIGHT-OF-WAY LINE. THE CONTRACTOR SHALL COORDINATE THE SERVICE LOCATION WITH THE PROPERTY OWNER
8. CONTRACTOR SHALL GRADE ALL DISTURBED AREAS TO ALLOW PROPER DRAINAGE.
9. CONTRACTOR SHALL PROTECTAND REINSTALL ALL DISTURBED MAILBOXES.

AS-BUILT
09/18/95

SCALE:
HORIZONTAL: 1"= 50'
VERTICAL: 1"= 5'

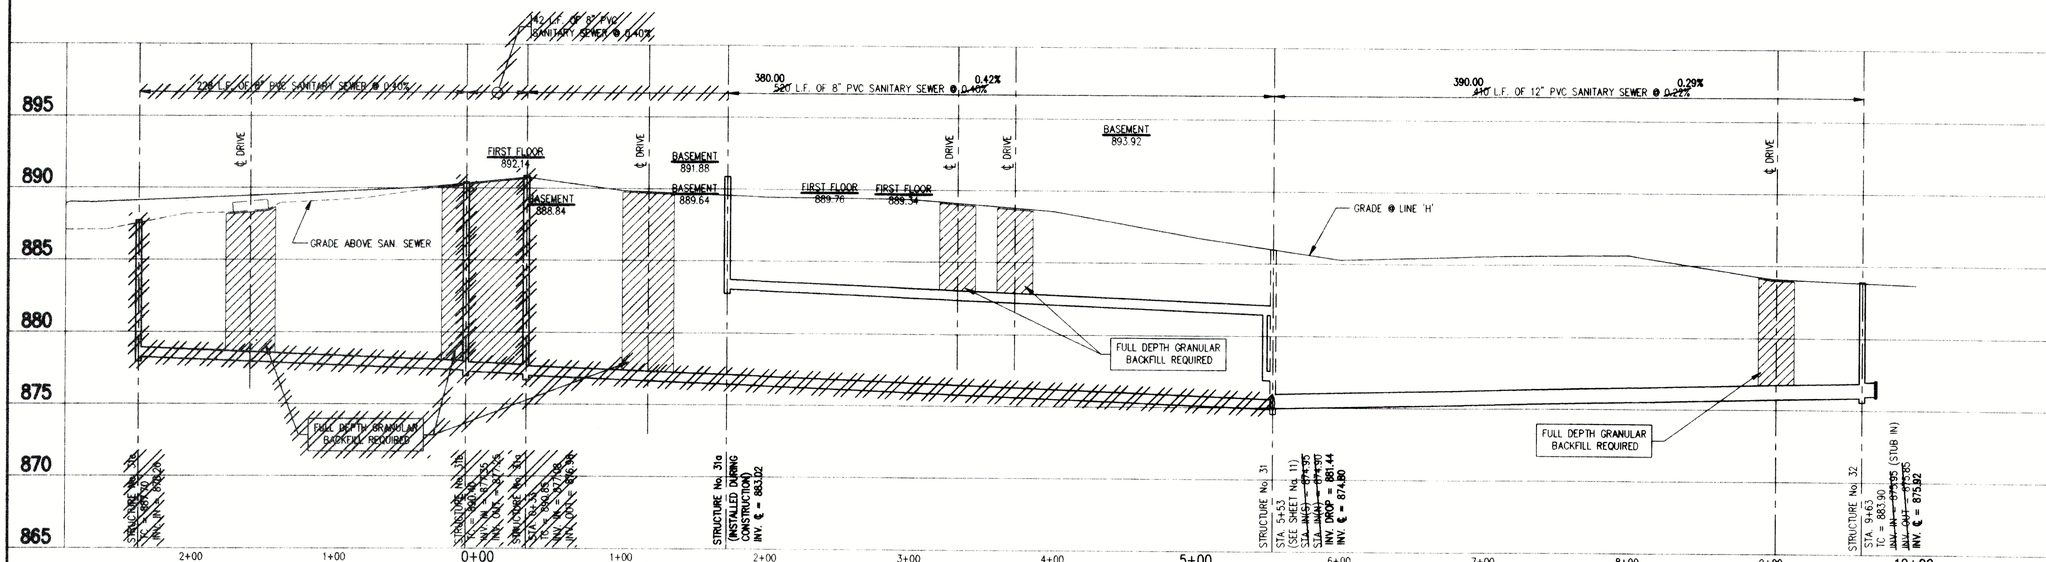

SURVEY LINE "H"

CONTRACT II

NO.	DATE	DESCRIPTION	BY

FILE NAME: 94025B12 | PLOT SCALE: 1=50 | PLOT DATE: 11/02

TRIAD ASSOCIATES INC.
INDIANAPOLIS, INDIANA

APPROVED
JAMES W. FRAZELL REGISTERED No. 17208 STATE OF INDIANA PROFESSIONAL ENGINEER
James W. Frazell, P.E.

FALL CREEK REGIONAL WASTE DISTRICT
HICKORY HILLS SUBDIVISION
PROPOSED SANITARY SEWER PLAN

DRAWN BY:	DATE	PROJECT No.	SHEET No.
DAP	04/20/94	94025	12
	SCALE: AS NOTED		OF 13

DESIGNED BY: Robert P. Walker
CHECKED BY: James W. Frazell, P.E.