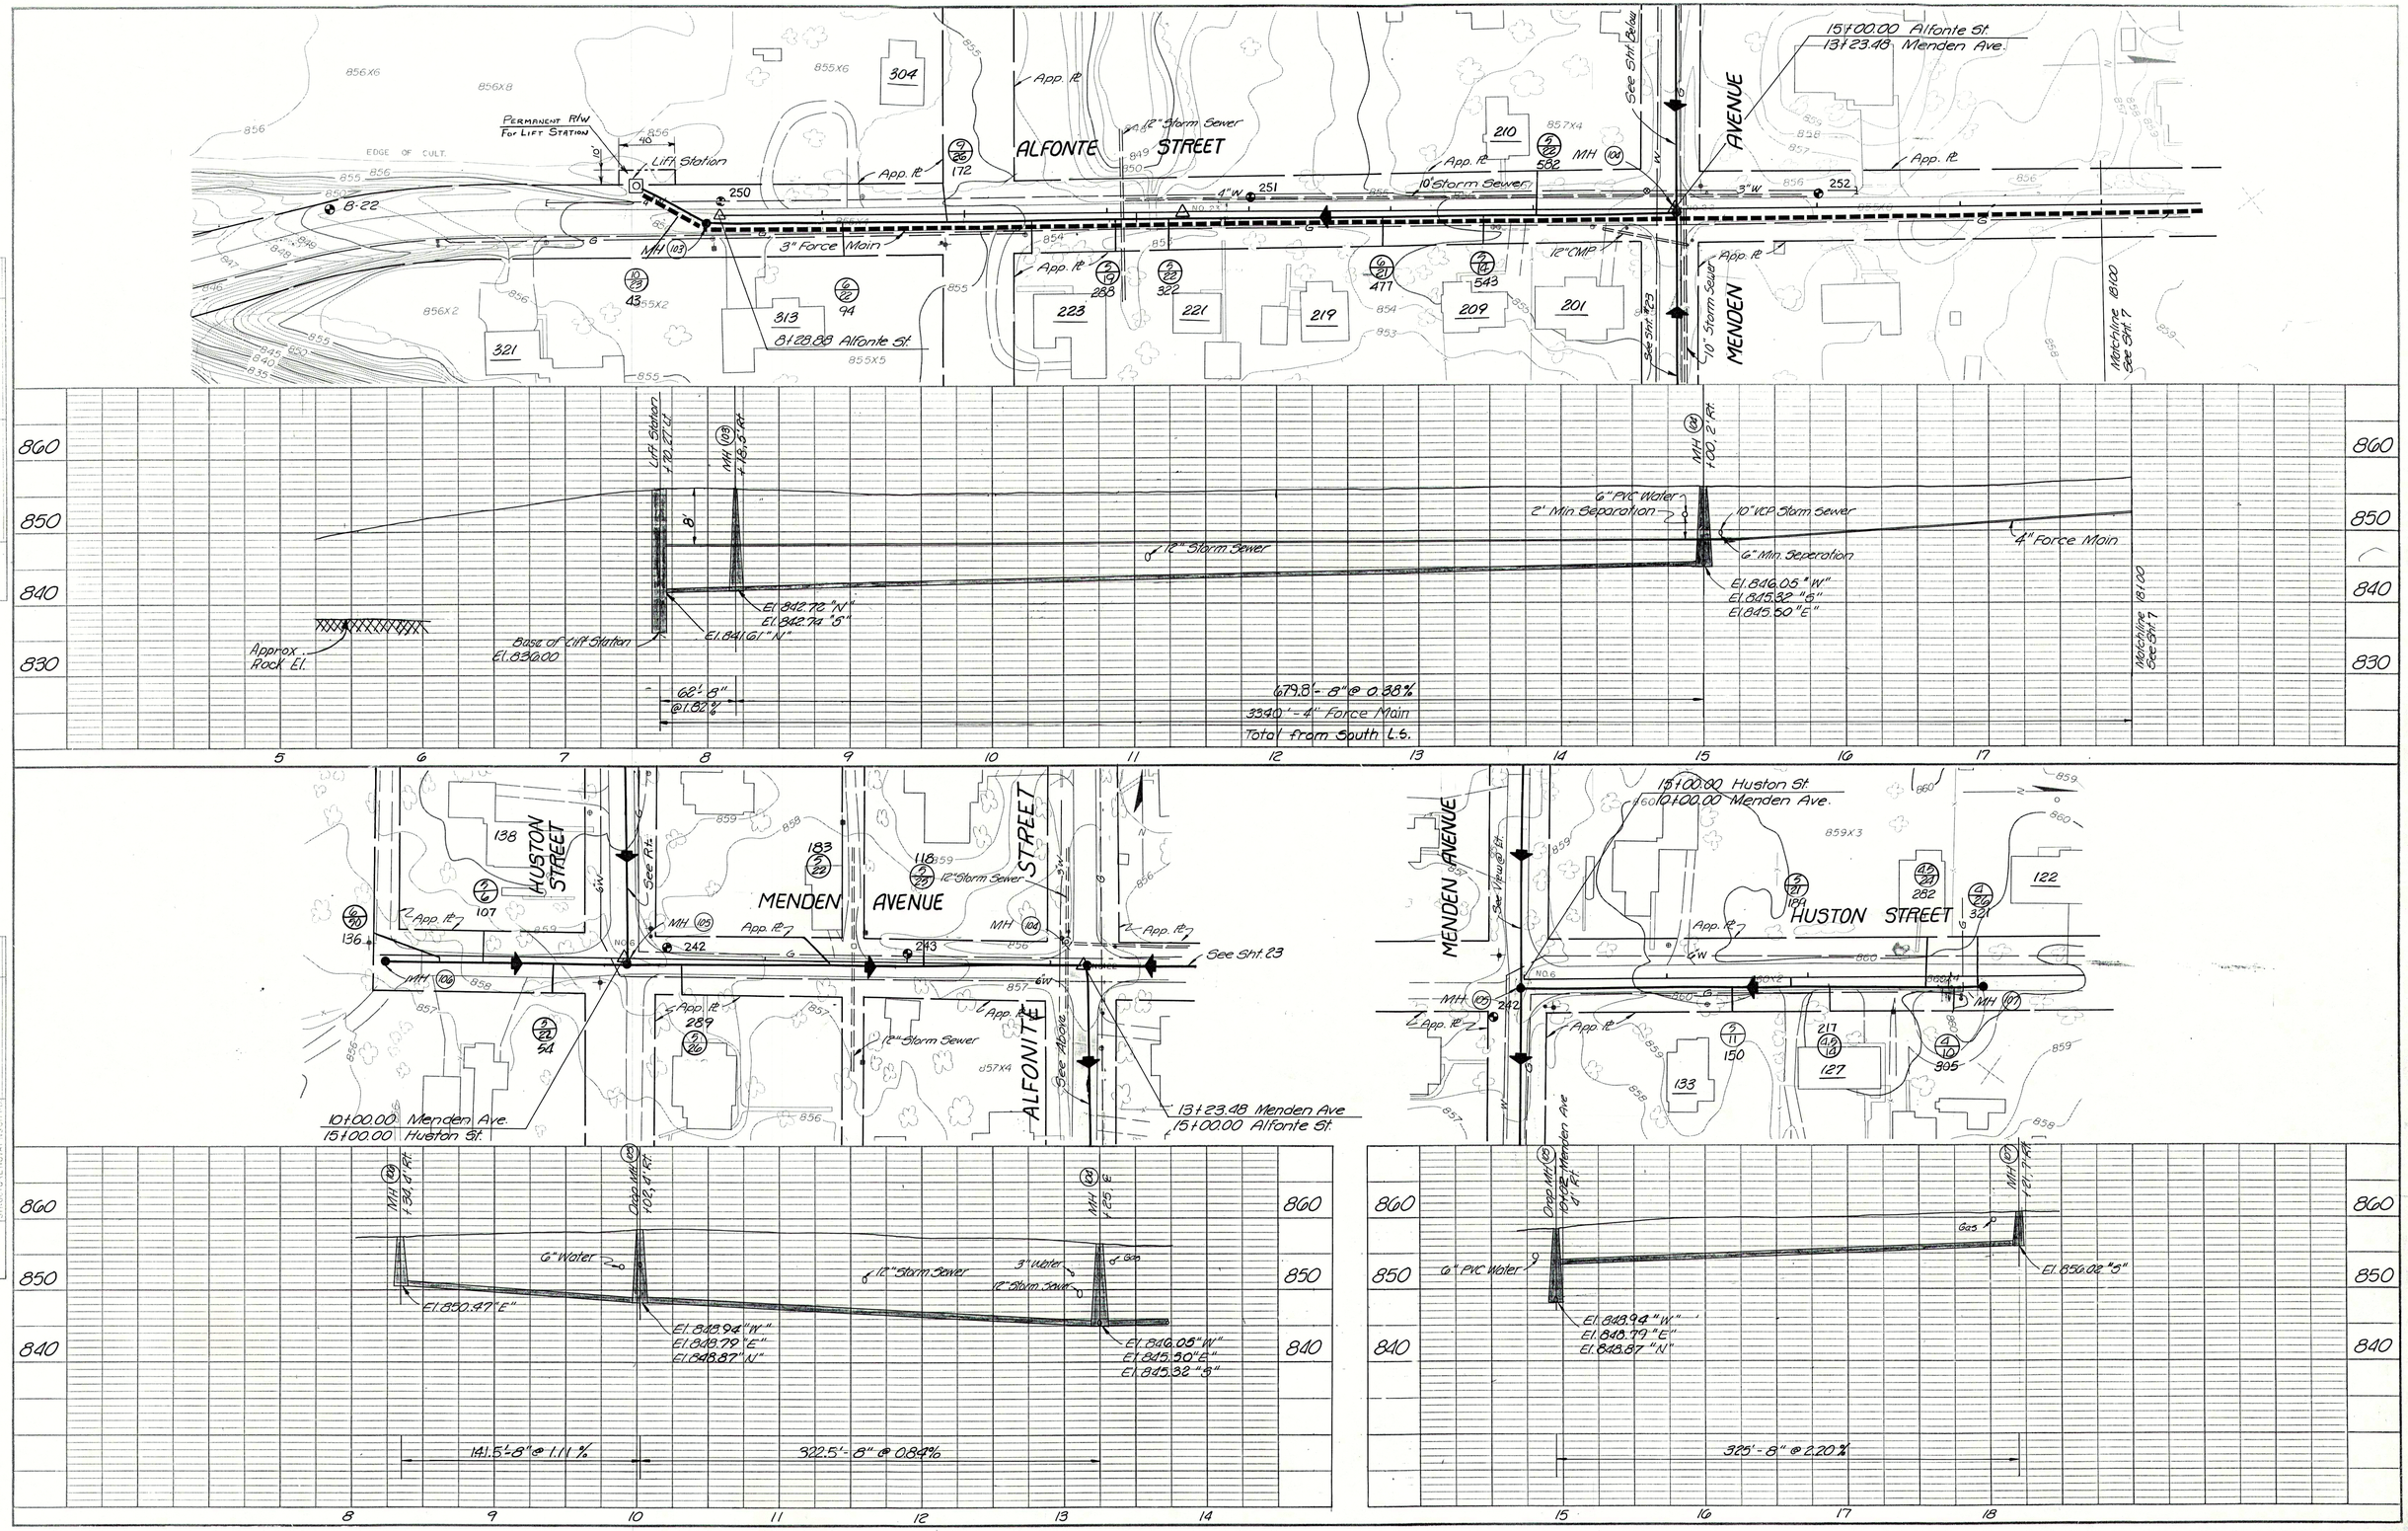

PLAN — SURVEYED, PLOTTED, GRADES CHECKED, ALIGNMENT CHECKED, PT. OF WAY CHECKED, NOTE BOOK NO.

PROFILE — SURVEYED, PLOTTED, GRADES CHECKED, BY WITTEN, STRUCTURE INTAT'N SCHED, NOTE BOOK NO.

RECORD DRAWING

ERIC RESKE — REGISTERED — No. 13442 — 3-30-83 — STATE OF INDIANA — PROFESSIONAL ENGINEER

ALFONTE ST. MENDEN AVE. HUSTON ST.

FALL CREEK R.W.D. PLAN & PROFILE

HORIZ. 1"=50'

VERT. 1"=10'

BEAM, LONGEST & NEFF, INC.
CONSULTING ENGINEERS
INDIANAPOLIS, INDIANA

SHEET 21