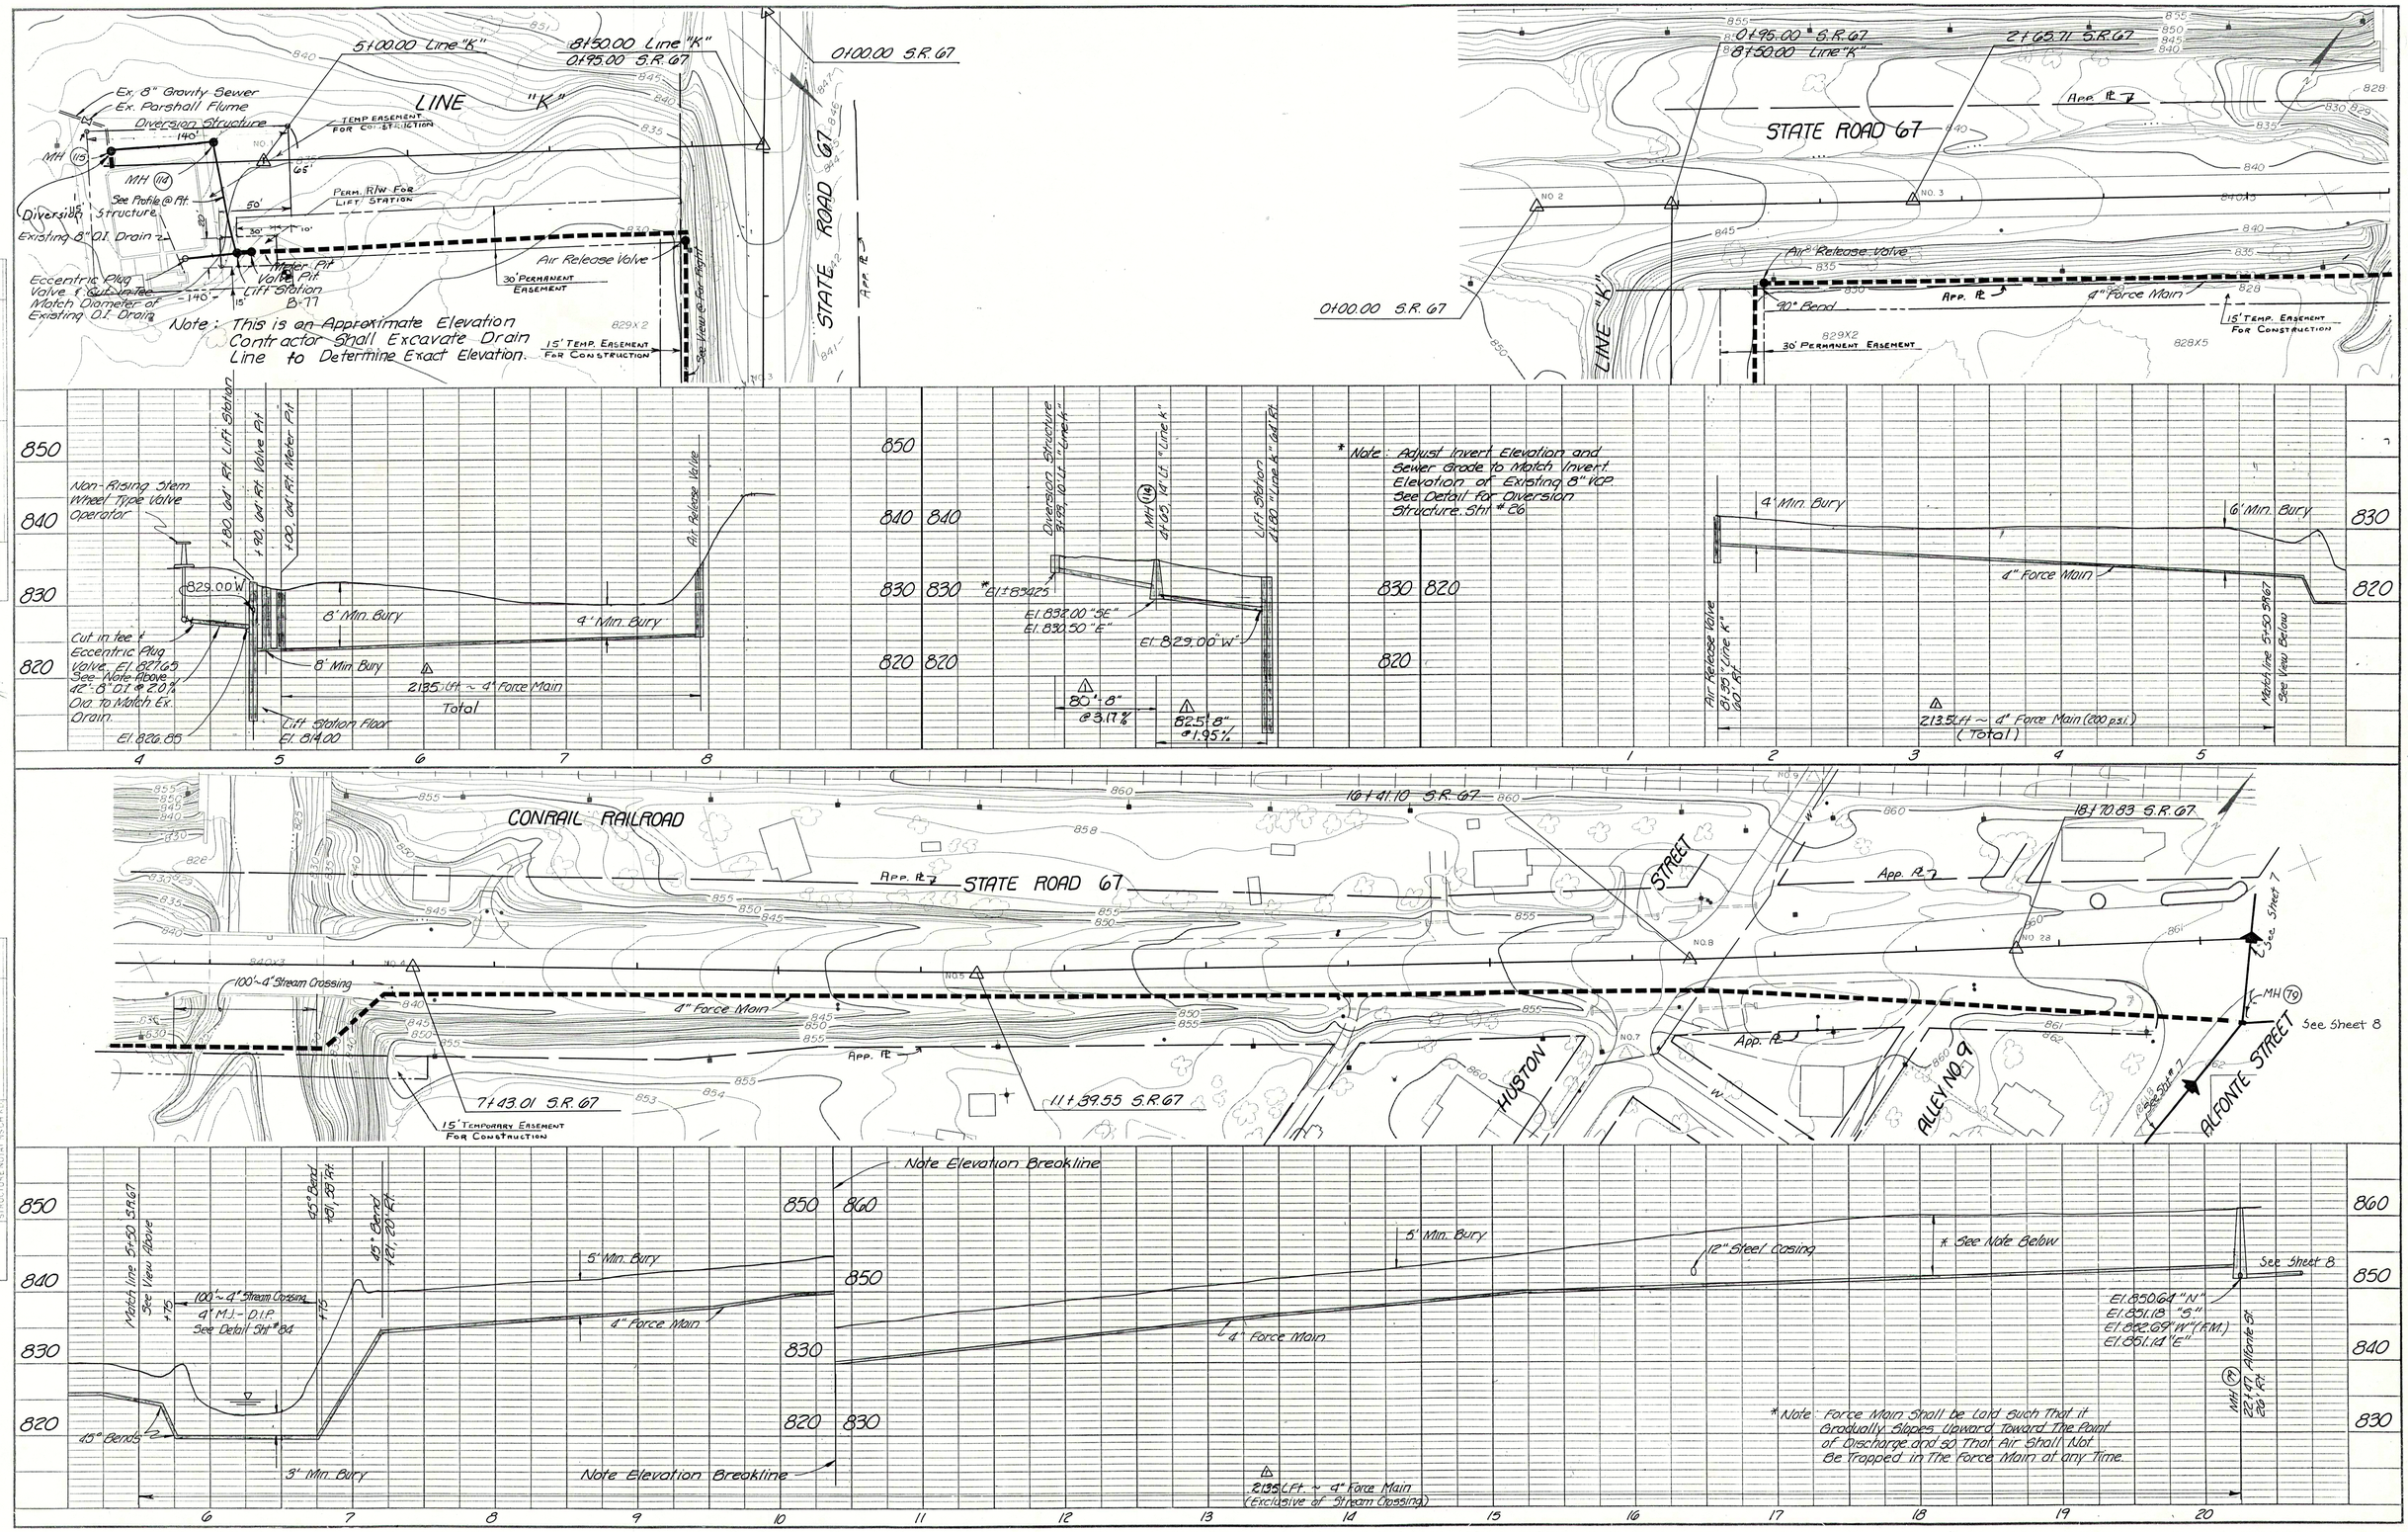

PLAN
SURVEYED
PLOTTED
GRADES CHECKED
ALIGNMENT CHECKED
RT. OF WAY CHECKED
NOTE BOOK
NO.
BY
DATE

PROFILE
SURVEYED
PLOTTED
GRADES CHECKED
B. M. NOTED
STRUCTURE NOTAT'NS CHKD.
NOTE BOOK
NO.
BY
DATE

△ Total all 4" F.M. this sec. 2135'

RECORD DRAWING

△ Revised 4-17-86

ERIC RESKE REGISTERED No. 13442 3-30-83 STATE OF INDIANA PROFESSIONAL ENGINEER

STATE ROAD 67 & LINE "K"		
FALL CREEK R.W.D. PLAN & PROFILE		SHEET
HORIZ. 1"=50'	BEAM, LONGEST & NEFF, INC. CONSULTING ENGINEERS INDIANAPOLIS, INDIANA	24
VERT. 1"=10'		