


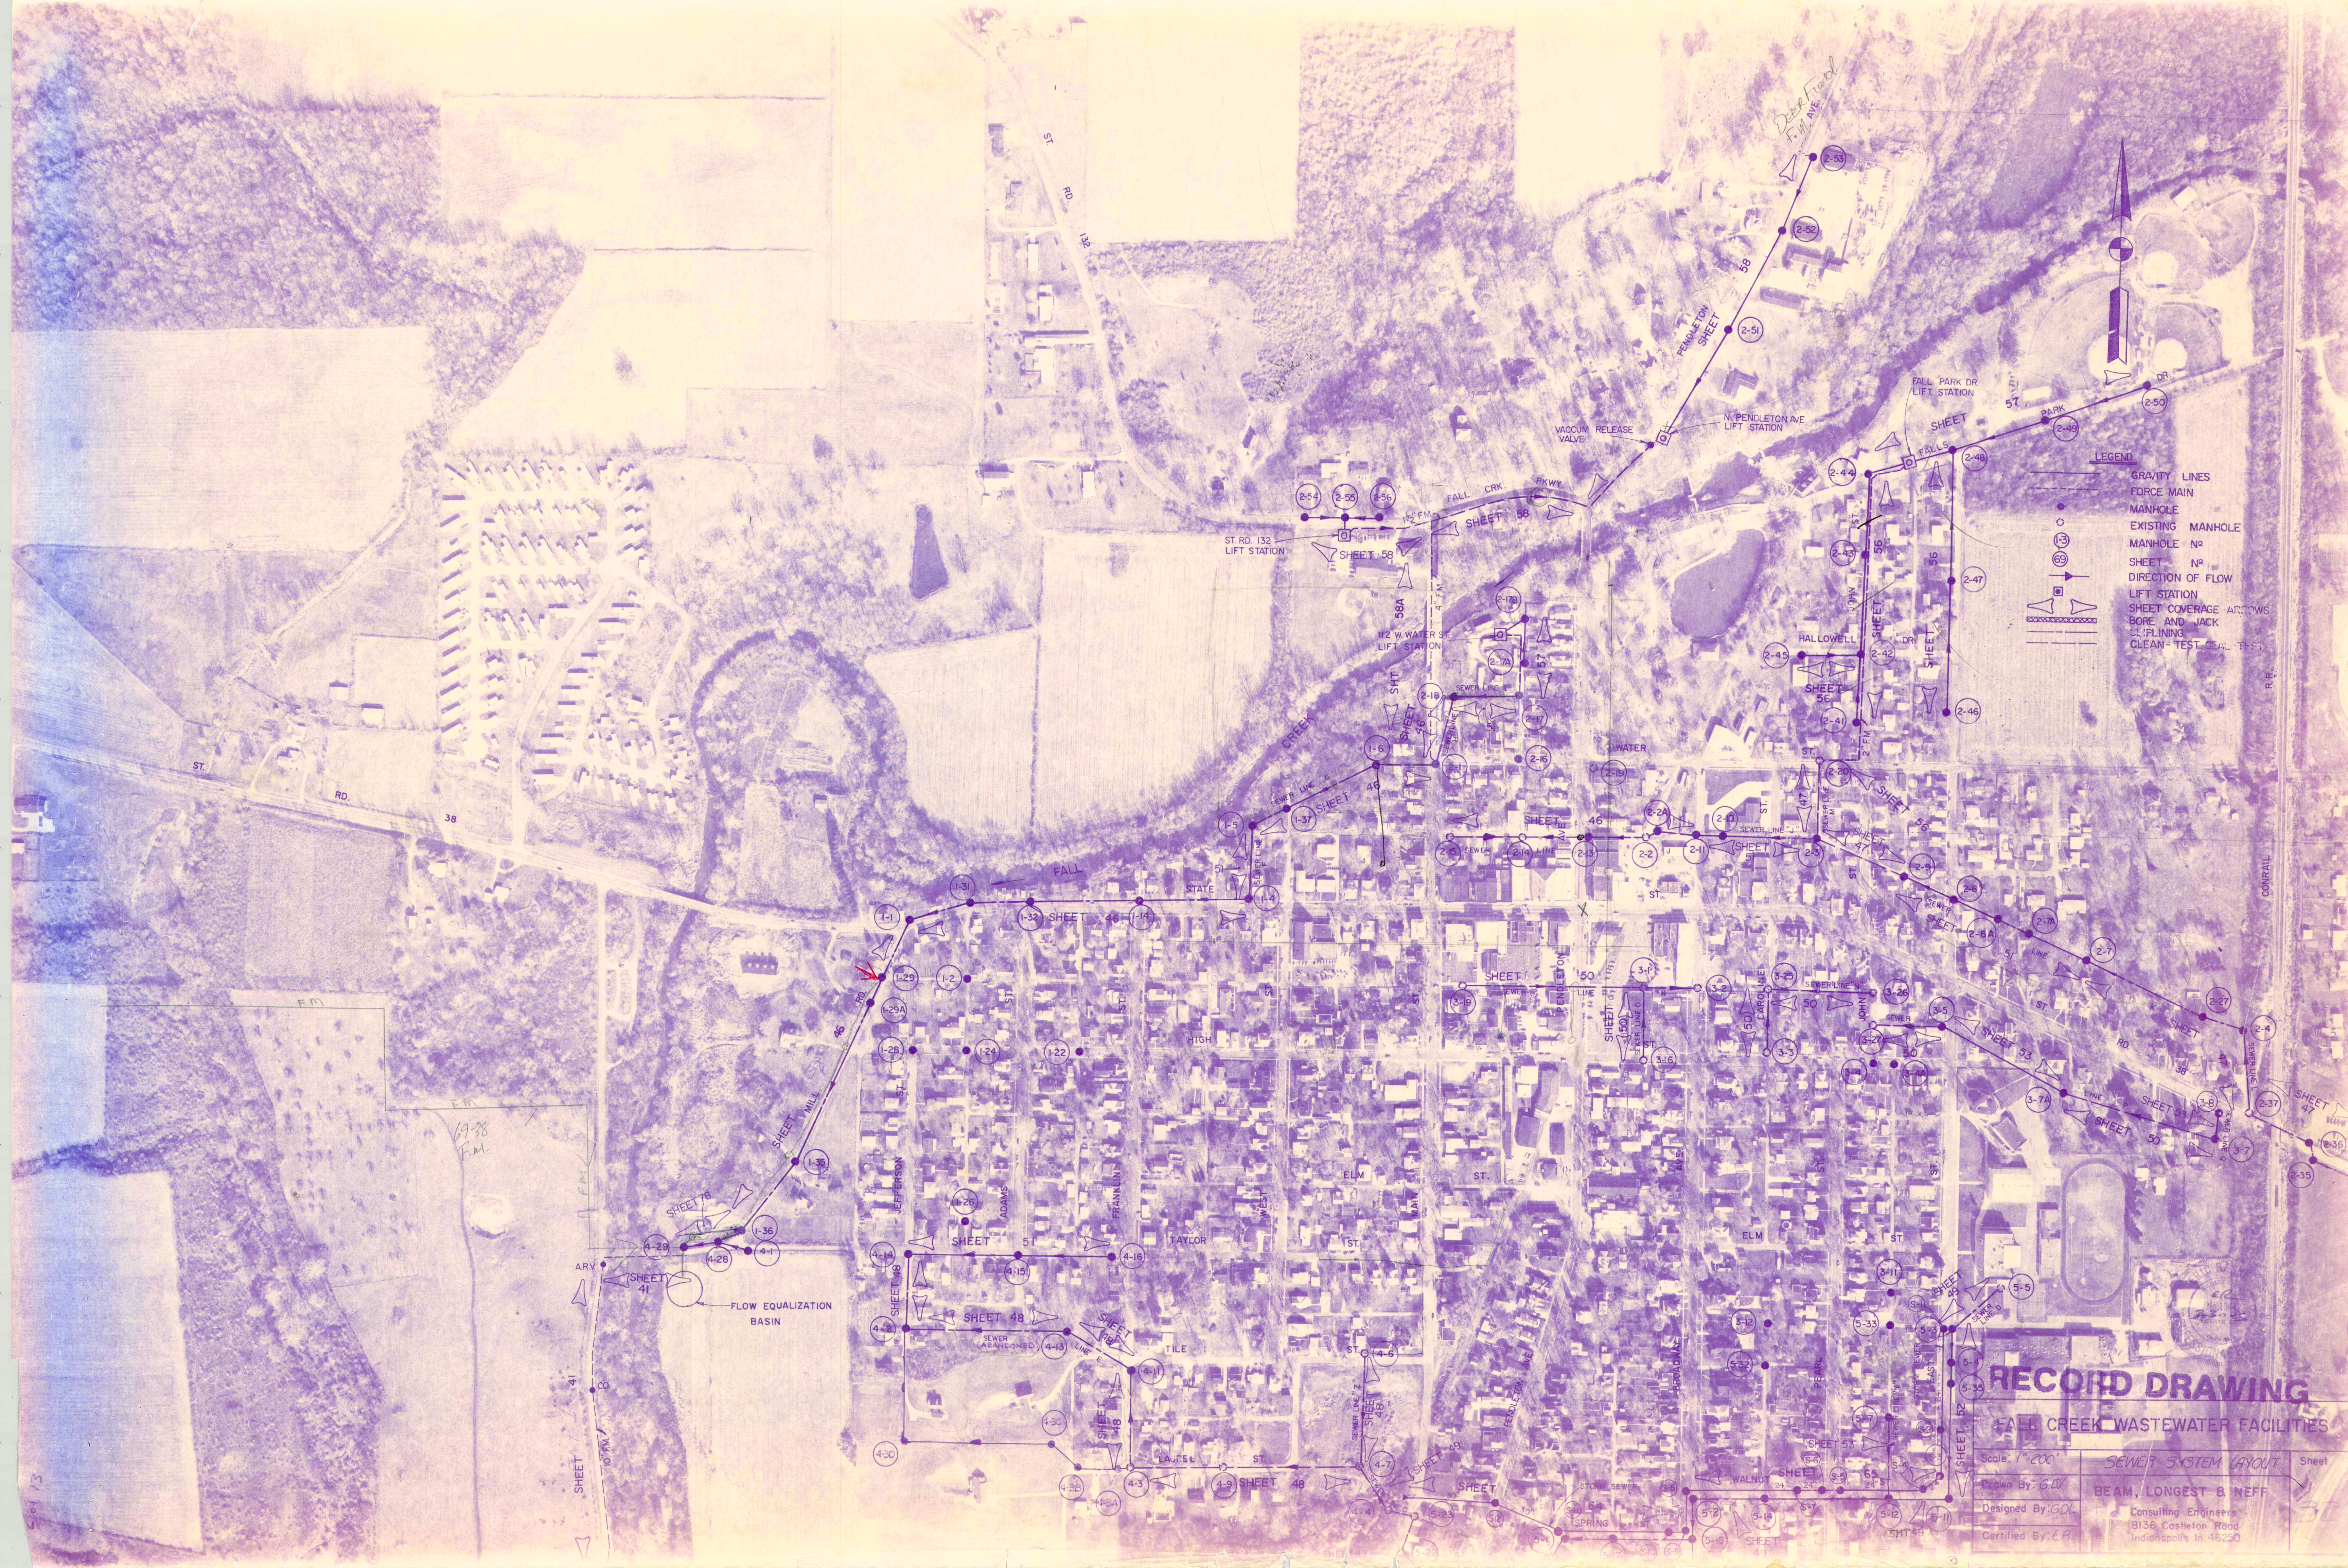

RECORD DRAWING
FALL CREEK WASTEWATER FACILITIES

Scale: 1"=200'
Drawn By: G.D.
Designed By: G.D.
Certified By: E.R.

SEWER SYSTEM LAYOUT

BEAM, LONGEST & NEFF
Consulting Engineers
8136 Castleton Road
Indianapolis, IN 46250

Sheet 13