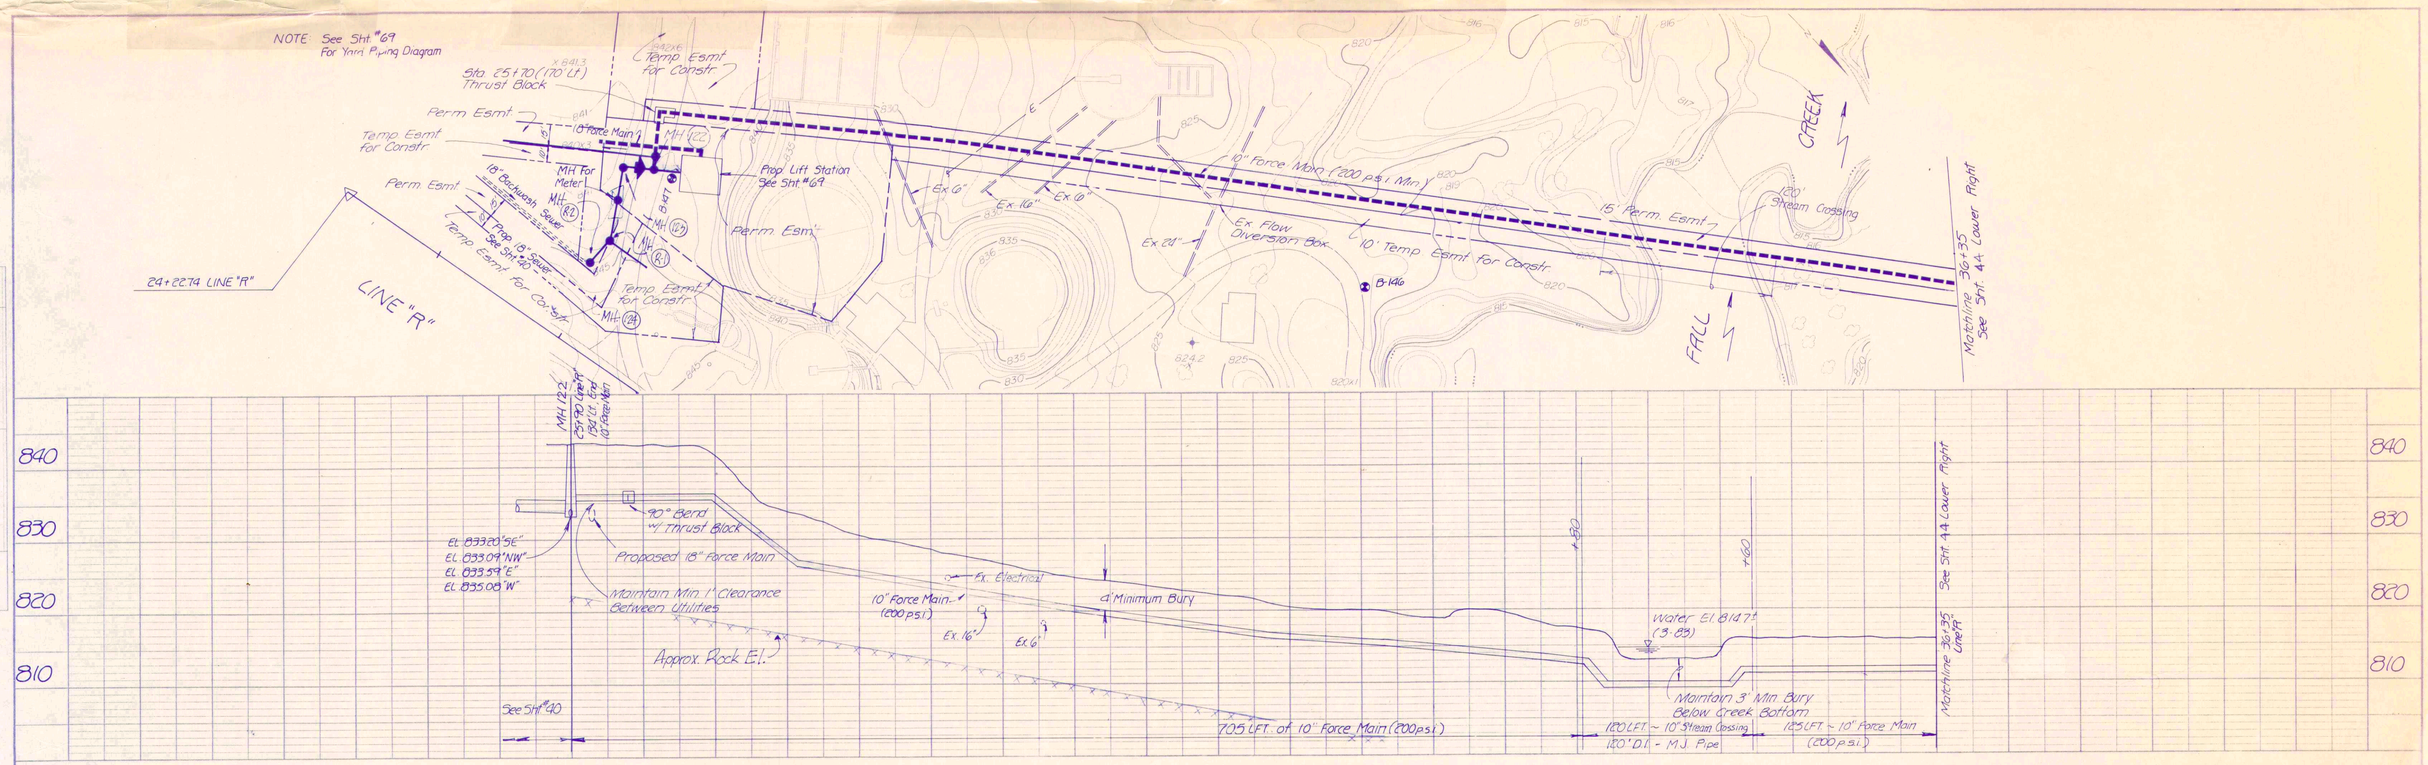

REVISED 3-19-94
CHANGED PERM R/W
TO PERM ESMT

9458
+120
9578

PLAN
SURVEYED
PLOTTED
NOTE BOOK
ALIGNMENT CHECKED
RT. OF WAY CHECKED
NO.
BY
DATE

PROFILE
SURVEYED
PLOTTED
NOTE BOOK
PROFILE CHECKED
B.M. NOTED
STRUCTURE NOTATIONS CHKD.
NO.
BY
DATE

RECORD DRAWING

ERIC KESKE
REGISTERED
No. 17337
STATE OF
INDIANA
PROFESSIONAL ENGINEER

LINE "R"
FALL CREEK R.W.D. PLAN & PROFILE
HORIZ. 1" = 50'
VERT. 1" = 10'
BEAM, LONGEST & NEFF, INC.
CONSULTING ENGINEERS
INDIANAPOLIS, INDIANA
SHEET 45

FM-5