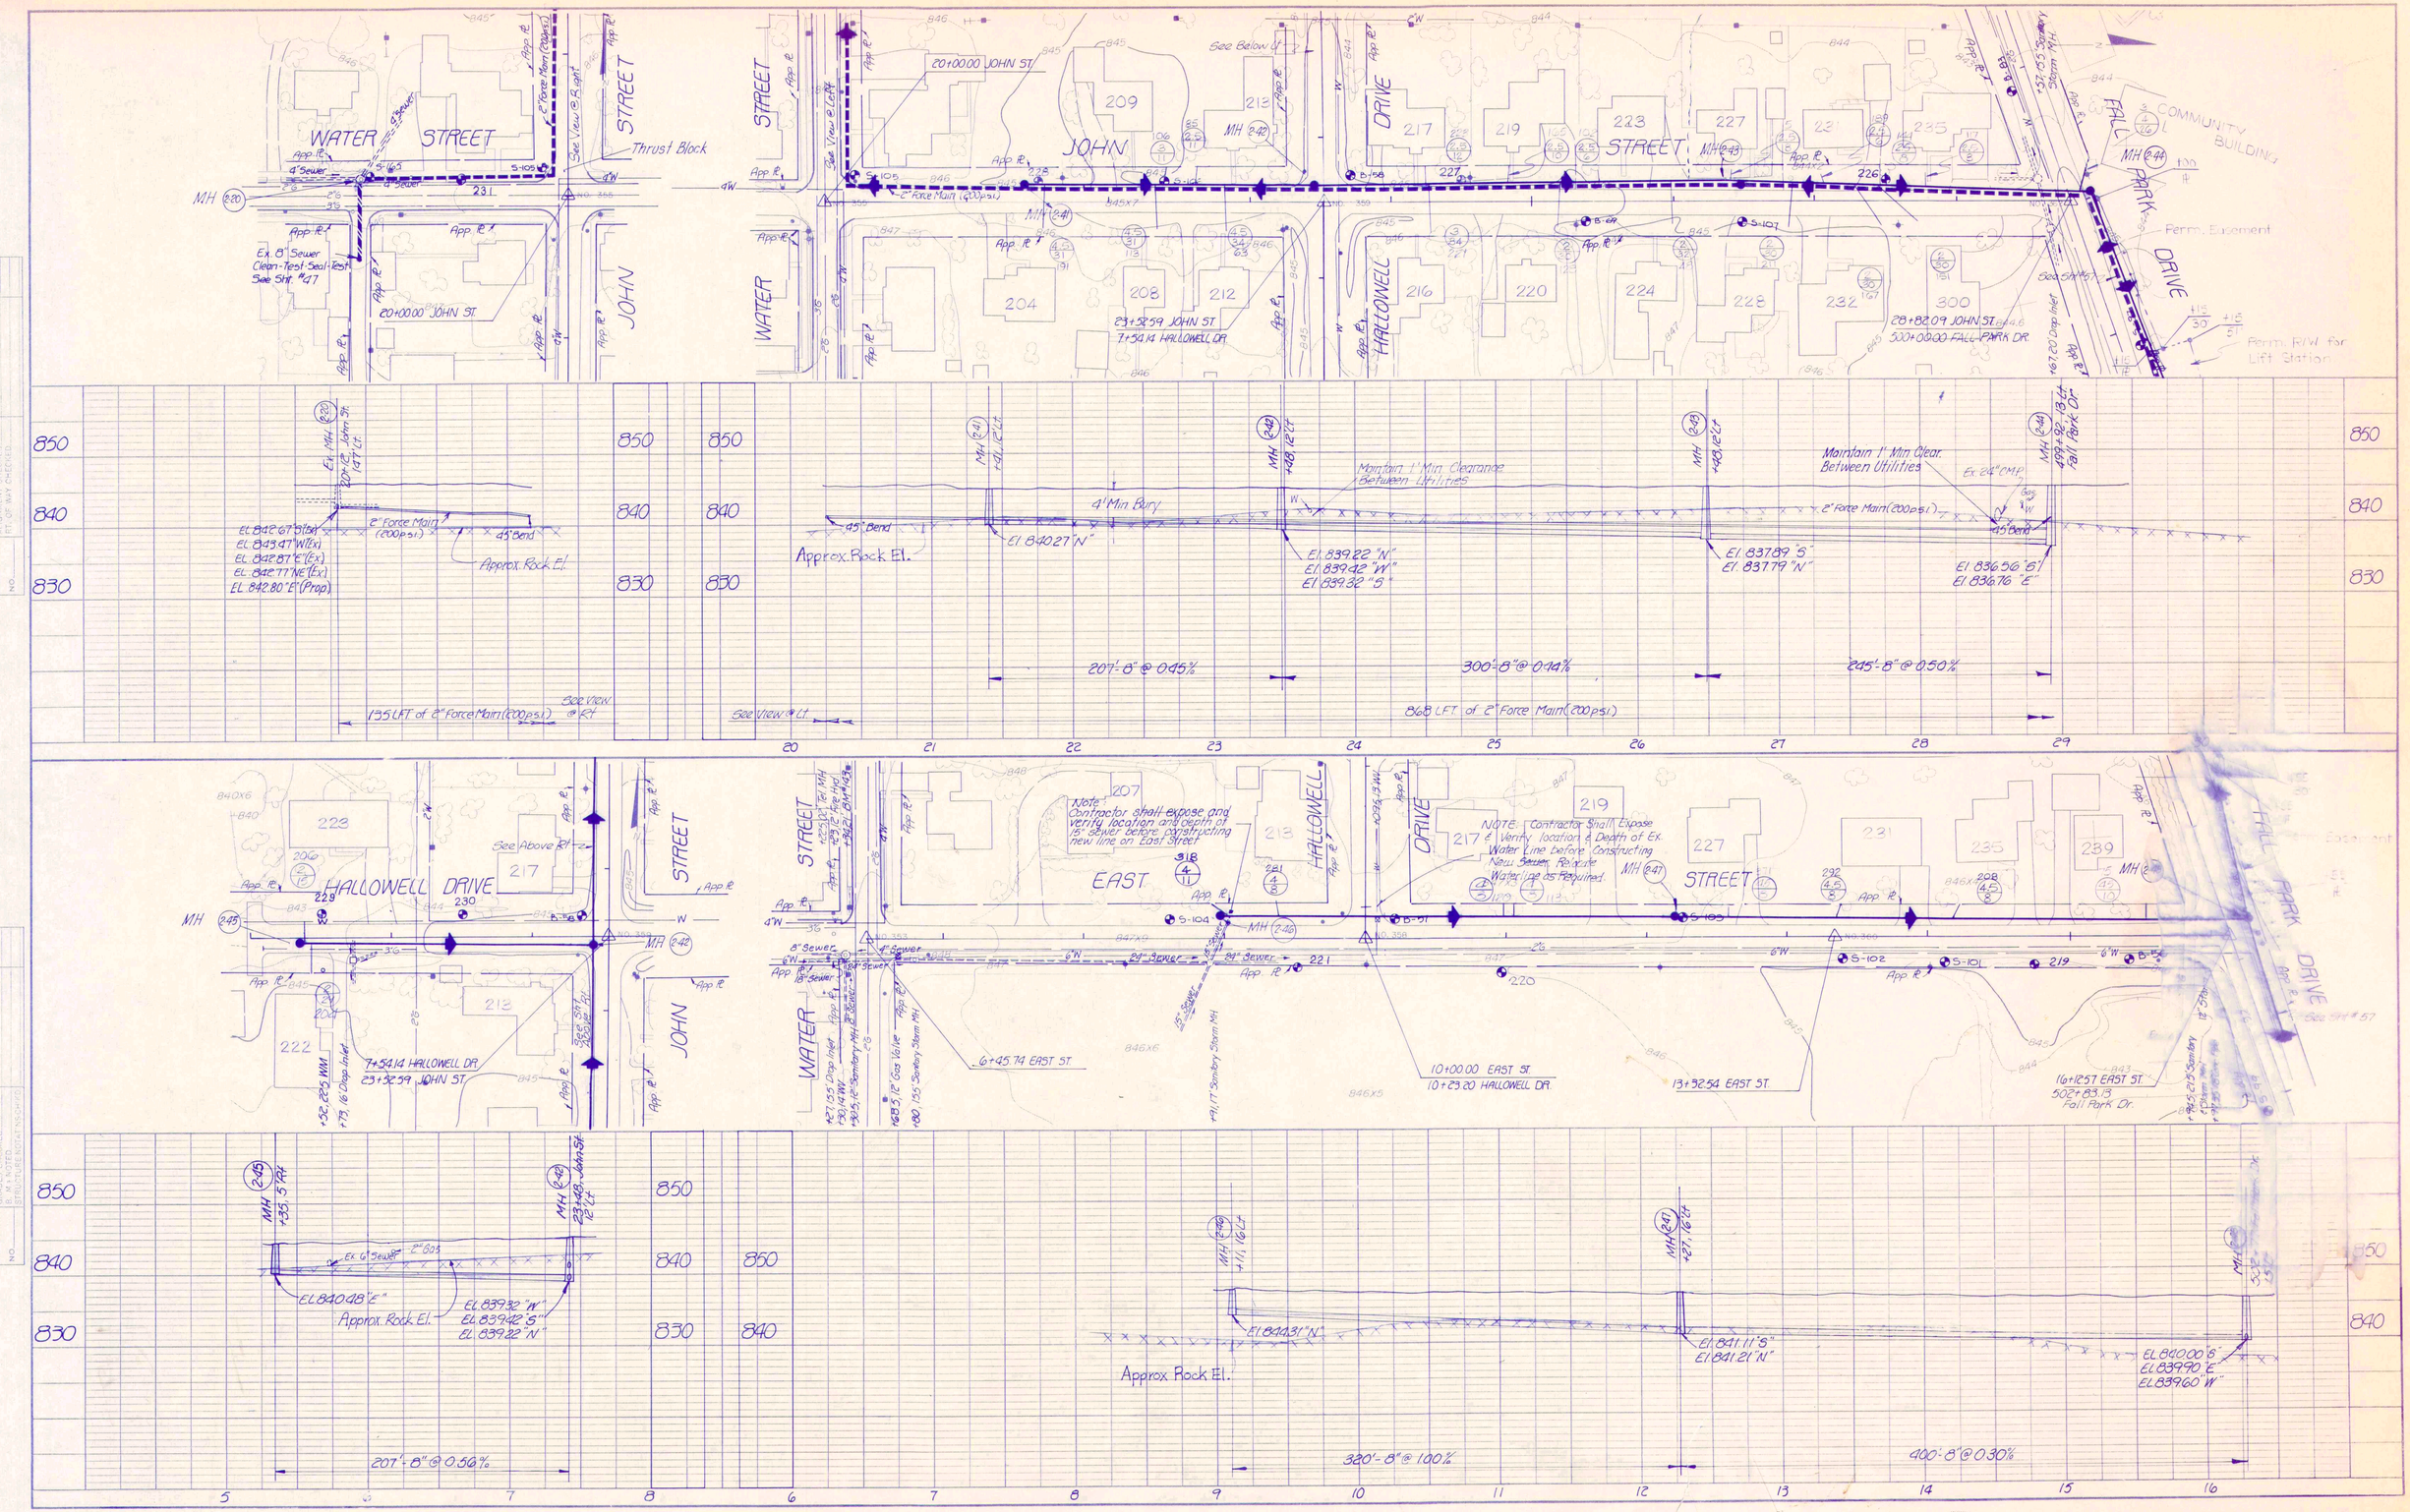

RECORD DRAWING

ERIC R. SKAVE REGISTERED No. 13142 STATE OF INDIANA PROFESSIONAL ENGINEER

WATER STREET / JOHN STREET HALLOWELL DRIVE / EAST STREET	
FALL CREEK R.W.D. PLAN & PROFILE	SHEET 5 of 6
HORIZ. 1" = 50' VERT. 1" = 10'	BEAM, LONGEST & NEFF, INC. CONSULTING ENGINEERS INDIANAPOLIS, INDIANA