NOTE: ALL HOMES ON THIS SHEET ARE RURAL ROUTE 3, BOX # SHOWN.

"LATERAL LEGEND"
A = DISTANCE FROM D/S MH.
X = DEPTH @ ℄.
Y = LENGTH FROM MAIN TO ℄.

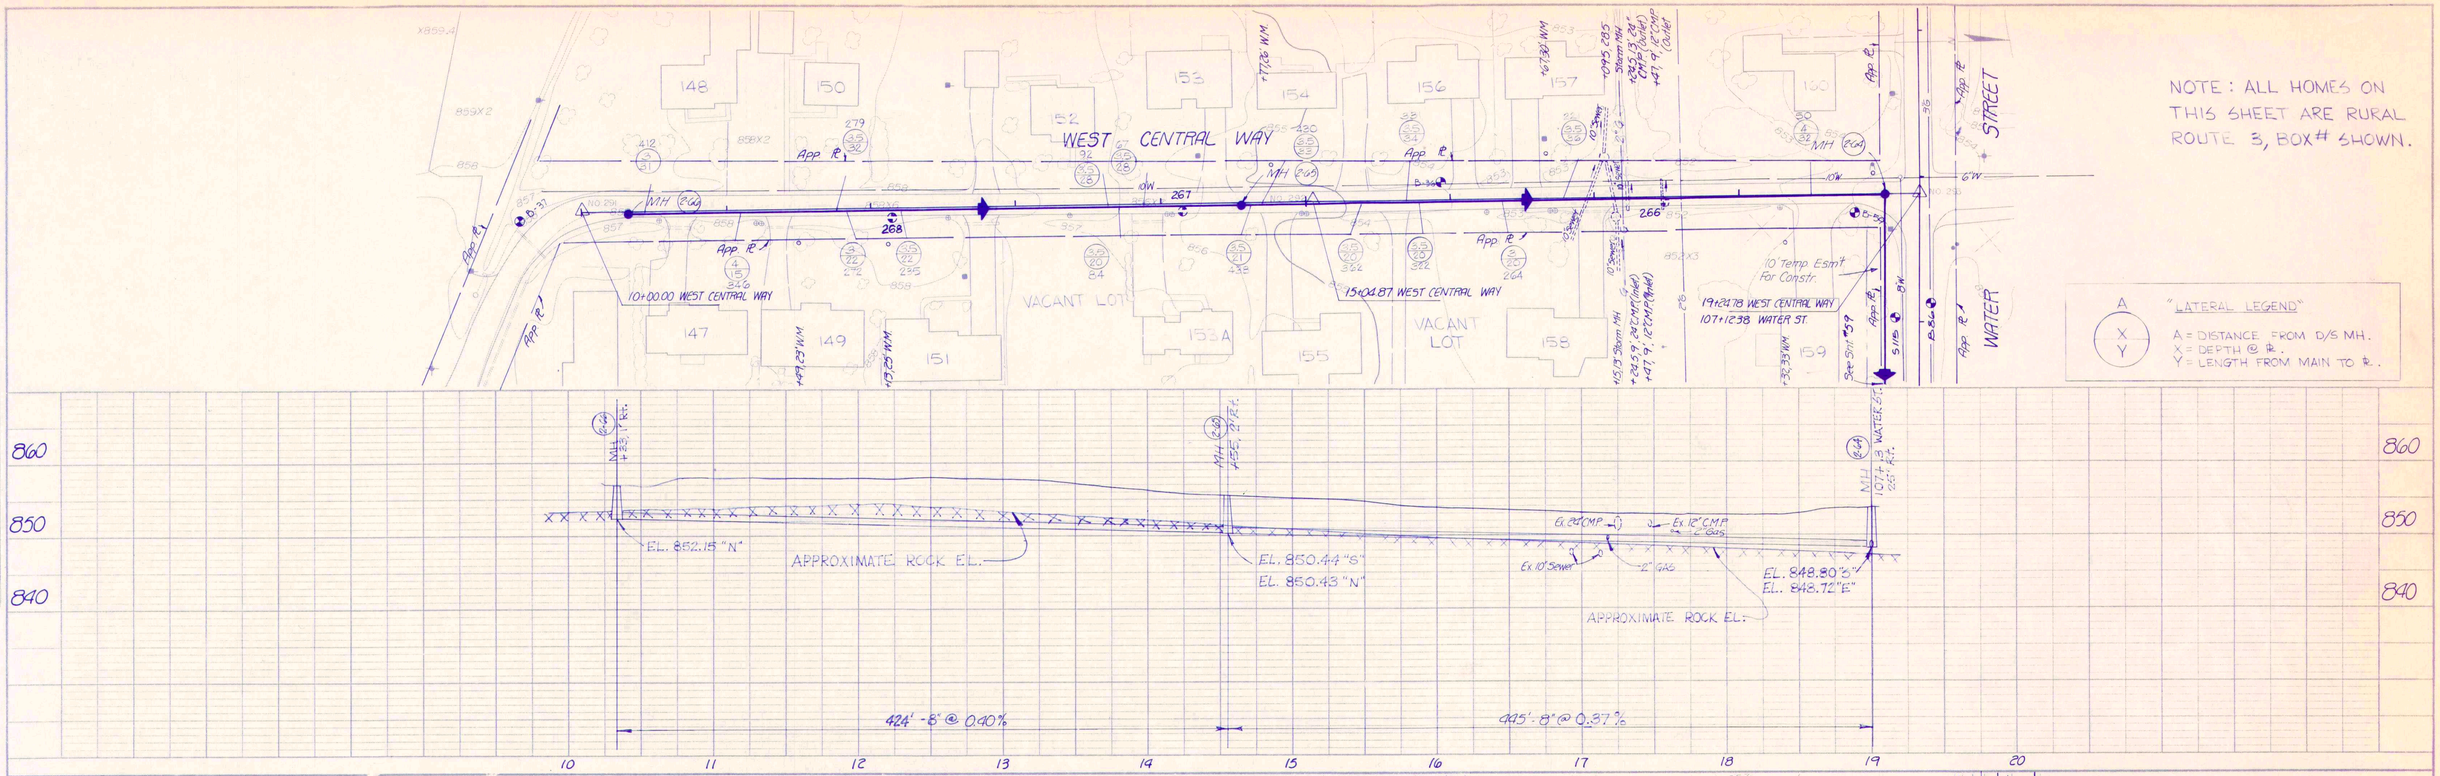

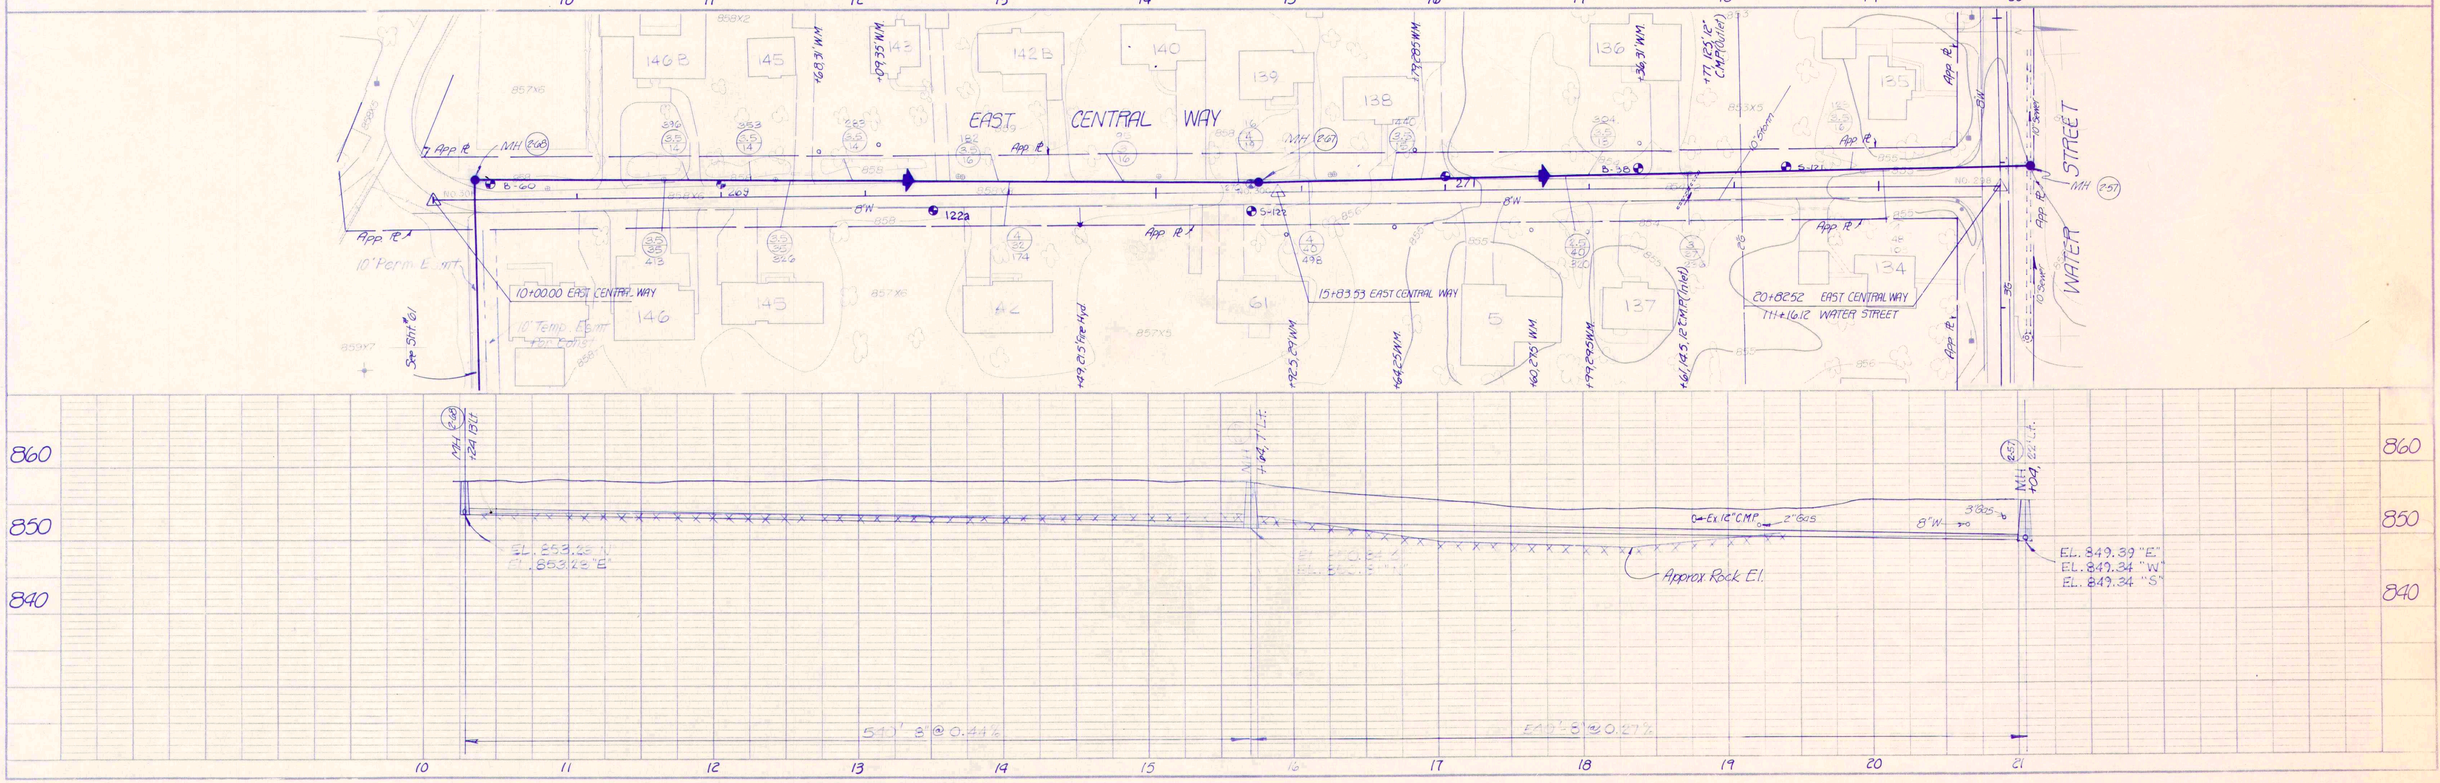

RECORD DRAWING

ERIC R. FESKE
STATE OF INDIANA
PROFESSIONAL ENGINEER

WEST & EAST CENTRAL WAY		
FALL CREEK R.W.D. PLAN & PROFILE		SHEET
HORIZ. 1"=50'	BEAM, LONGEST & NEFF, INC.	60
VERT. 1"=10'	CONSULTING ENGINEERS	
	INDIANAPOLIS, INDIANA	

"ASBUILT"
1/23/85