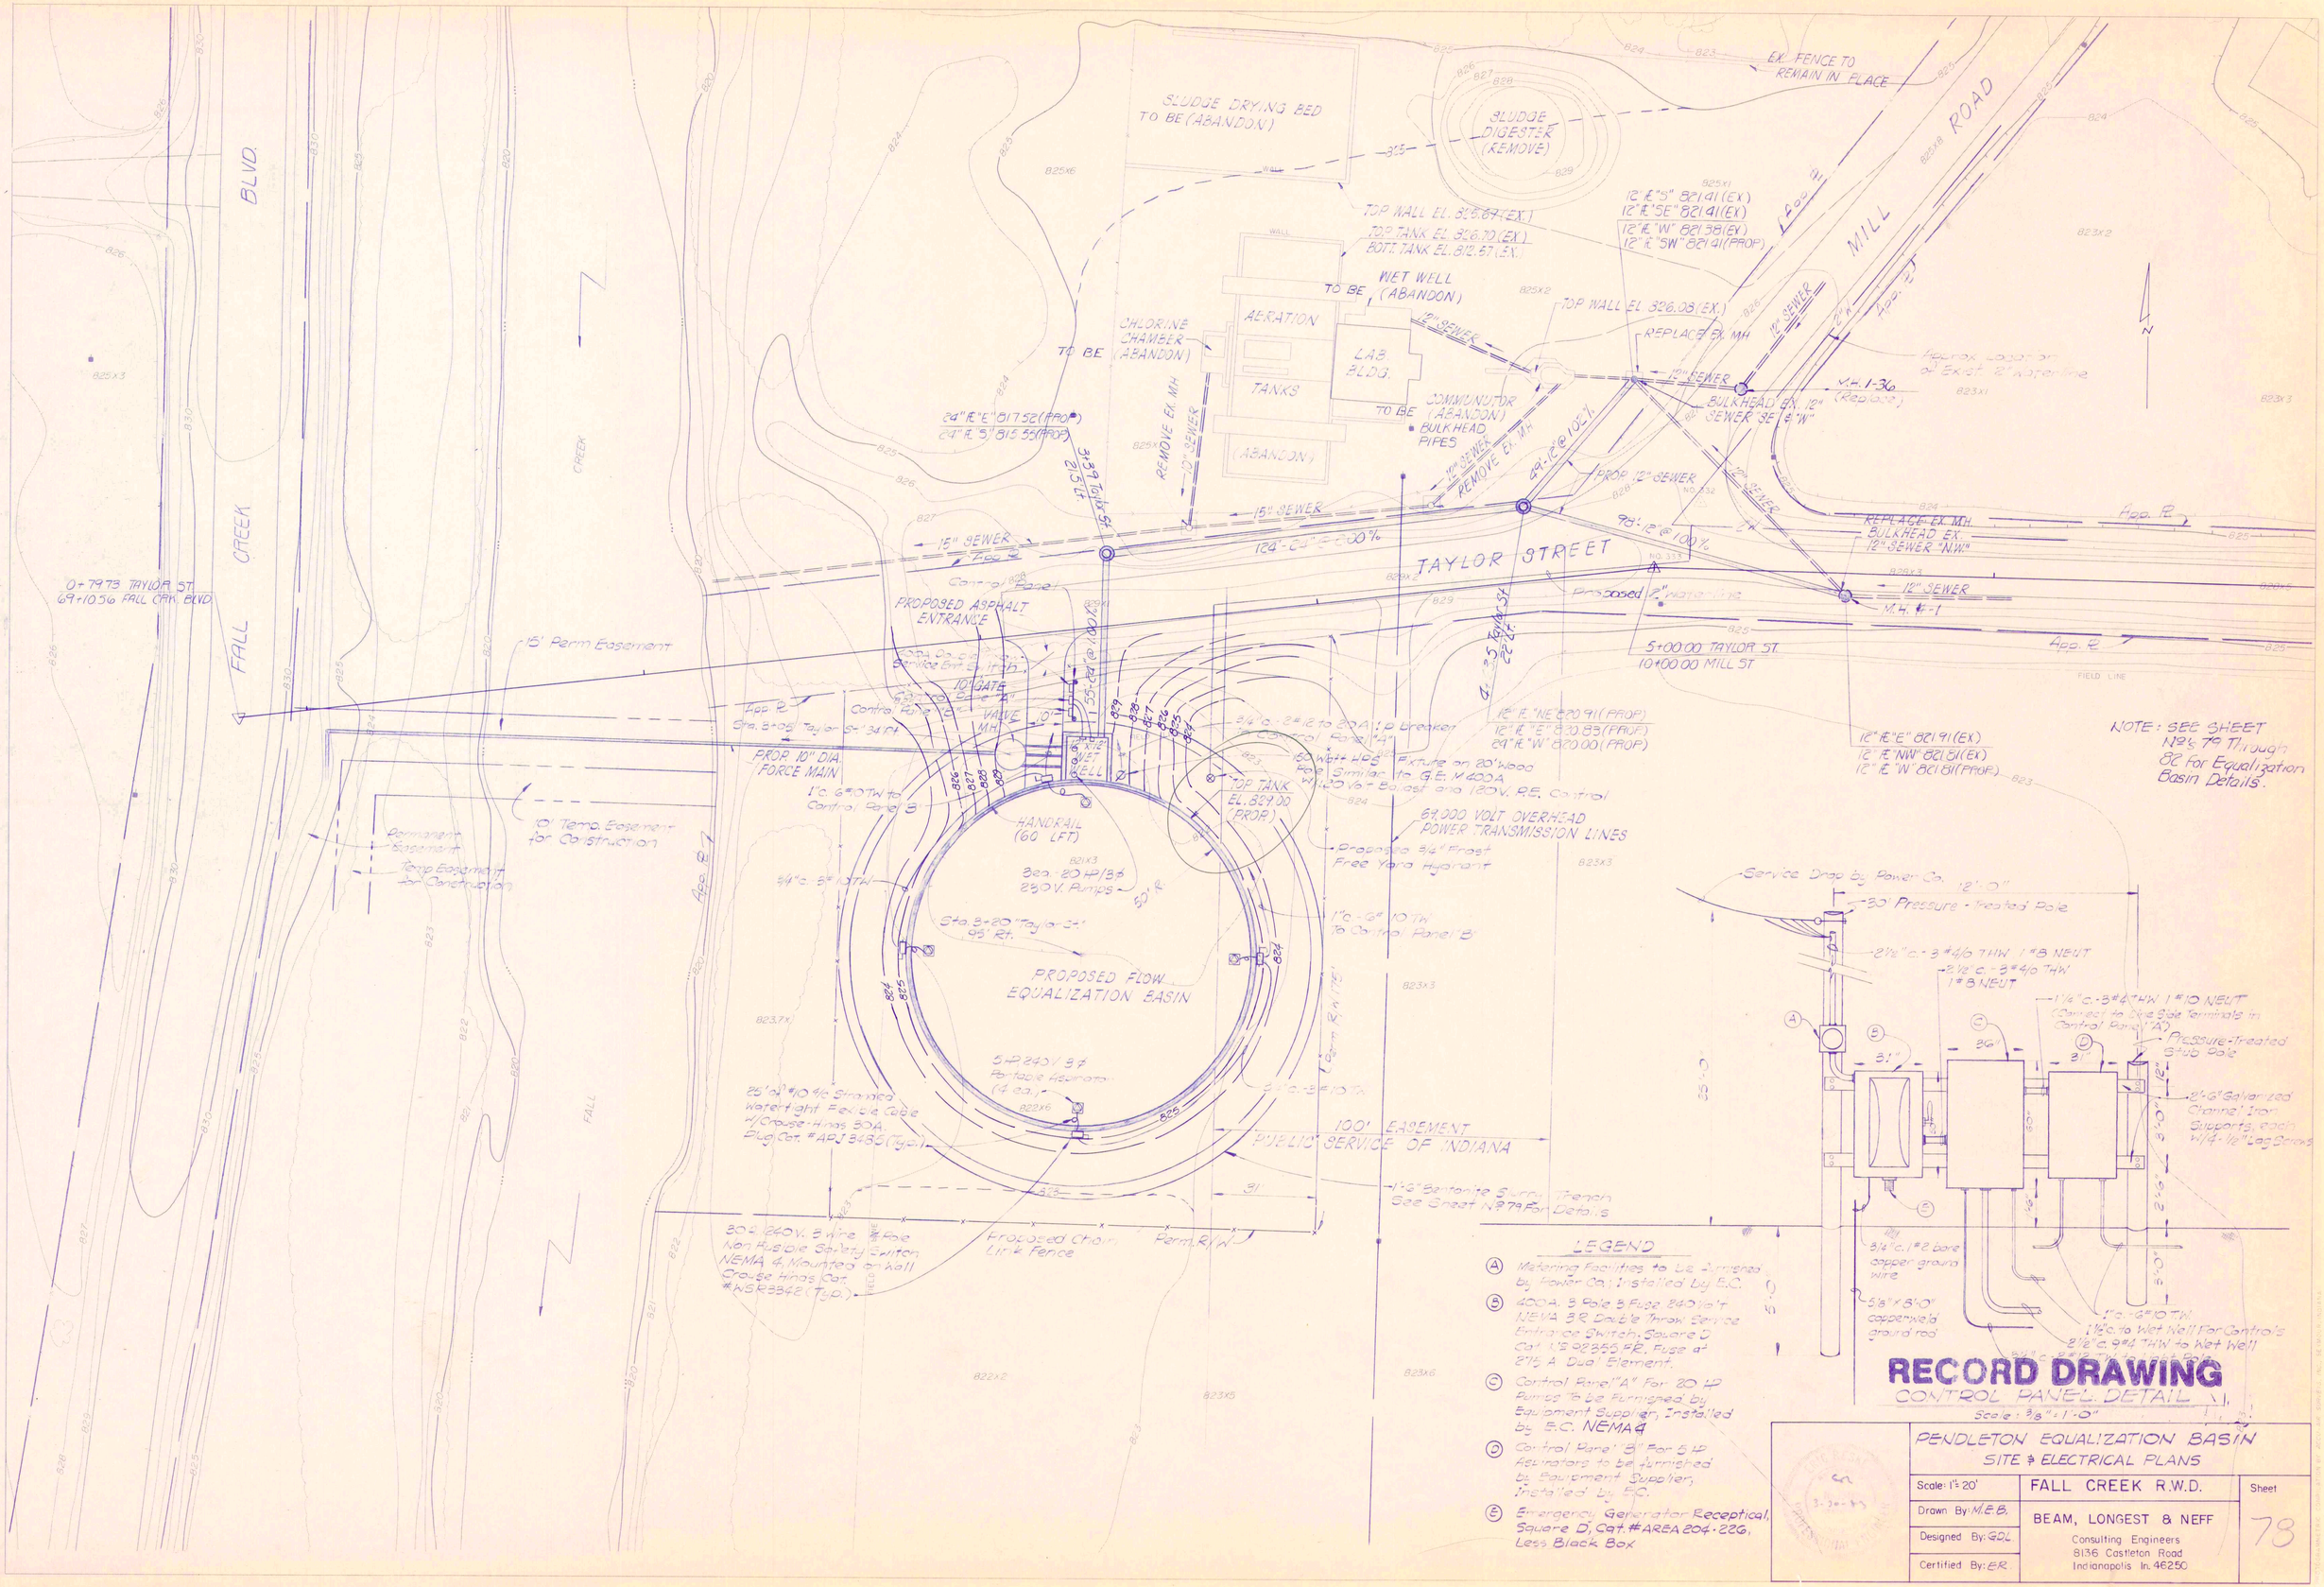
FALL CREEK BLVD.
FALL CREEK
SLUDGE DRYING BED TO BE (ABANDON)
SLUDGE DIGESTER (REMOVE)
EX. FENCE TO REMAIN IN PLACE
MILL ROAD
TOP WALL EL. 826.67 (EX.)
TOP TANK EL. 826.70 (EX.)
BOTT. TANK EL. 812.67 (EX.)
WET WELL TO BE (ABANDON)
AERATION TANKS
LAB. BLDG.
CHLORINE CHAMBER (ABANDON)
TO BE
COMMUNUTOR (ABANDON)
BULK HEAD PIPES
TOP WALL EL. 826.08 (EX.)
REPLACE EX. MH
BULKHEAD EX. 12" SEWER SE & W
M.H. 1-36 (Replace)
REMOVE EX. MH
12" SEWER
15" SEWER
PROP. 12" SEWER
TAYLOR STREET
REPLACE EX. MH.
BULKHEAD EX. 12" SEWER "N.W."
M.H. 1-1
5+00.00 TAYLOR ST.
10+00.00 MILL ST.
0+79.73 TAYLOR ST.
69+10.56 FALL CRK. BLVD.
15' Perm. Easement
PROPOSED ASPHALT ENTRANCE
10' GATE VALVE
PROP. 10" DIA. FORCE MAIN
WET WELL
HANDRAIL (60' LFT)
Sta. 8+20 Taylor St. 95' Rt.
PROPOSED FLOW EQUALIZATION BASIN
TOP TANK EL. 824.00 (PROP.)
64,000 VOLT OVERHEAD POWER TRANSMISSION LINES
Proposed 3/4" Frost Free Yard Hydrant
Service Drop by Power Co.
30' Pressure - Treated Pole
Pressure-Treated Stub Pole
100' EASEMENT PUBLIC SERVICE OF INDIANA
Proposed Chain Link Fence
Perm. R/W
Temp. Easement for Construction
Permanent Easement
FIELD LINE
NOTE: SEE SHEET N#79 Through 82 for Equalization Basin Details.
LEGEND
(A) Metering Facilities to be furnished by Power Co.; Installed by E.C.
(B) 400 A. 3 Pole 3 Fuse 240 Volt NEMA 3R Double Throw Service Entrance Switch; Square D Cat. #S 02355 FR. Fuse at 2½ A Dual Element.
(C) Control Panel "A" For 20 HP Pumps To be Furnished by Equipment Supplier, Installed by E.C. NEMA 4
(D) Control Panel "B" For 5 HP Aerators to be furnished by Equipment Supplier, Installed by E.C.
(E) Emergency Generator Receptical, Square D, Cat. #AREA 204-226, Less Black Box
RECORD DRAWING
CONTROL PANEL DETAIL
Scale: 3/8" = 1'-0"
PENDLETON EQUALIZATION BASIN
SITE & ELECTRICAL PLANS
Scale: 1" = 20'
FALL CREEK R.W.D.
Sheet
Drawn By: M.E.B.
Designed By: GDL
Certified By: E.R.
BEAM, LONGEST & NEFF
Consulting Engineers
8136 Castleton Road
Indianapolis In. 46250
78