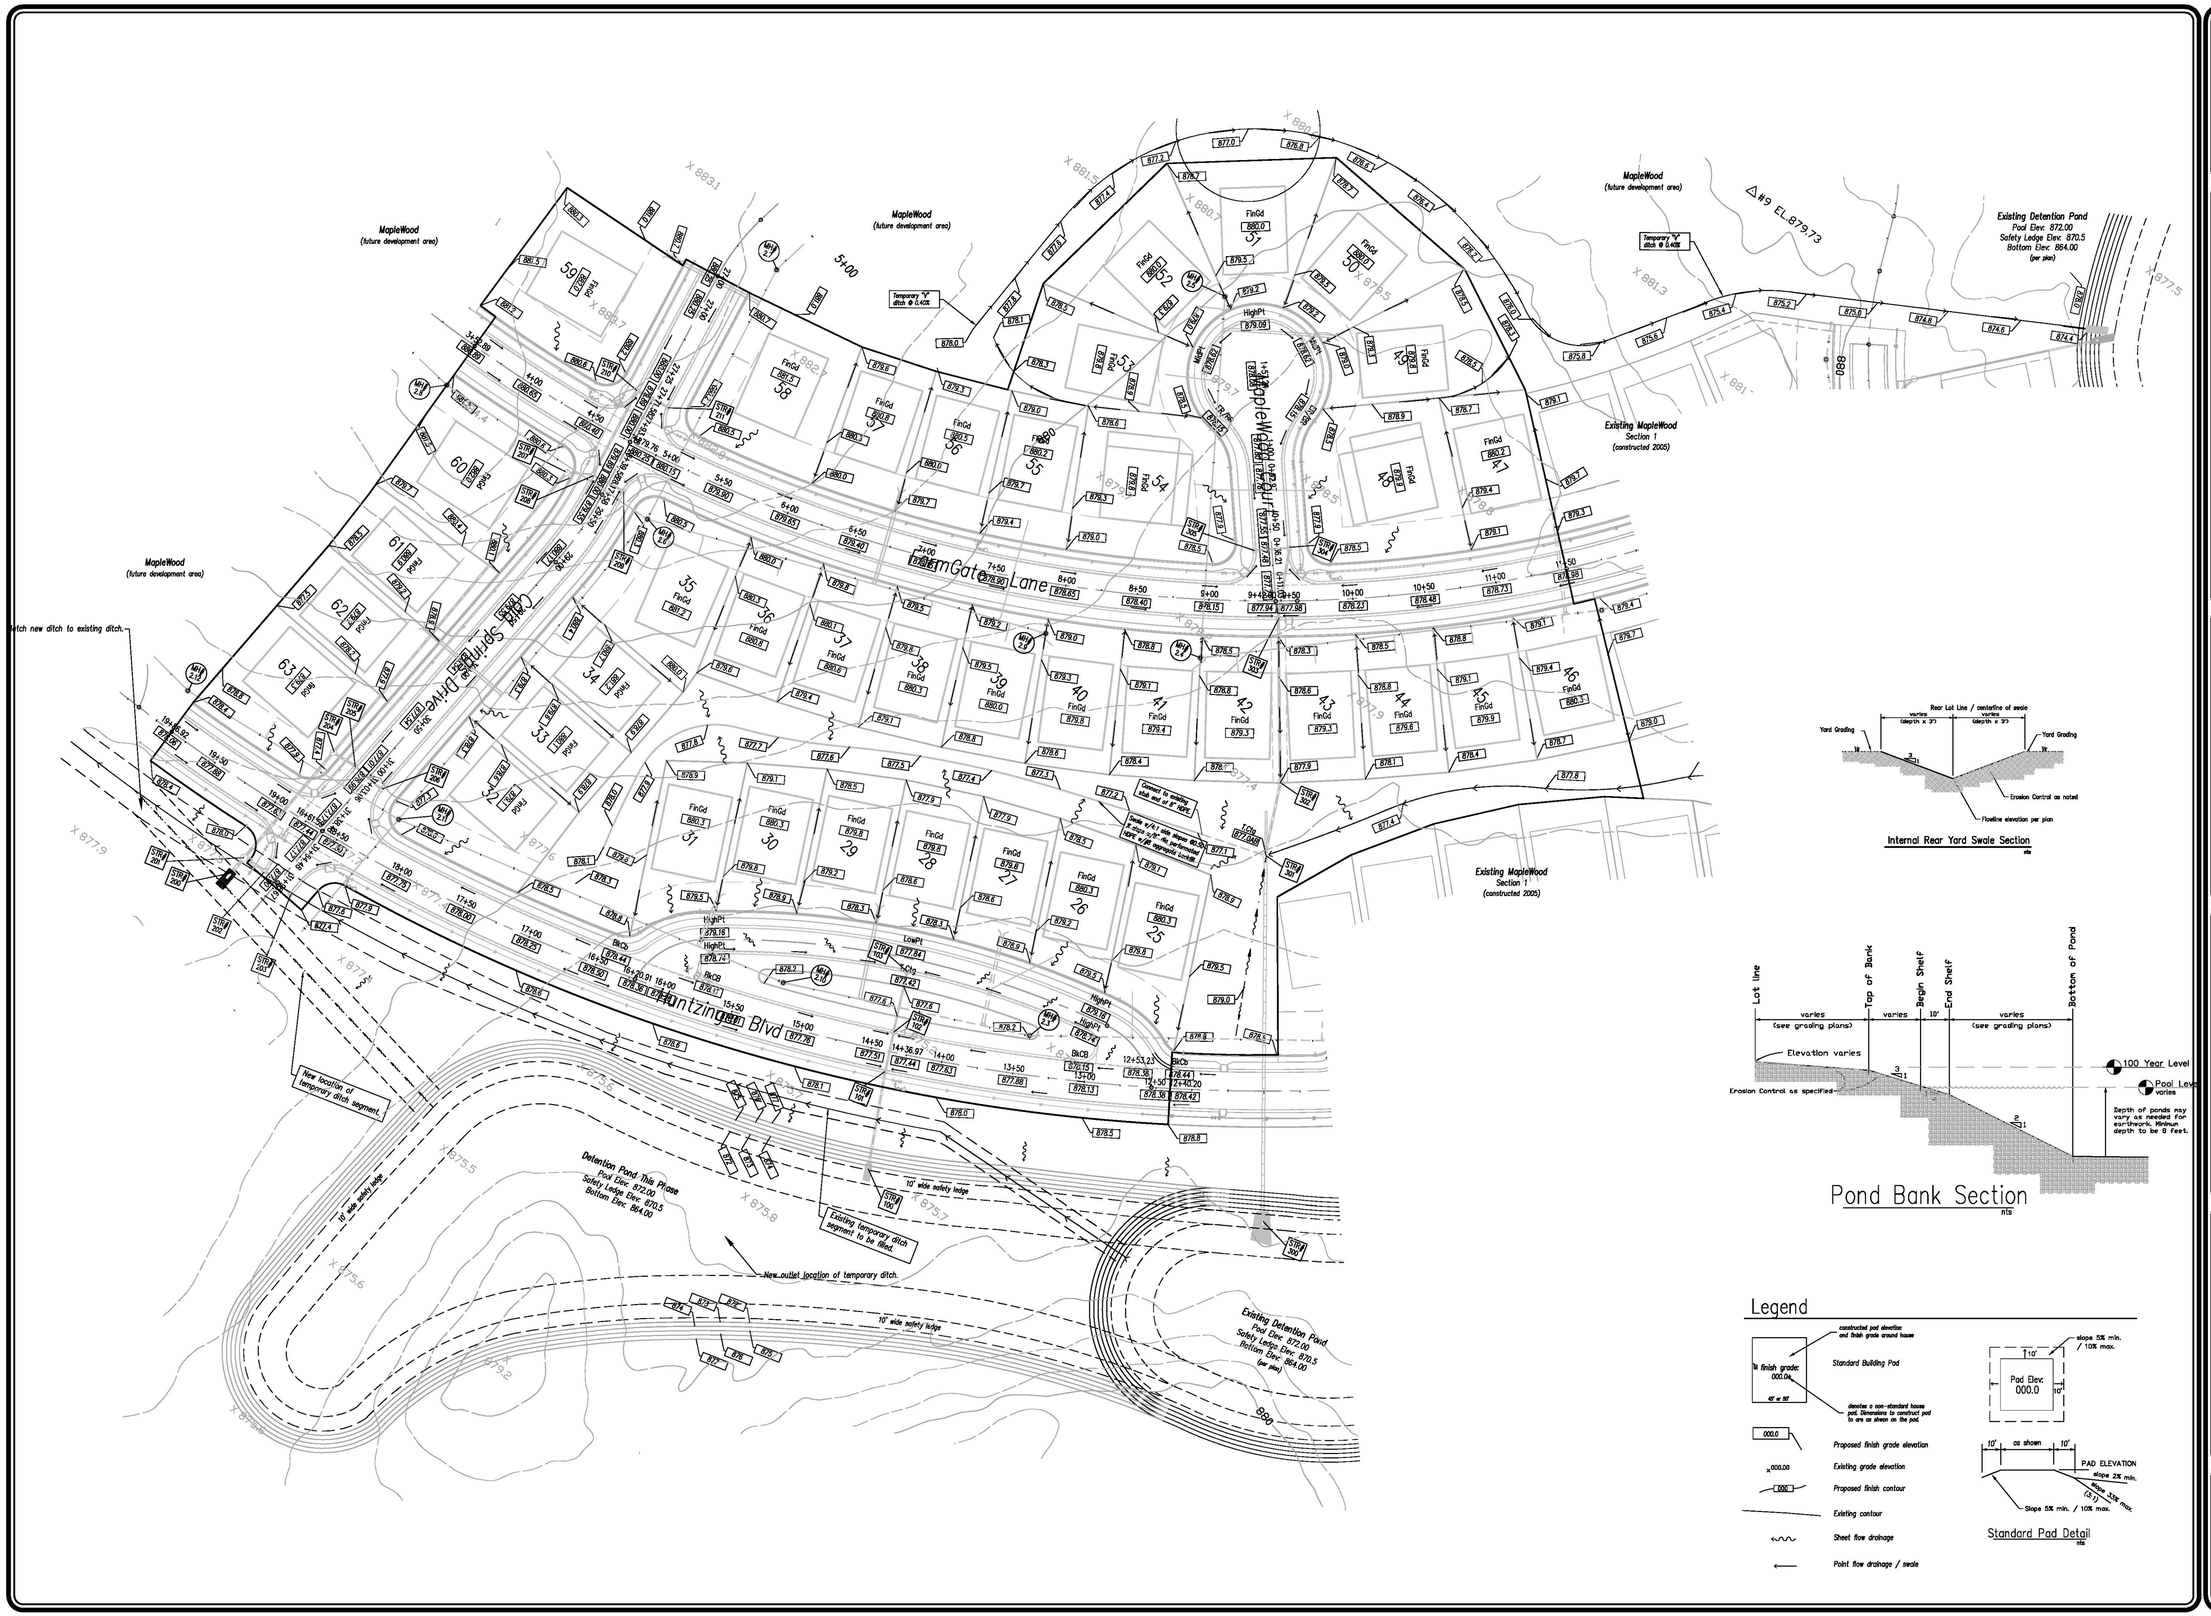

Internal Rear Yard Swale Section
nts

Pond Bank Section
nts

Legend

- constructed pad elevation and finish grade around house — 98 finish grade: 000.04 — 40' or 50' — Standard Building Pad
- denotes a non-standard house pad. Dimensions to construct pad to are as shown on the pad.
- 000.0 — Proposed finish grade elevation
- x000.00 — Existing grade elevation
- 000 — Proposed finish contour
- Existing contour
- Sheet flow drainage
- Point flow drainage / swale

Standard Pad Detail
nts

North

Scale: 1"=50'

Pendleton Consulting
P.O.Box 67 Pendleton, Indiana 46064
Phone: 765-778-4590 Fax: 765-778-5571
email: pendcons@mindspring.net

Pendleton Land Company, LLC
9449 Priority Way West Drive
Suite 120
Indianapolis, Indiana 46240
Tel: 317.705.2063
Fax: 317.705.2069

Date 6/12/2006

Revision	Date

Project: MapleWood at Huntzinger Farm
Section 2
Pendleton, Madison County, Indiana

Sheet Title: Grading Plan

STEVEN E. BOURDON REGISTERED No. S0441 STATE OF INDIANA LAND SURVEYOR

Sheet No. 3 of 20 Sheets