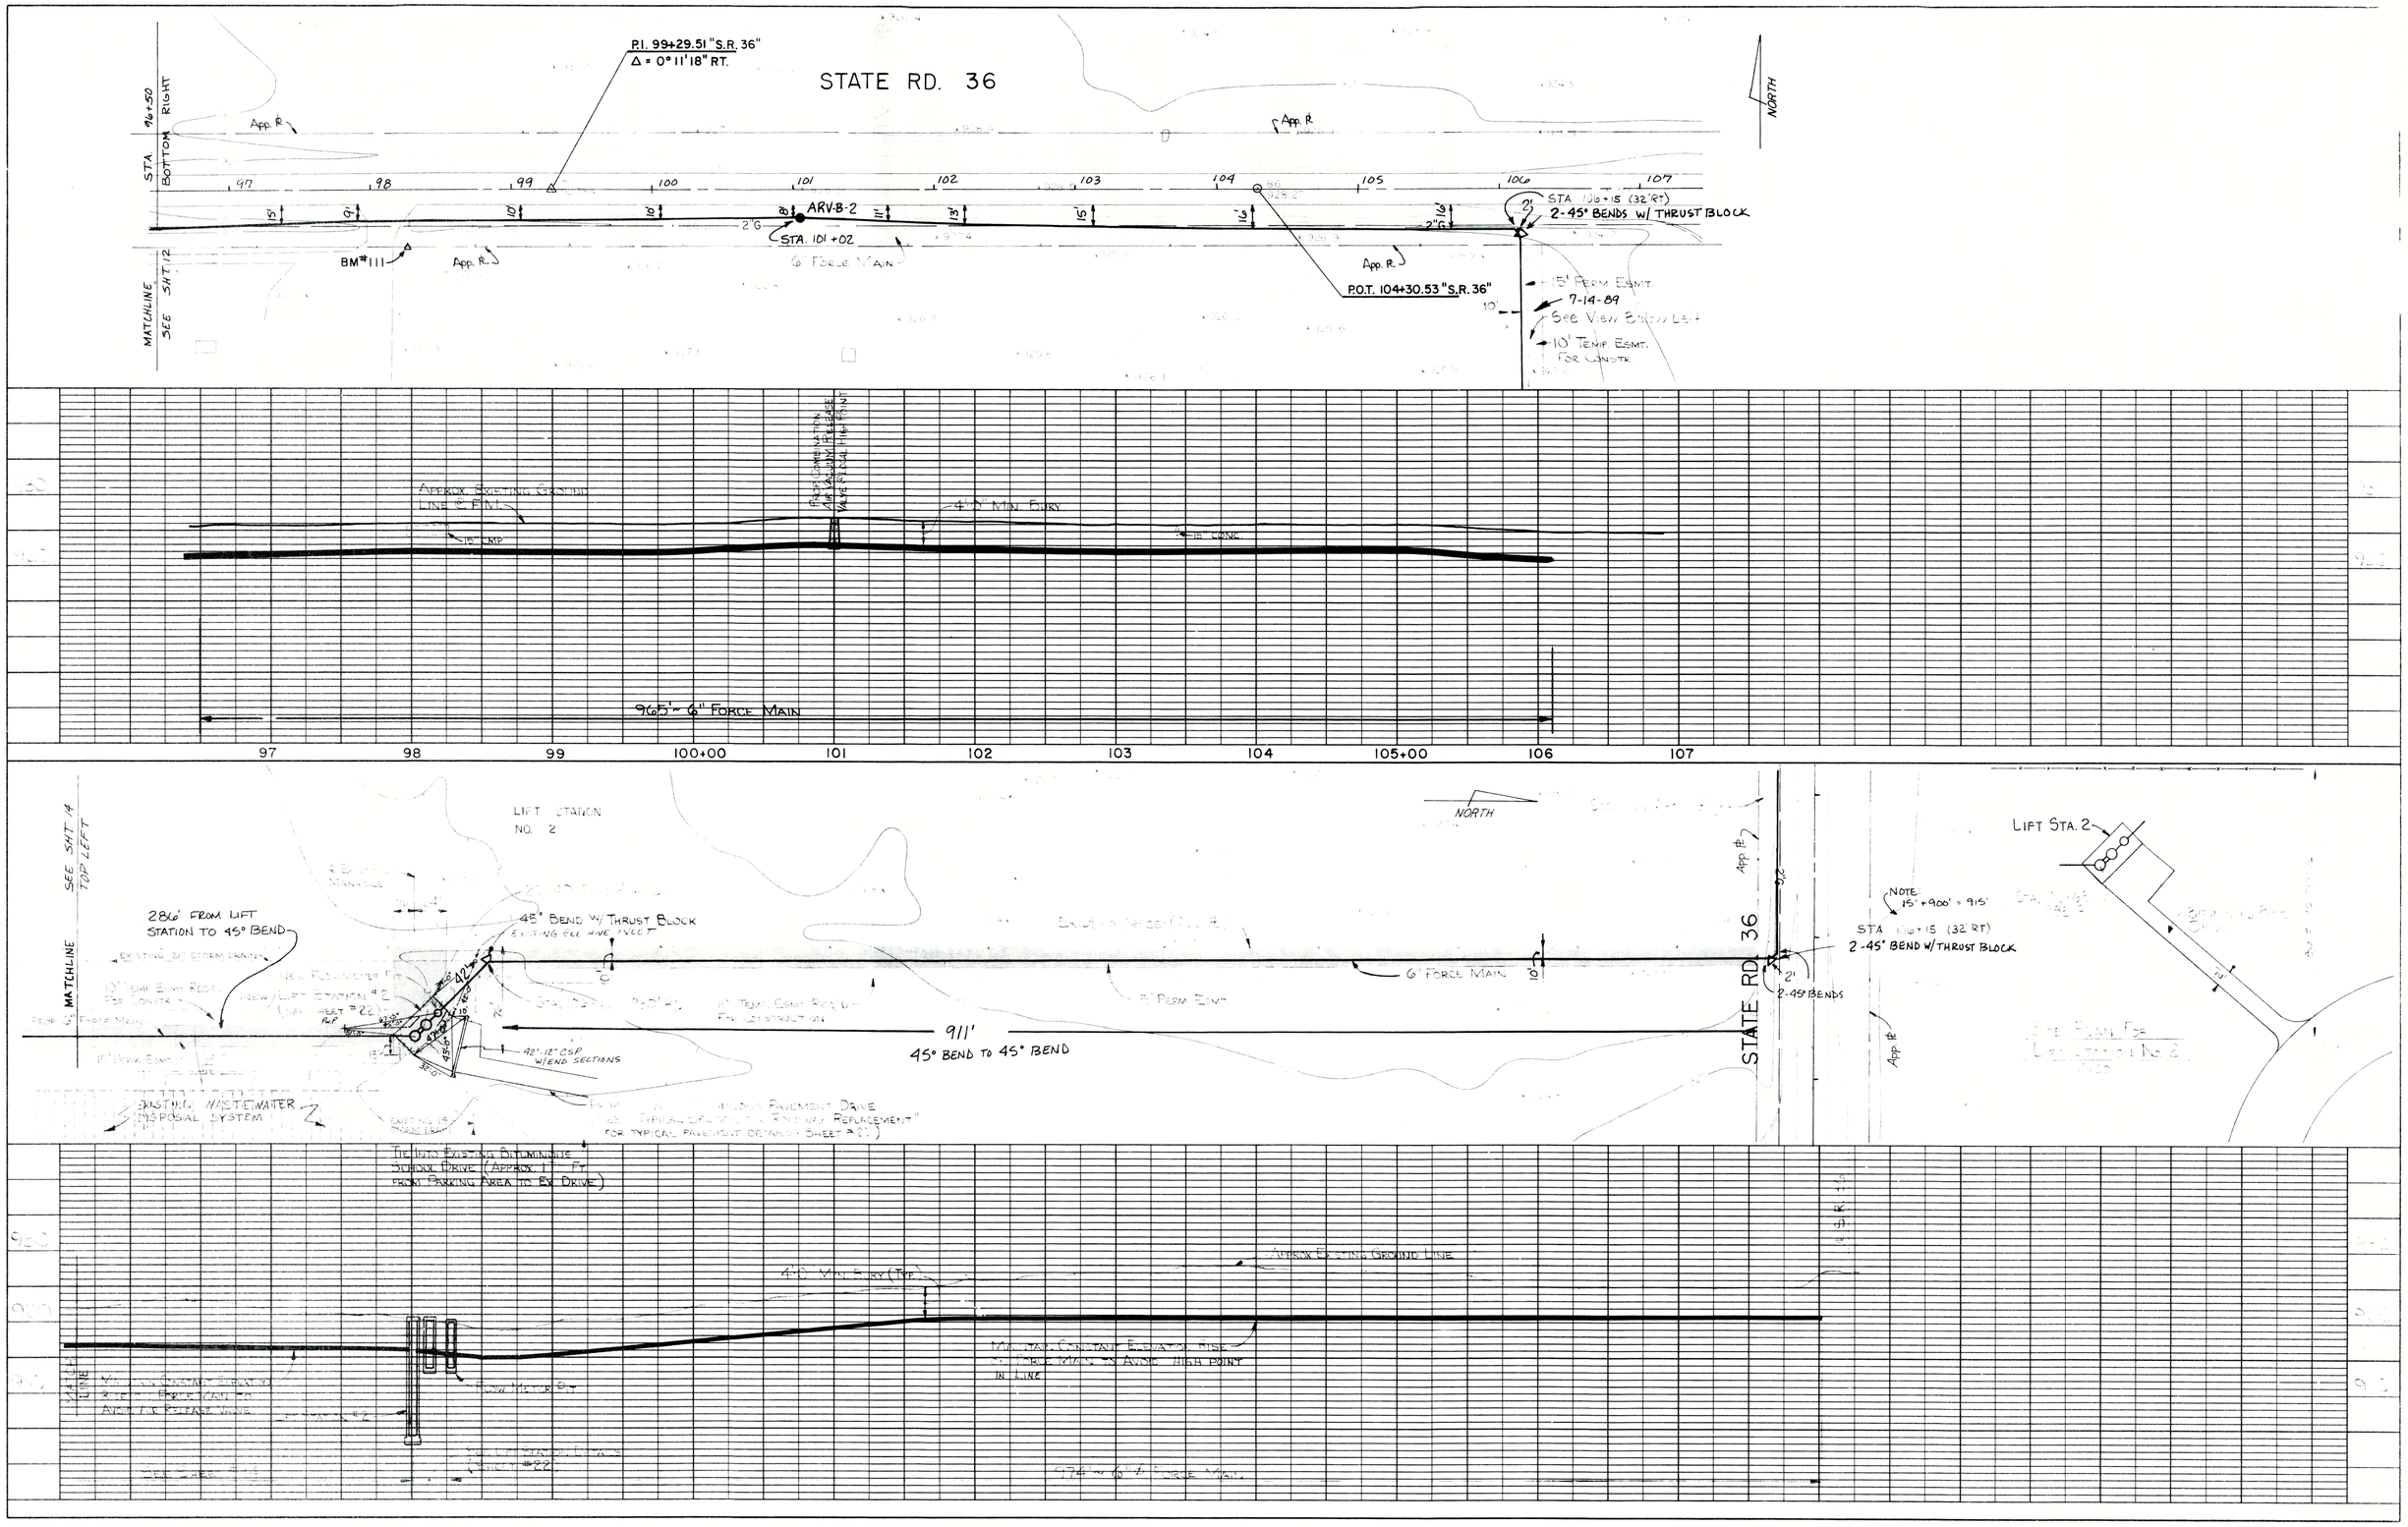

BM 111: 98+23.5, 38' Rt. State Road 36 - Elev. 927.31
Mine Spike in Power Pole on South Side of
State Road 36 at Drive by Mailbox No. 229
(Heath Property)

BM 112: 99+00, 68' Rt. State Road 36 - Elev. 926.03
Chisled Square in Concrete Light Base on
"Northeast" Corner of [illegible]

NOTE: Contractor will encounter underground utilities (Gas, Water, Telephone and Electric Mains and Services for each building). Utilities not encountered may be subject to a credit on the Paper.

RECORD DRAWING

STATE RD. 36 & SCHOOL		
MARKLEVILLE PLAN & PROFILE		SHEET
HORIZ. 1"=50' VERT. 1"=10'	BEAM, LONGEST & NEFF, INC. CONSULTING ENGINEERS INDIANAPOLIS, INDIANA	13

DIVISION B