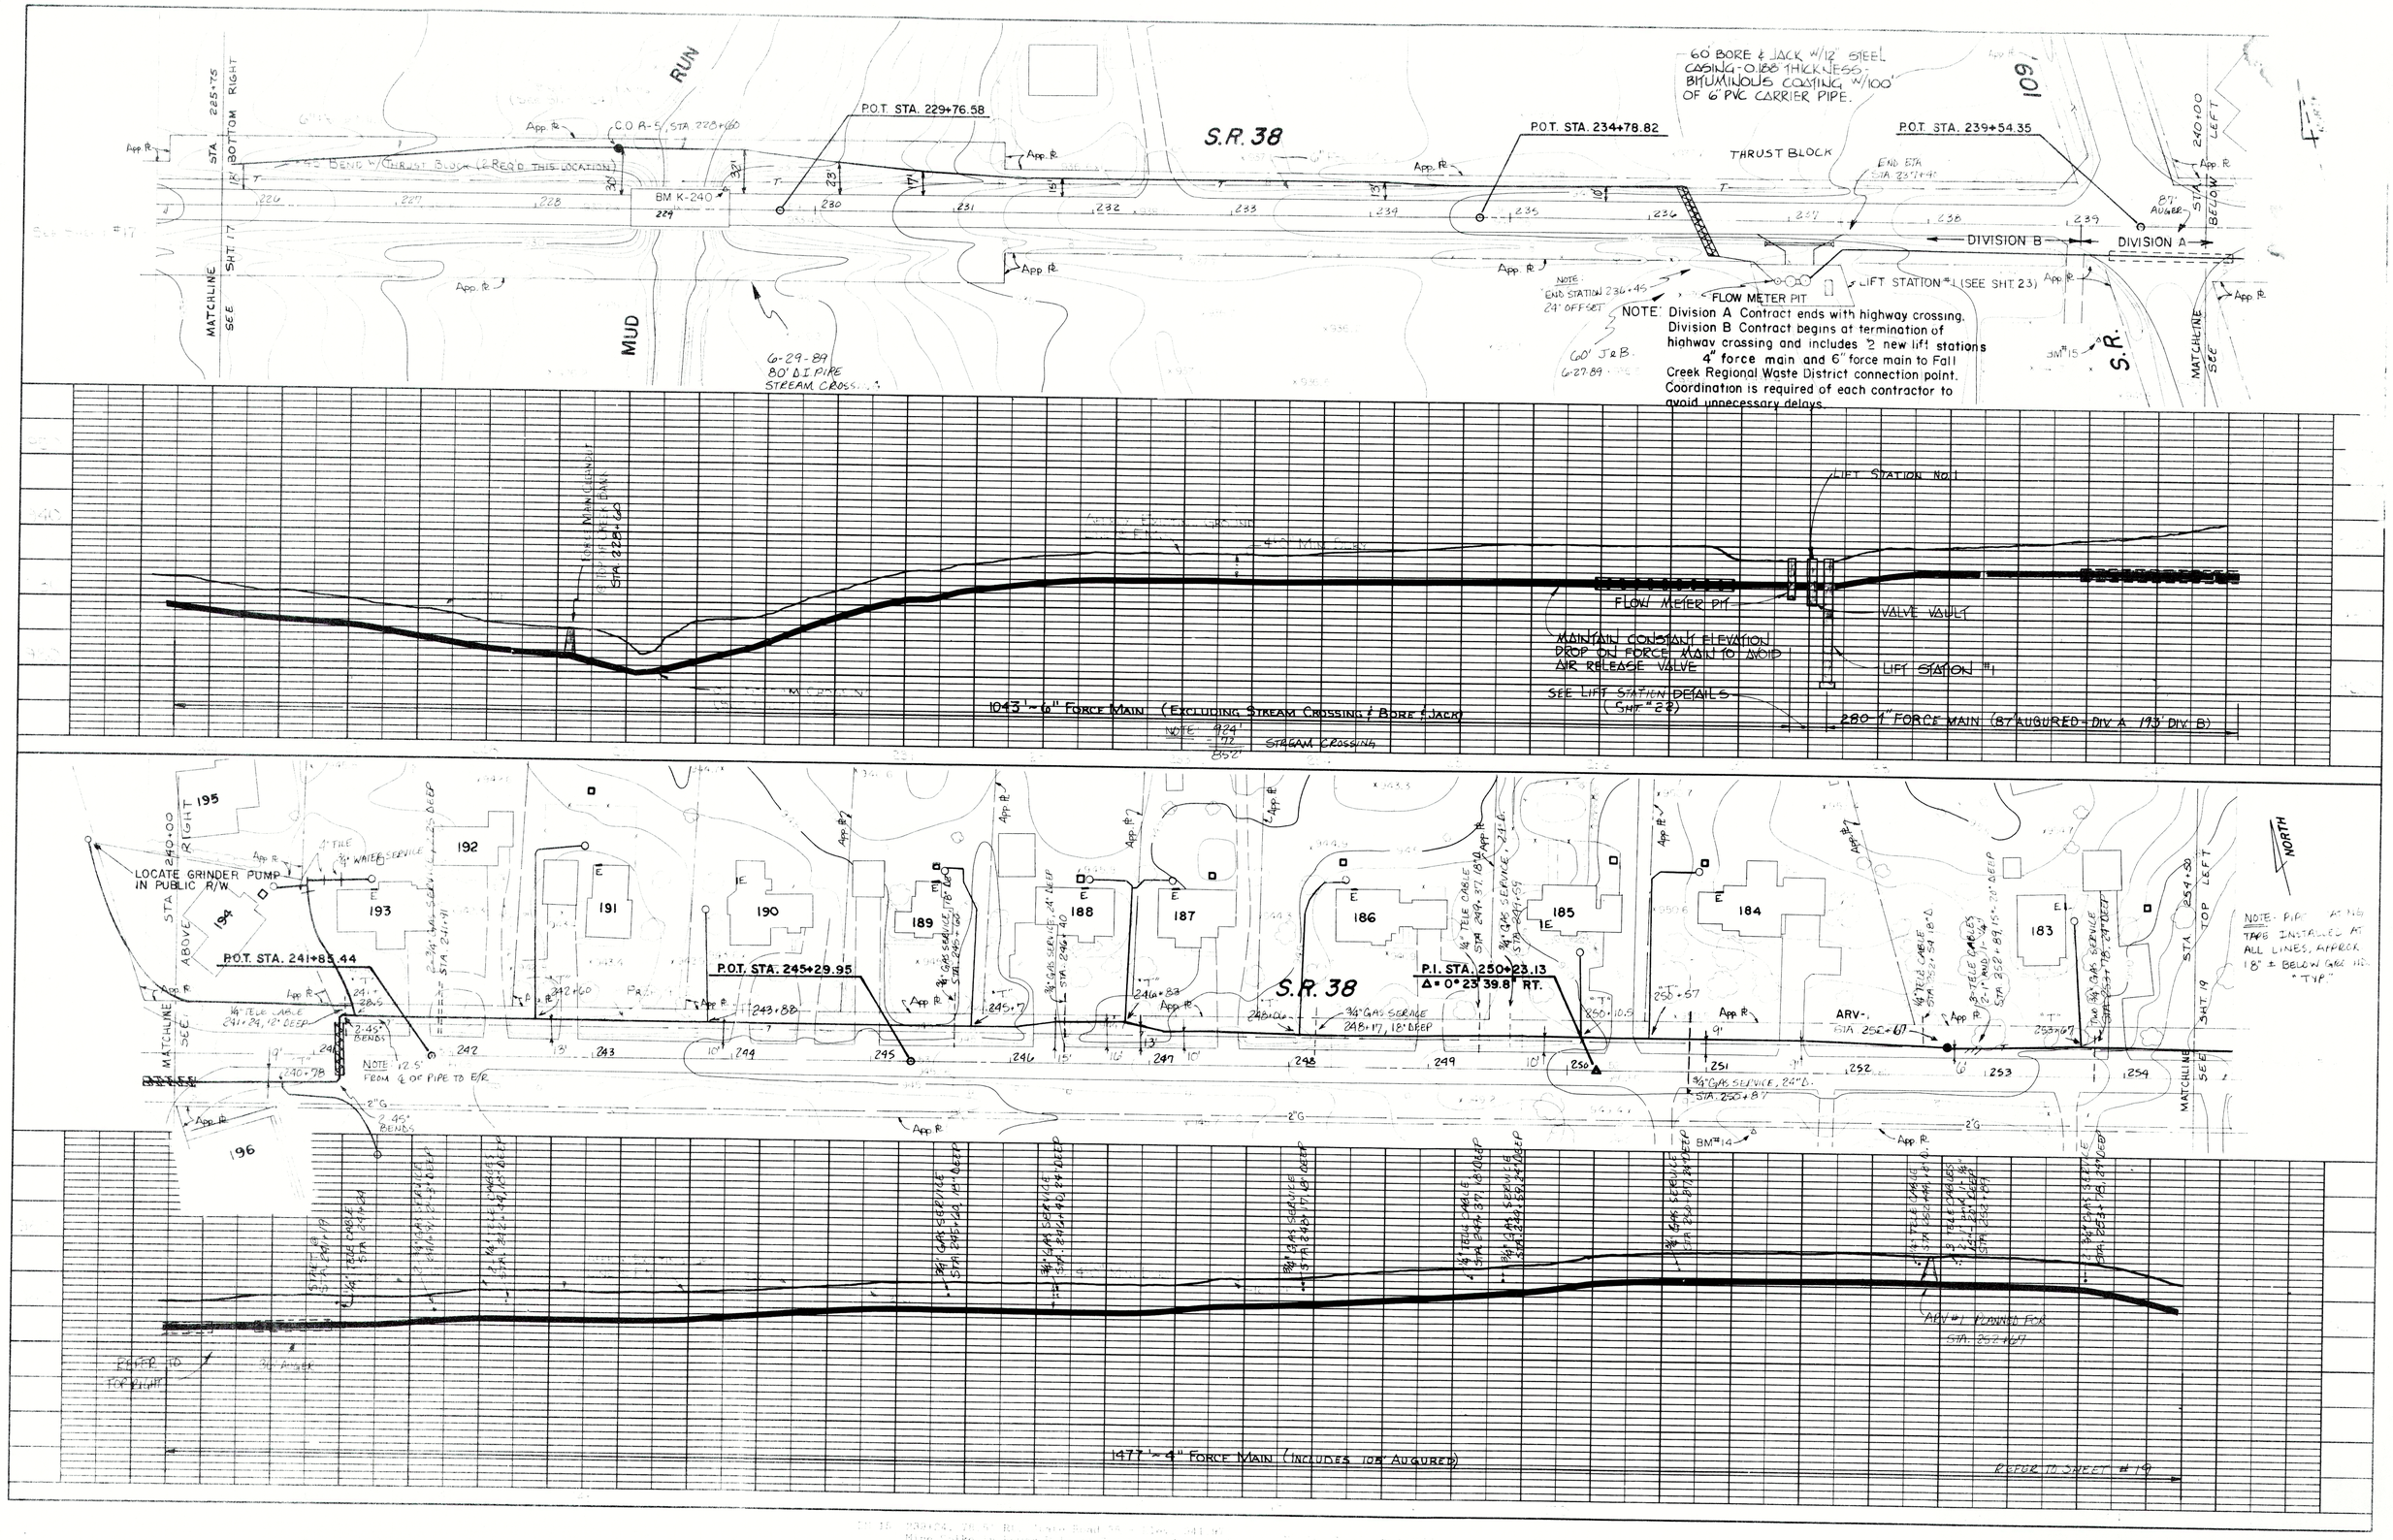

STATE ROAD 38

MARKLEVILLE PLAN & PROFILE

HORIZ. 1"=50'
VERT. 1"=10'

BEAM, LONGEST & NEFF, INC.
CONSULTING ENGINEERS
INDIANAPOLIS, INDIANA

SHEET 18

RECORD DRAWING