FALL CREEK REGIONAL WASTE DISTRICT
DIVISION 'A' & DIVISION 'B'
SHEET No. 36b

INDEX MA-1

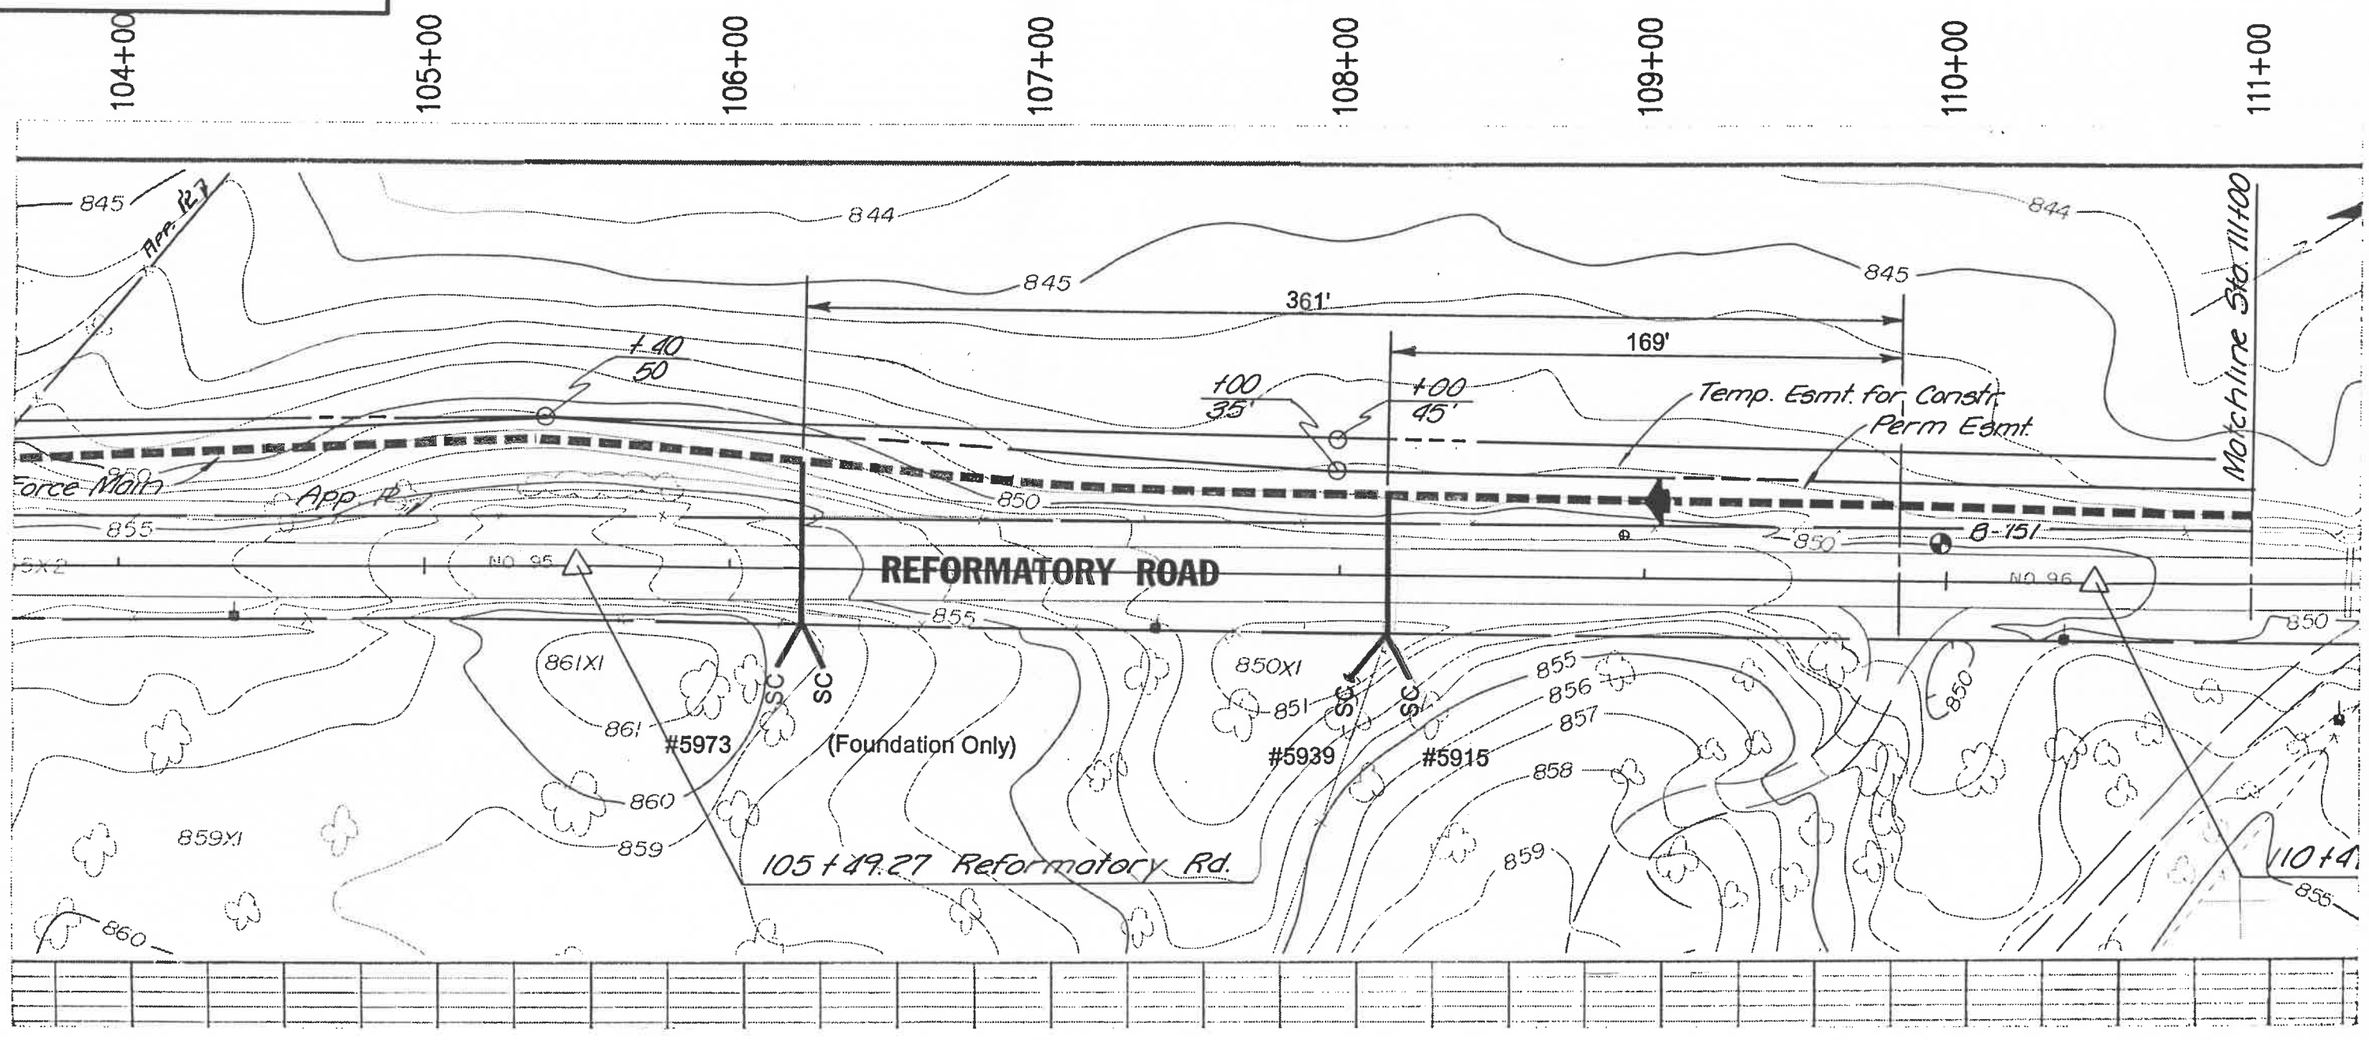

AS-BUILT INFORMATION
SCALE: 1" = 50'

NORTH

TRIAD ASSOCIATES INC.
INDIANAPOLIS, INDIANA