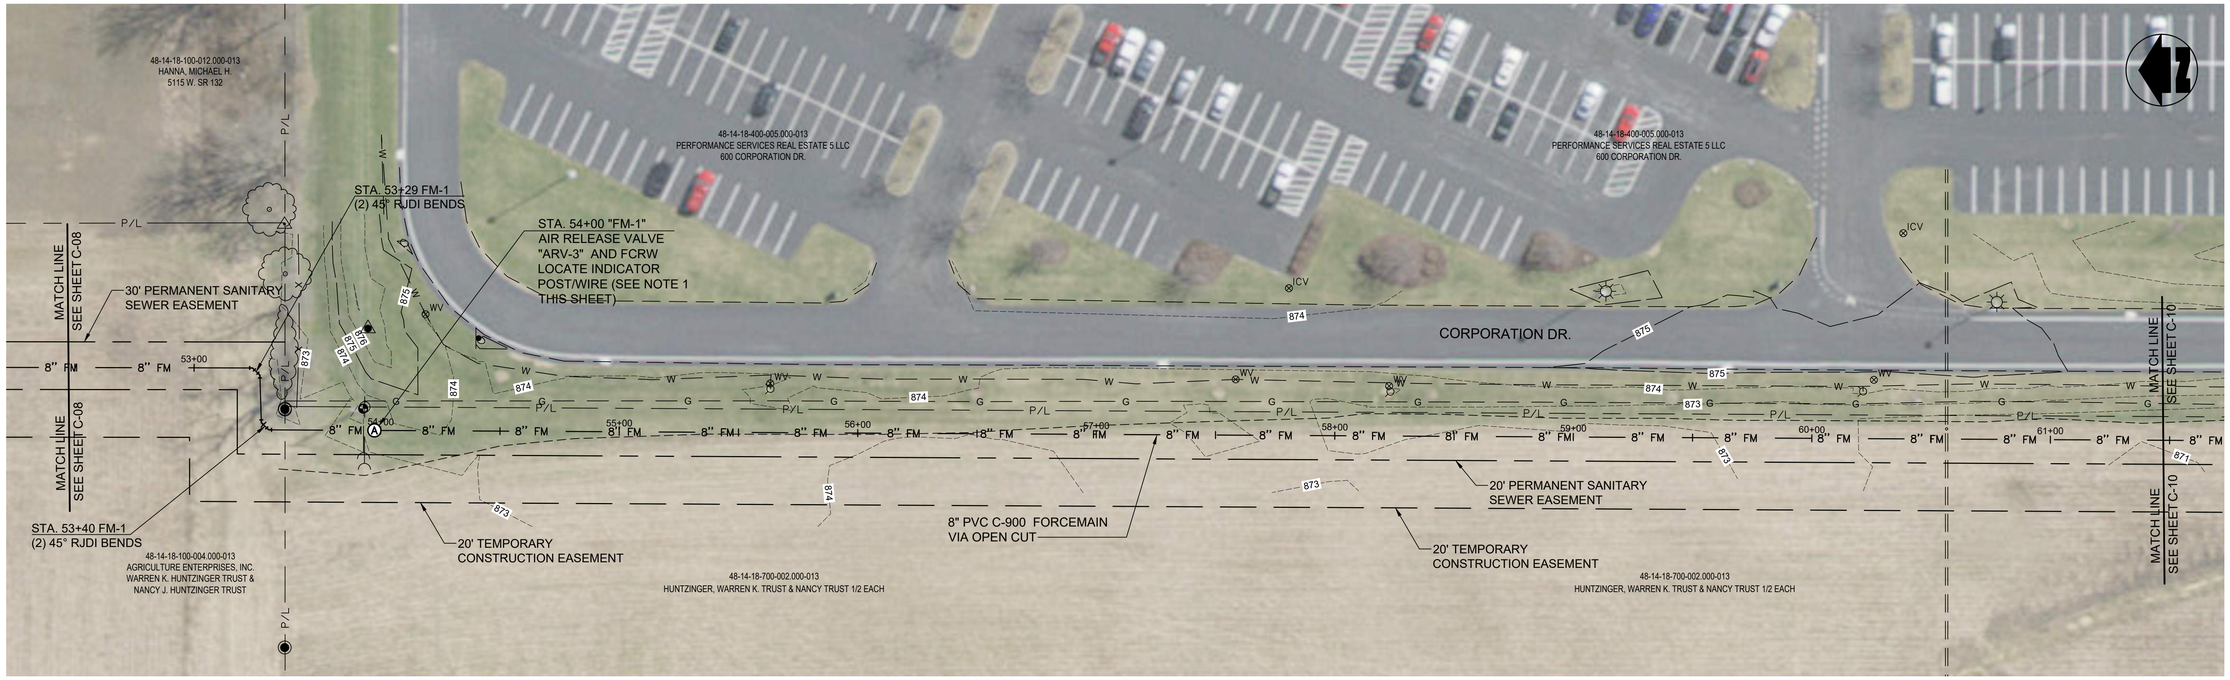

PLAN VIEW - STA. 52+50 TO STA. 61+50 LINE "FM-1"

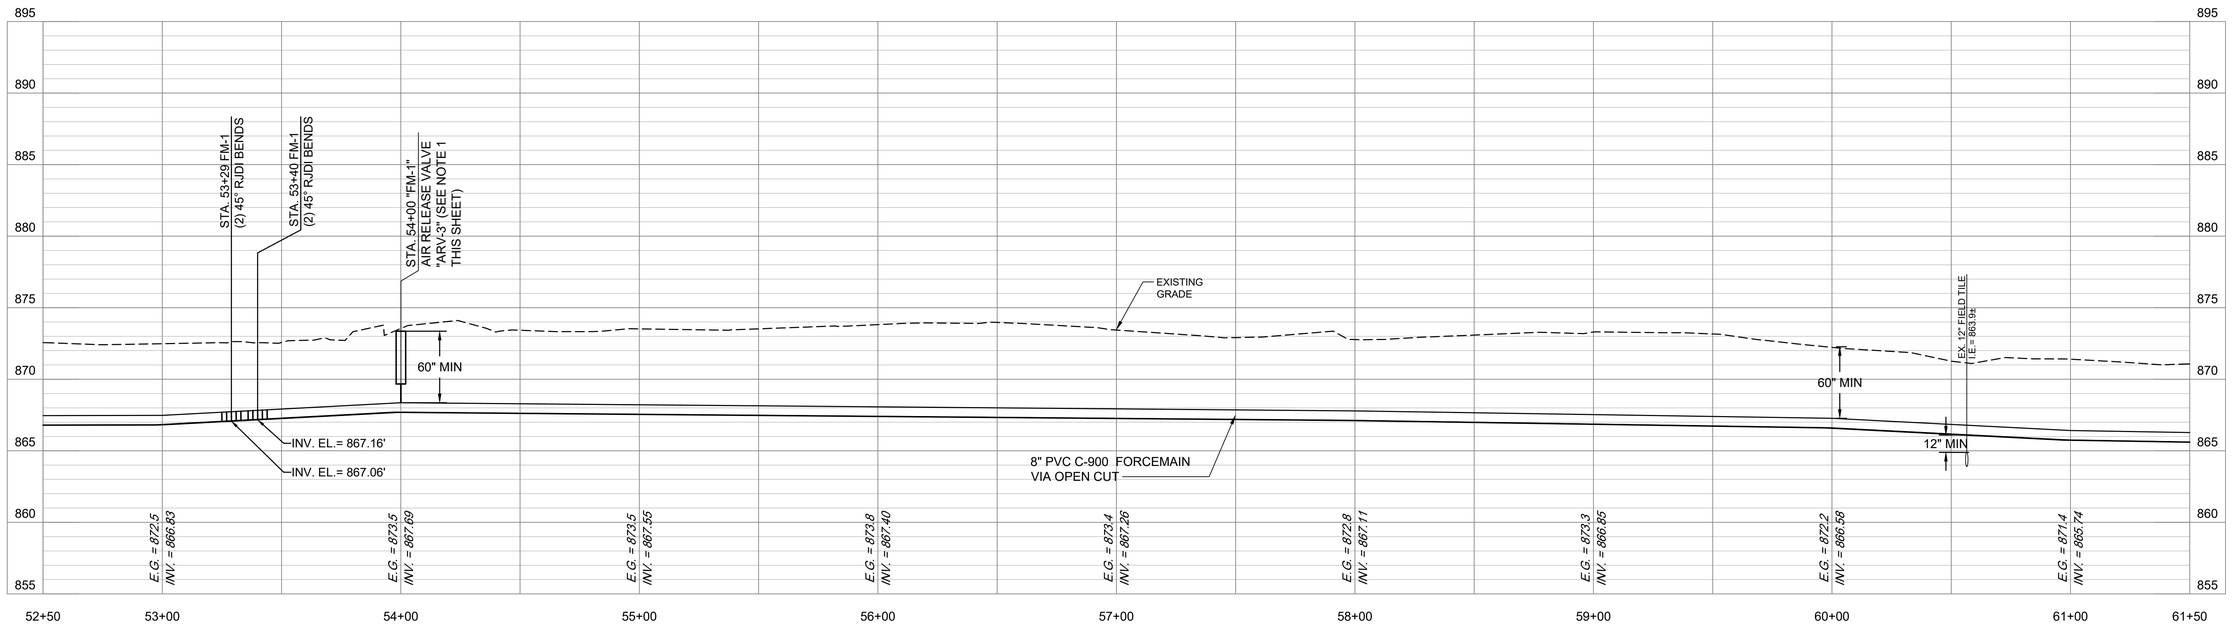

PROFILE - STA. 52+50 TO STA. 61+50 LINE "FM-1"

NOTES:
1. ARV VAULT SHALL BE KEPT AS NEAR AS PRACTICAL TO THE PROPERTY LINE AND OUT OF CROP FIELD. INSTALL REMOTE ARV OTHERWISE. (SEE DETAIL SHEET C-12)

THIS RECORD DOCUMENT HAS BEEN PREPARED BASED ON INFORMATION PROVIDED BY THE CONSTRUCTION CONTRACTOR. GRW ENGINEERS, INC. HAS ATTEMPTED TO VERIFY THE ACCURACY AND/OR COMPLETENESS OF THIS INFORMATION BUT SHALL NOT BE RESPONSIBLE FOR ANY ERRORS OR OMISSIONS WHICH MAY BE INCORPORATED HEREIN AS A RESULT.

engineering | architecture | geospatial

ENGINEER/ARCHITECT: JOSEPH P. TIERNEY

CONSTRUCTION COMPANY: B.L. BROWN COSNTRUCTION

DATE: 08/29/2023

HORIZONTAL SCALE: 1" = 30'-0"
0 15' 30' 60' 90'

VERTICAL SCALE: 1"=5'
0 5'

This document, originally issued, sealed, and signed by Joseph P Tierney, Indiana Professional Engineer, No.19300407, on July 2022, shall not be used in lieu of a certified document.

RECORD DWG

GRW PROJECT NO. 4923
CLIENT PROJECT NO. --

ALL RIGHTS RESERVED:
THIS DOCUMENT IS THE PROPERTY OF GRW ENGINEERS, INC. AND MAY NOT BE REPRODUCED IN WHOLE OR IN PART OR TRANSMITTED TO ANY PERSON OTHER THAN THIS SPECIFIC PROJECT WITHOUT WRITTEN PERMISSION

engineering | architecture | geospatial
www.grwinc.com

PLAN AND PROFILE - LINE "FM-1"
STA. 52+50 TO 61+50
NEW LIFT STATION AND FORCEMAIN
TOWN OF PENDLETON, INDIANA

DESIGNED:	JPT
DRAWN:	AMR
REVIEWED:	JPT
APPROVED:	JPT

REVISIONS

NO.	DESCRIPTION:	DATE:	BY:
1	ADDENDUM #1	9/9/22	LAD

THIS MARK SHOULD MEASURE EXACTLY 1" WHEN PLOTTED
SCALE CHECK

DATE: JULY 2022
SCALE: H: 1"=30' V: 1"=5'
SHEET NO. C-09

PLOTTED BY: ARowley
PRINTED: 9/6/2023 @ 12:53PM
FILE NAME: G:\4923-FCRWD-SW\Working Drawings\AutoCAD\4923-C-09.dwg