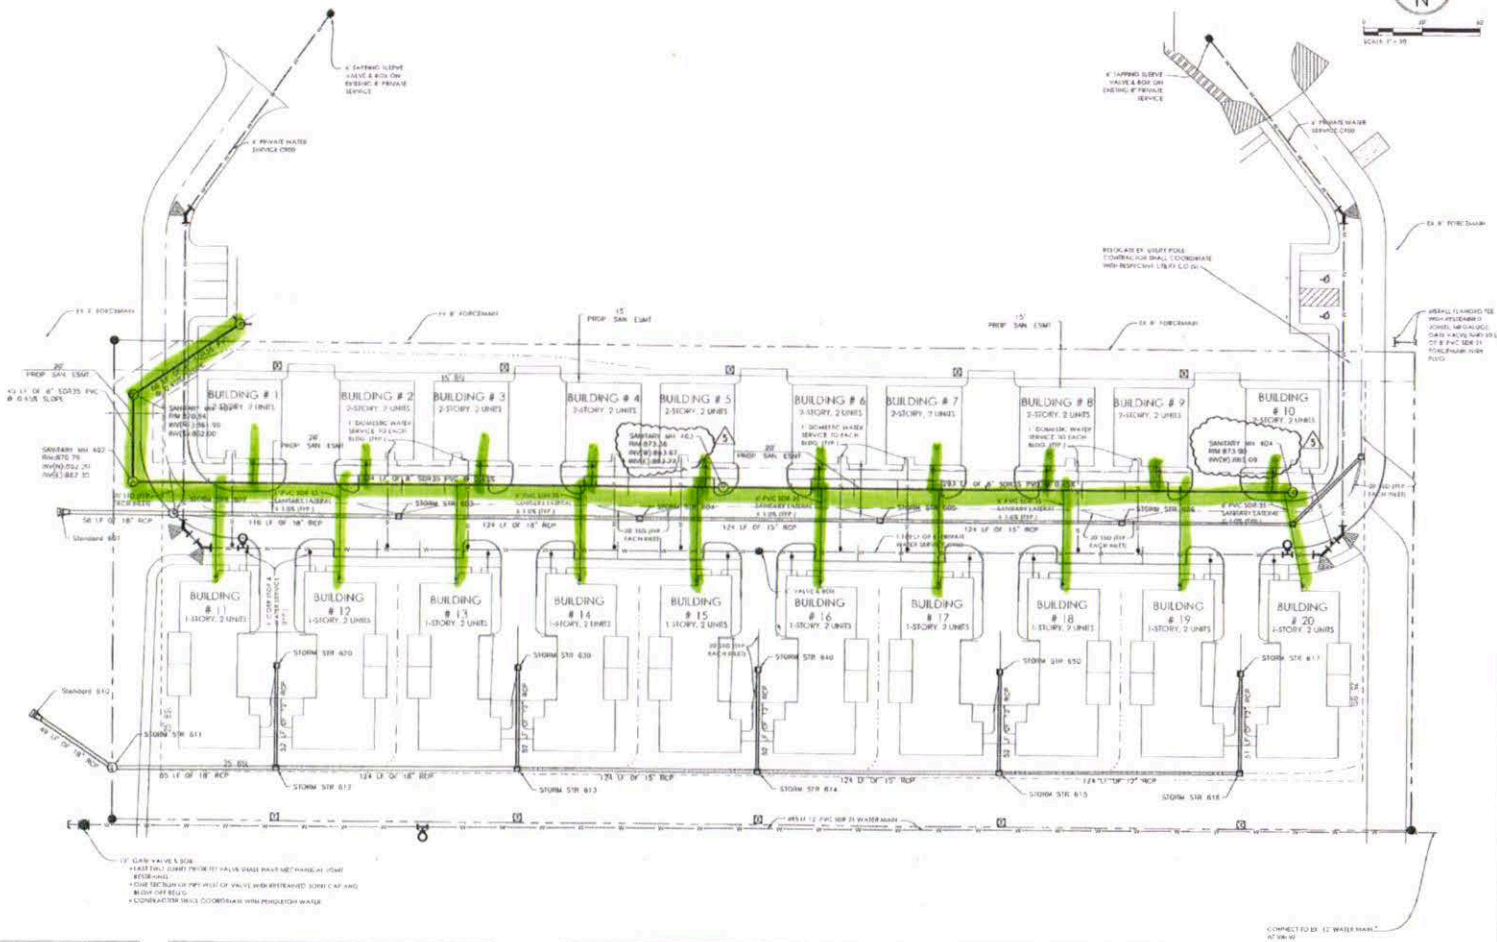

STORM STRUCTURE DATA TABLE				
STRUCTURE NO	RIM	NEENAH CASTING DESIGNATION	STRUCTURE TYPE	NOTES
601	867.63	N/A	CONCRETE F.E.S.	Pipe End Section
602	870.48	R-3286-BY	Standard	Manhole Type-C
603	870.89	R-3472	Standard	Inlet Type-A
604	871.20	R-3472	Standard	Inlet Type-A
605	871.63	R-3472	Standard	Inlet Type-A
606	872.00	R-3472	Standard	Inlet Type-A
607	872.90	R-3472	Standard	Inlet Type-A
608	871.80	R-3472	Standard	Inlet Type-A
610	869.94	N/A	CONCRETE F.E.S.	Pipe End Section
611	870.32	R-1772	Standard	Manhole Sheet

STORM STRUCTURE DATA TABLE				
STRUCTURE NO	RIM	NEENAH CASTING DESIGNATION	STRUCTURE TYPE	NOTES
612	870.89	R-4342	Standard	Inlet Type-A
613	871.09	R-4342	Standard	Inlet Type-A
614	871.36	R-4342	Standard	Inlet Type-A
615	871.55	R-4342	Standard	Inlet Type-A
616	871.79	R-4342	Standard	Inlet Type-A
617	872.87	R-3472	Standard	Inlet Type-A
620	871.87	R-3472	Standard	Inlet Type-A
630	872.12	R-3472	Standard	Inlet Type-A
640	872.57	R-3472	Standard	Inlet Type-A
650	872.82	R-3472	Standard	Inlet Type-A

STORM PIPE DATA TABLE						
UPSTREAM STRUCTURE NO	DOWNSTREAM STRUCTURE NO	L.F.	SIZE / TYPE	SLOPE %	UPSTREAM INV	DOWNSTREAM INV
602	601	38	18" RCP	0.30%	863.61	863.37
603	602	116	18" RCP	0.30%	866.07	863.61
604	603	124	18" RCP	0.30%	867.34	866.07
605	604	124	15" RCP	0.30%	867.92	866.59
606	605	124	15" RCP	0.30%	867.39	867.02
607	606	66	12" RCP	0.30%	867.53	867.39
608	607	50	12" RCP	0.30%	868.10	867.85
611	610	44	18" RCP	0.10%	863.13	863.13
612	611	65	18" RCP	0.10%	865.63	865.63
613	612	124	18" RCP	0.30%	866.26	865.37

STORM PIPE DATA TABLE						
UPSTREAM STRUCTURE NO	DOWNSTREAM STRUCTURE NO	L.F.	SIZE / TYPE	SLOPE %	UPSTREAM INV	DOWNSTREAM INV
614	613	124	15" RCP	0.30%	866.91	866.40
615	614	124	15" RCP	0.30%	867.34	866.91
616	615	124	15" RCP	0.30%	867.81	867.40
617	616	31	12" RCP	0.30%	868.00	867.81
620	617	32	12" RCP	0.30%	867.90	867.74
630	620	32	12" RCP	0.30%	868.30	868.14
640	630	32	12" RCP	0.30%	868.90	868.74
650	640	32	12" RCP	0.30%	869.00	868.84

NOTES:
1. ALL HYDRANTS SHALL BE MARKED WITH STORM HYDRANT MARKERS. EACH HYDRANT SHALL HAVE A VALVE AND BOX.
2. ONLY PRIVATE HYDRANTS SHALL BE PAINTED RED.
3. PUBLIC / OTHER HYDRANTS SHALL BE PAINTED CATERPILLAR YELLOW.

CIVIL ENGINEERS
LAND SURVEYORS
DEVELOPMENT CONSULTANTS
GEOTECHNICAL
ENVIRONMENTAL
CONSTRUCTION STAKING
CONSTRUCTION MATERIALS

TERRA SITE DEVELOPMENT

REVISIONS		
NO.	DATE	DESCRIPTION
1	7/15/2016	PER CITY COMMENTS
2	7/18/2016	PER CITY COMMENTS
3	7/25/2016	PER CITY COMMENTS
4	8/26/2016	PER CITY COMMENTS
