GENERAL NOTES

1. ALL DIMENSIONS ARE BASED ON FACE OF CURB OR FACE OF BUILDING.
2. ALL RADII ARE 5' UNLESS NOTED OTHERWISE.
3. SEE ARCHITECTURAL PLANS FOR DETAILS OF BUILDING AND BUILDING DIMENSIONS. DO NOT STAKE BUILDING FROM THESE PLANS.
4. * DIMENSIONS INDICATE FIELD DIMENSION ADJUSTMENT AREA BASED ON ACTUAL FIELD LAYOUT COORDINATES.
5. ENTRANCE SIGN AND PLANTING BY OTHERS. COORDINATE DESIGN, SIZE AND LOCATION WITH SHEEHAN CONSTRUCTION CO., INC.
6. OTHER SITE SIGNAGE BY OTHERS. COORDINATE DESIGN, SIZE AND LOCATION WITH SHEEHAN CONSTRUCTION CO., INC.
7. ENTRANCE SIGN SEE ARCHITECTURAL PLANS. COORDINATE LANDSCAPING AROUND ENTRANCE SIGN WITH SHEEHAN CONSTRUCTION CO., INC.

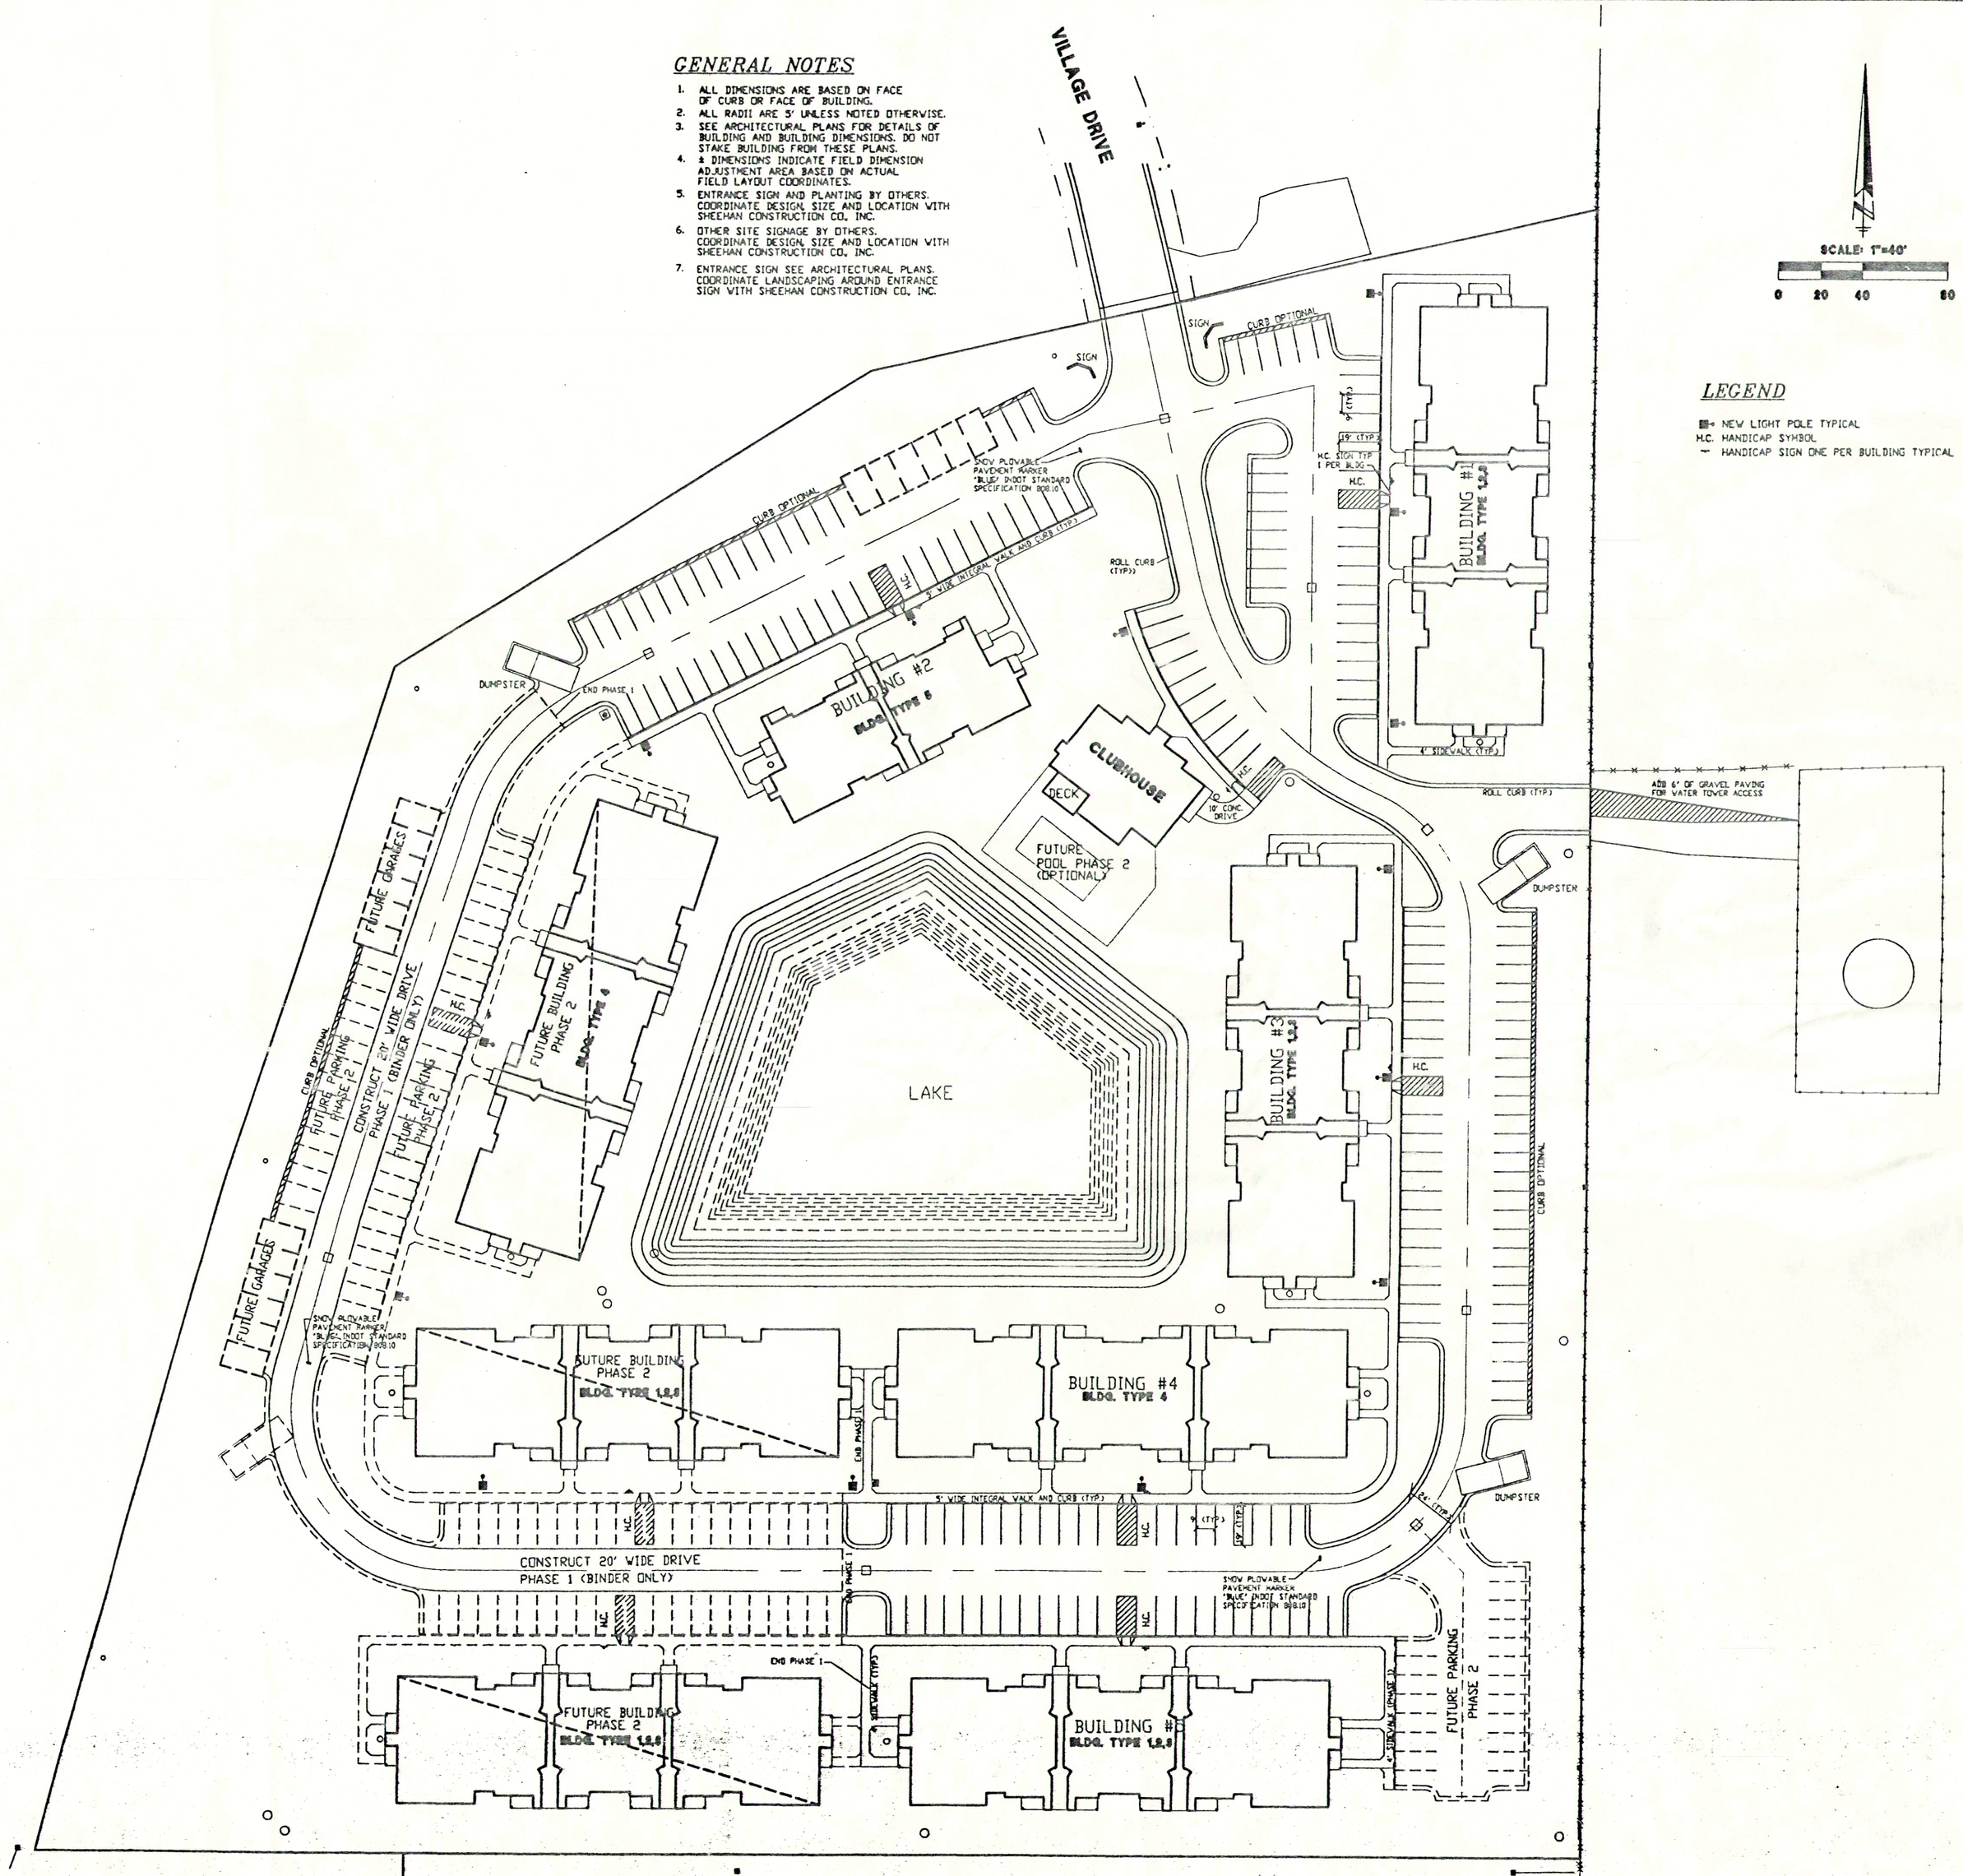

LEGEND

- NEW LIGHT POLE TYPICAL
- H.C. HANDICAP SYMBOL
- HANDICAP SIGN ONE PER BUILDING TYPICAL

WEIHE ENGINEERS, INC.
10505 NORTH COLLEGE AVENUE
INDIANAPOLIS, INDIANA 46280
(317) 846-6611 LOCAL 463-0545
TOLL-FREE (800) 452-6409
ALLAN H. WEIHE, P.E., L.S. PRESIDENT
DONALD R. LAMONT, L.S. VICE-PRESIDENT
CIVIL ENGINEERS • LAND SURVEYORS • LAND PLANNERS • LANDSCAPE ARCHITECTS

DATE	BY	REVISIONS

PROJECT NO. 98-06-06
DRAWING NO. 9806060C2.DWG
FIELD BY: FIELD BOOKS 777
DRAWN BY: DONALD R. LAMONT
CHECKED BY: ALLAN H. WEIHE
SCALE: 1"=40'
DATE: 22 MARCH 98
PAGES 75-77

ALLAN H. WEIHE REGISTERED No. 8827 STATE OF INDIANA PROFESSIONAL ENGINEER

ALLAN H. WEIHE P.E. 8827

PREPARED FOR:

PENDLETON PLACE APARTMENTS

SHEEHAN CONSTRUCTION CO., INC.

LAYOUT PLAN

Part of the NE/4, Section 15, Twp. 18 North, Range 5 East, Fall Creek Twp., Hamilton County, Indiana

SHEET NO.

C2