Township: Fall Creek Township
Section 19 Twp. 18 Range 7E
Project: Rolls First Addition to Pendleton
Location: Pendleton, Indiana
Pump Data: Discharge Size 4"
GPM 330
TDH 38.5
HP (Min.) 7.5
RPM (Max.) 1750
Voltage 230
Phase Three
Station Pipe Size: 6"
Force Main Size 8" Type PVC

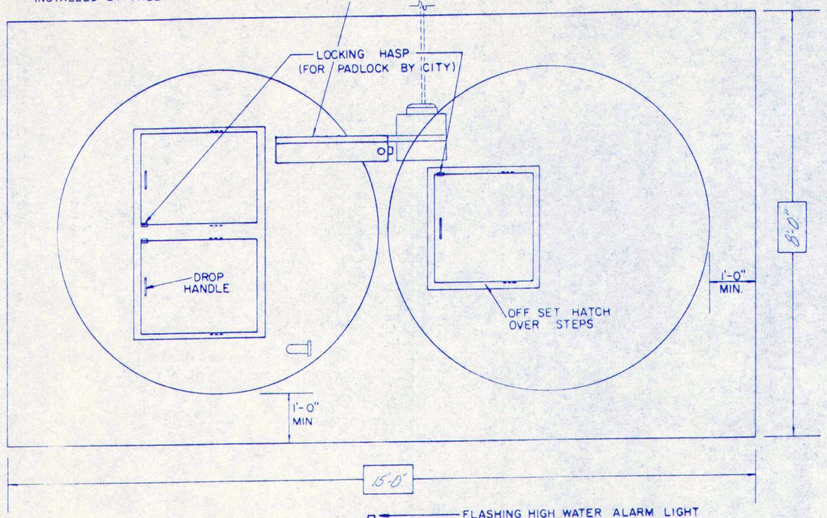

NOTES: 1. SEE FALL CREEK REGIONAL WASTE DISTRICT SUBMERSIBLE LIFT STATION STANDARD FOR DETAILS OF EQUIPMENT.

2. ACCESS DRIVE FROM NEAREST PUBLIC RIGHT OF WAY TO LIFT STATION PAD TO BE PROVIDED.

3. THIS PLAN IS FOR DESIGN PURPOSES ONLY. SHOP DRAWINGS TO BE PROVIDED BY LIFT STATION MANUFACTUER. FINAL SHOP DRAWINGS TO BE APPROVED BY PROJECT ENGINEER & APPLICABLE GOVERNMENTAL AGENCIES.

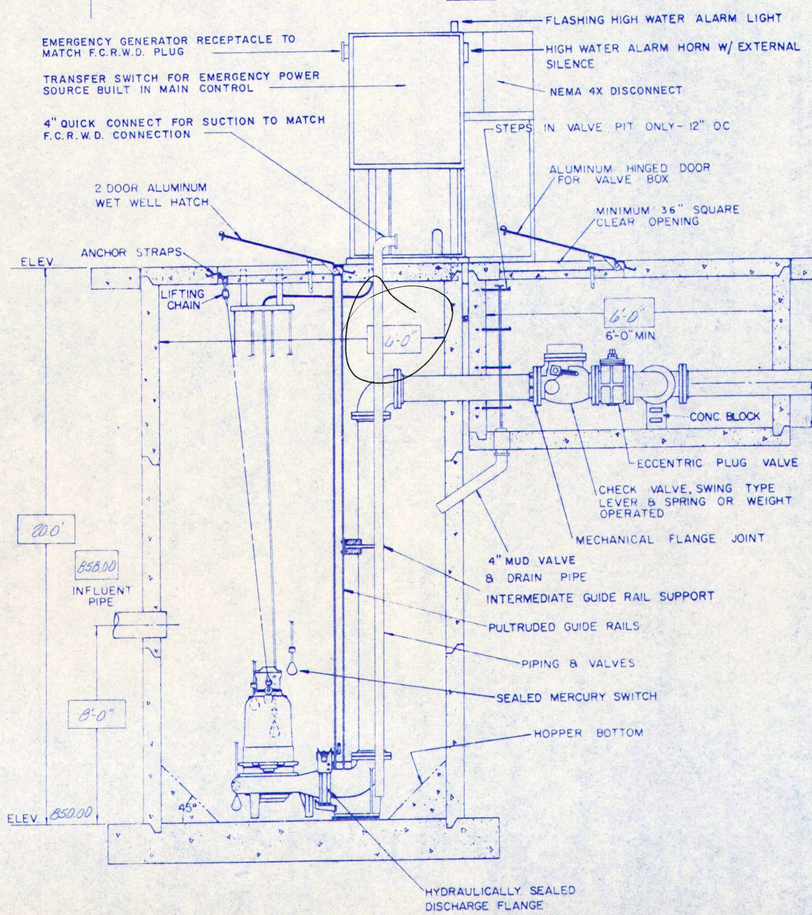

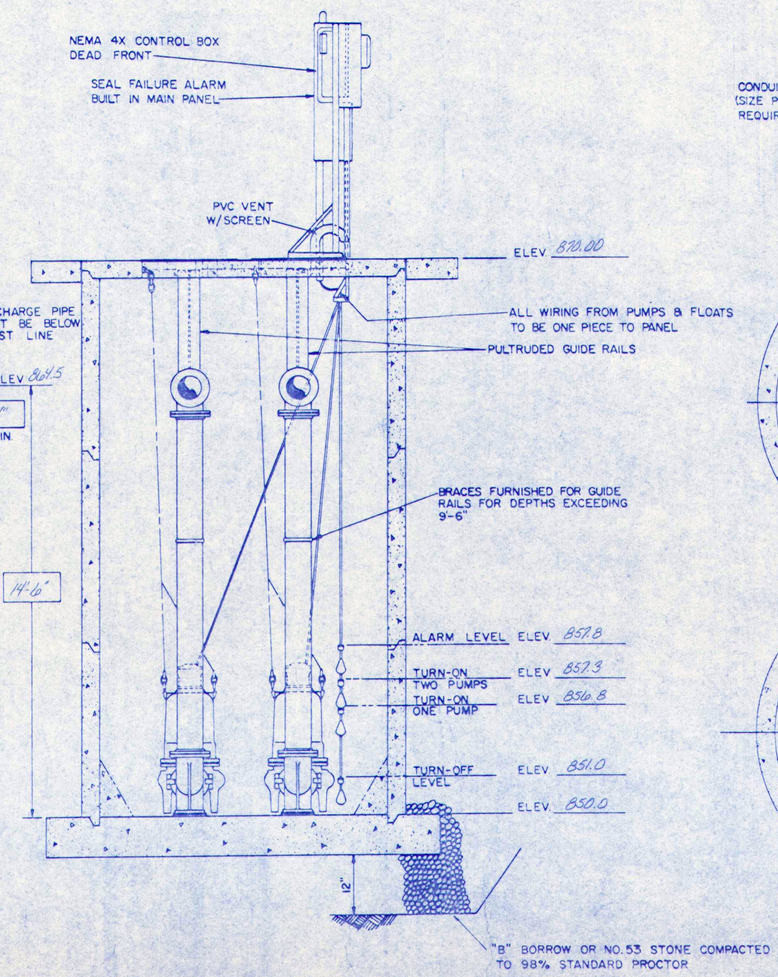

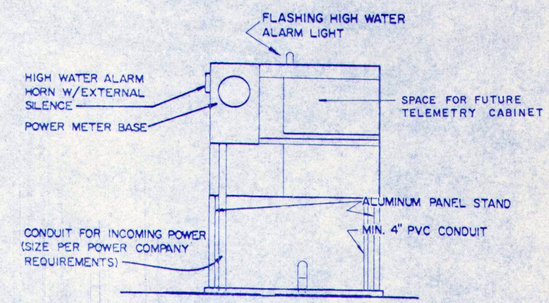

REAR VIEW OF CONTROL PANEL

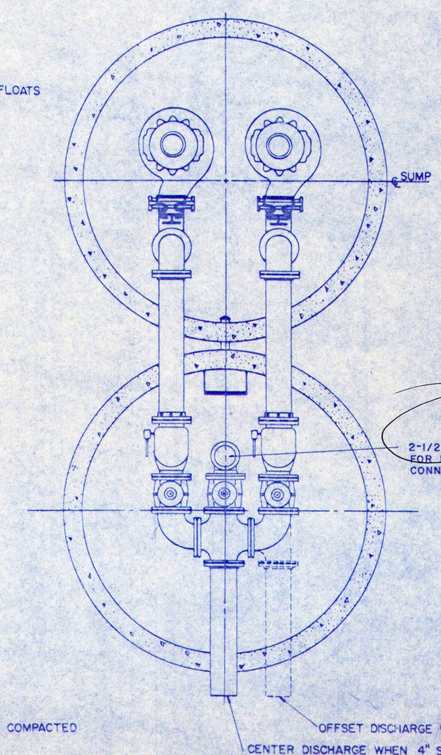

Allan H. Weihe, Reg. P.E. - Indiana # 8827

ALLAN H. WEIHE REGISTERED NO. 8827 STATE OF INDIANA PROFESSIONAL ENGINEER

Prepared For: STEVE PAUL

Lift Station Detail Sheet