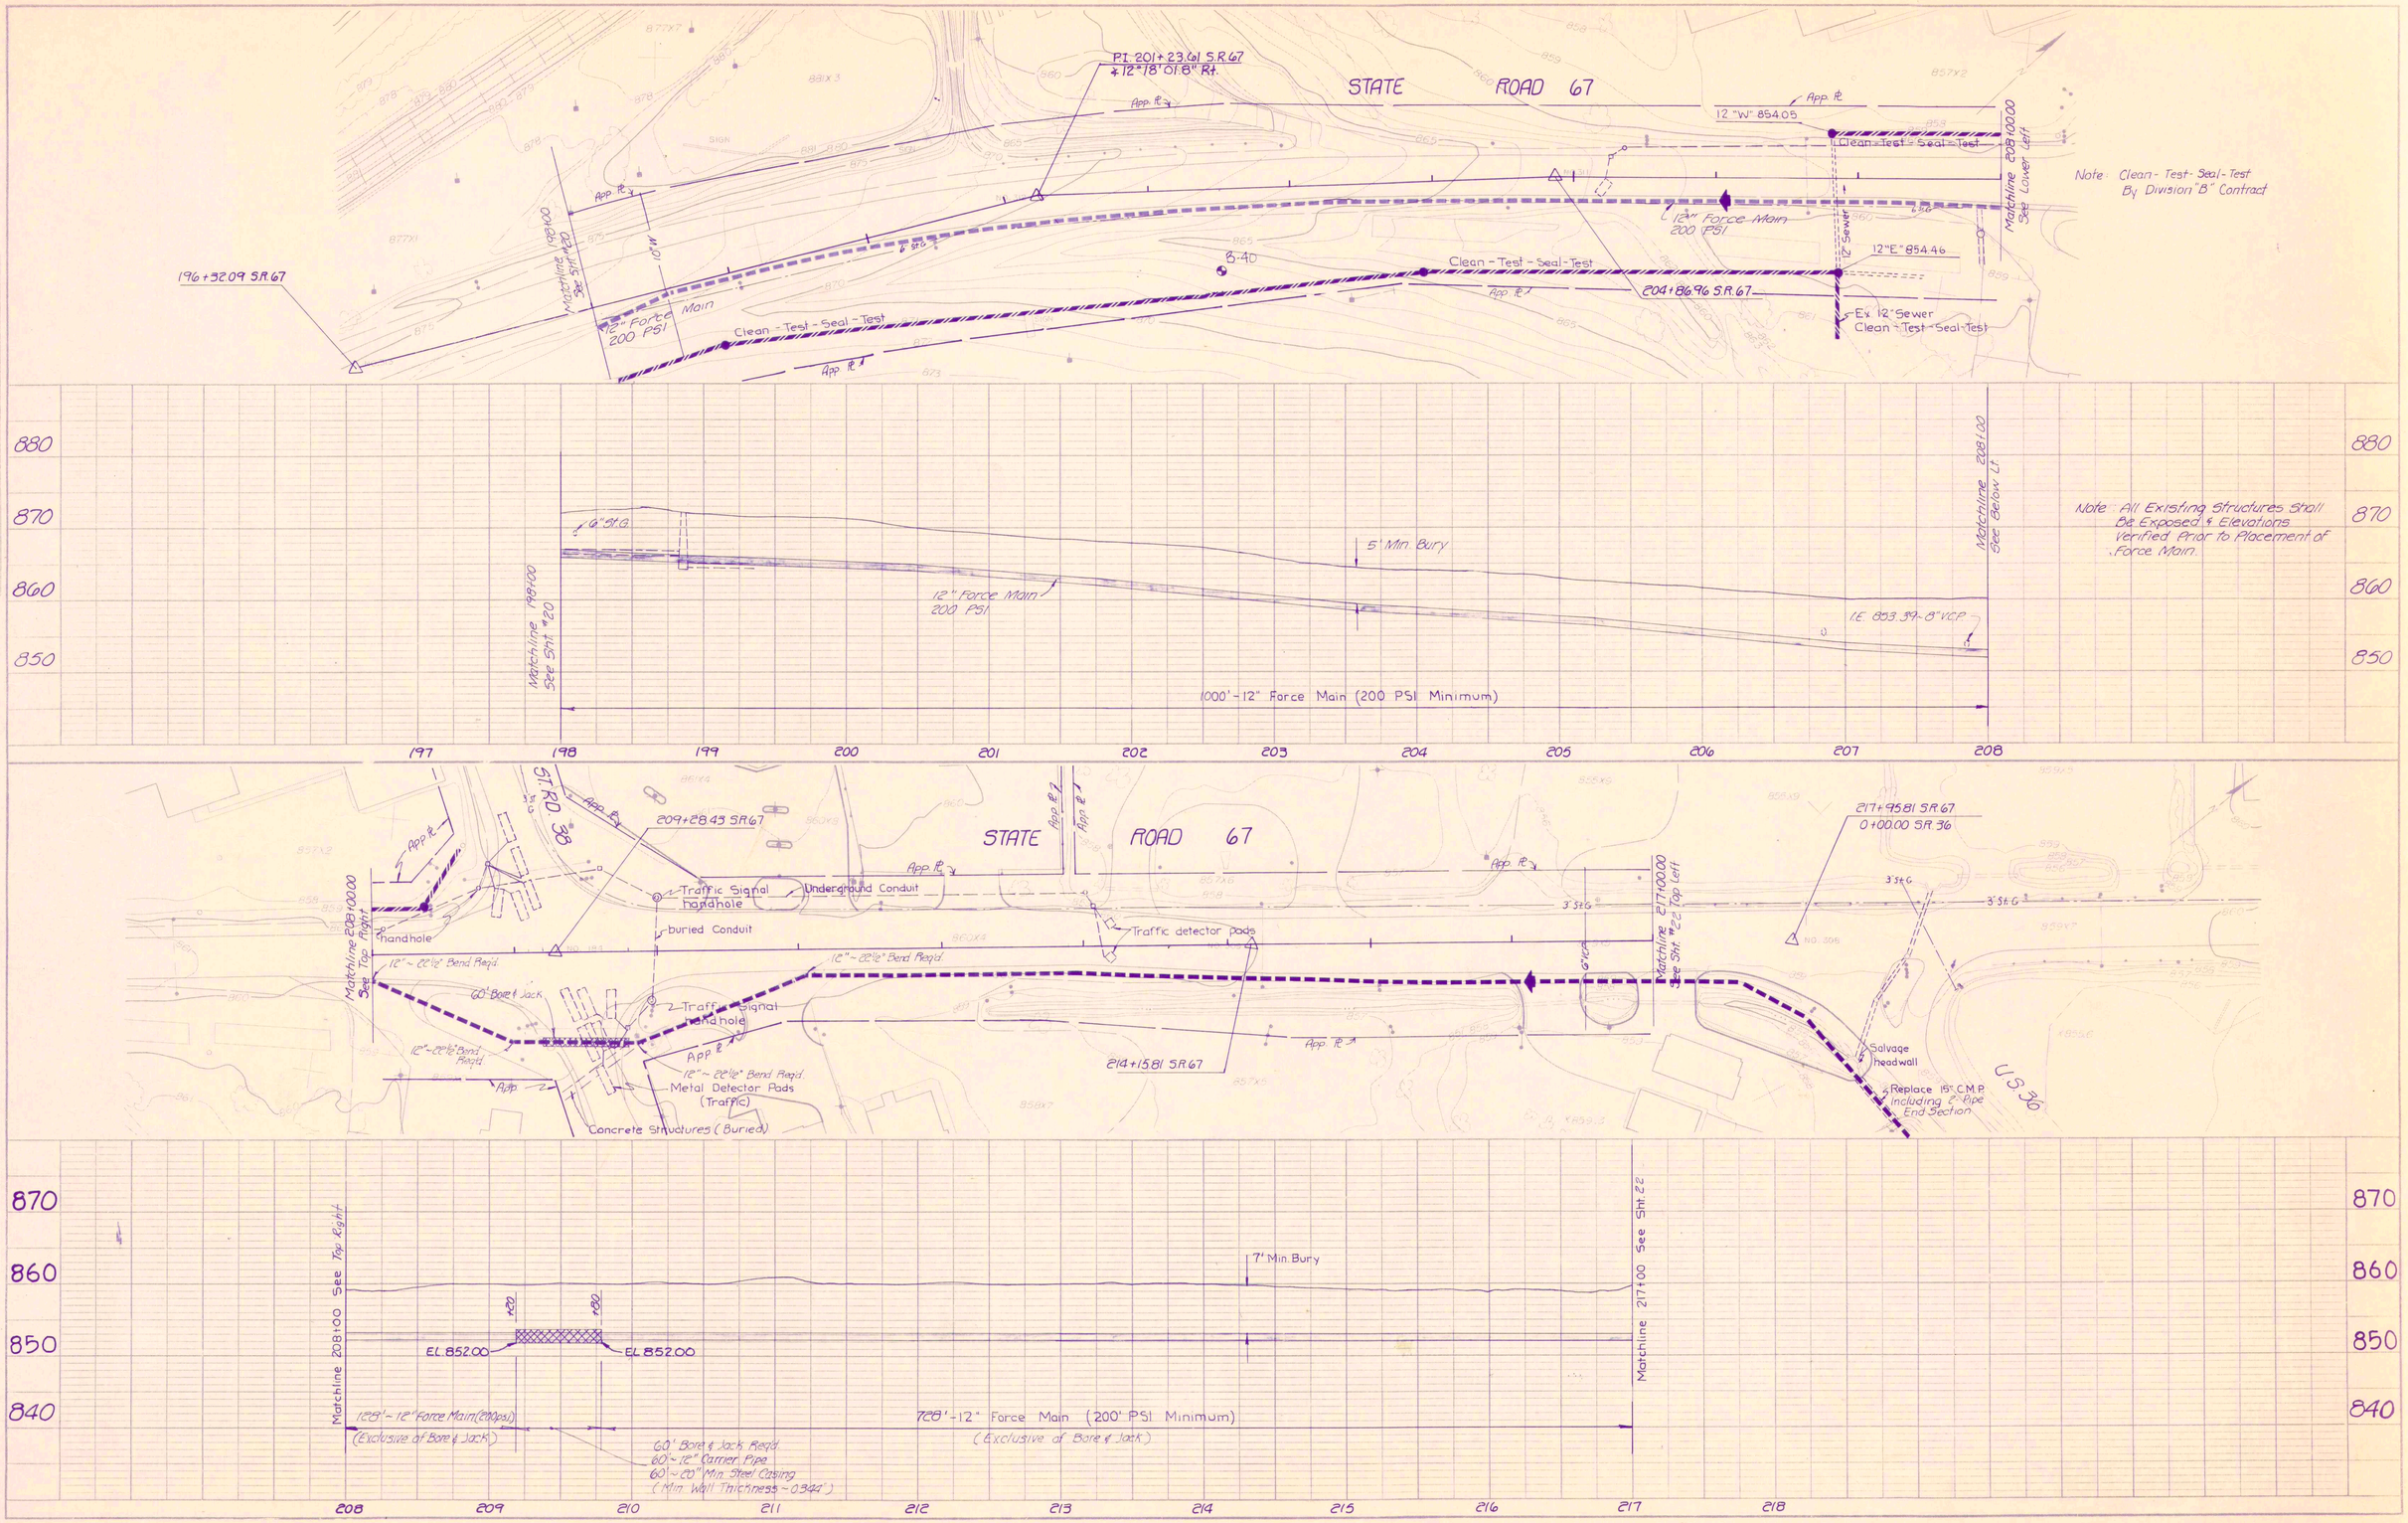

PLAN

PROFILE

RECORD DRAWING

STATE ROAD 67		
FALL CREEK R.W.D. PLAN & PROFILE		SHEET 21
HORIZ. 1" = 50'	BEAM, LONGEST & NEFF, INC. CONSULTING ENGINEERS INDIANAPOLIS, INDIANA	
VERT. 1" = 10'		