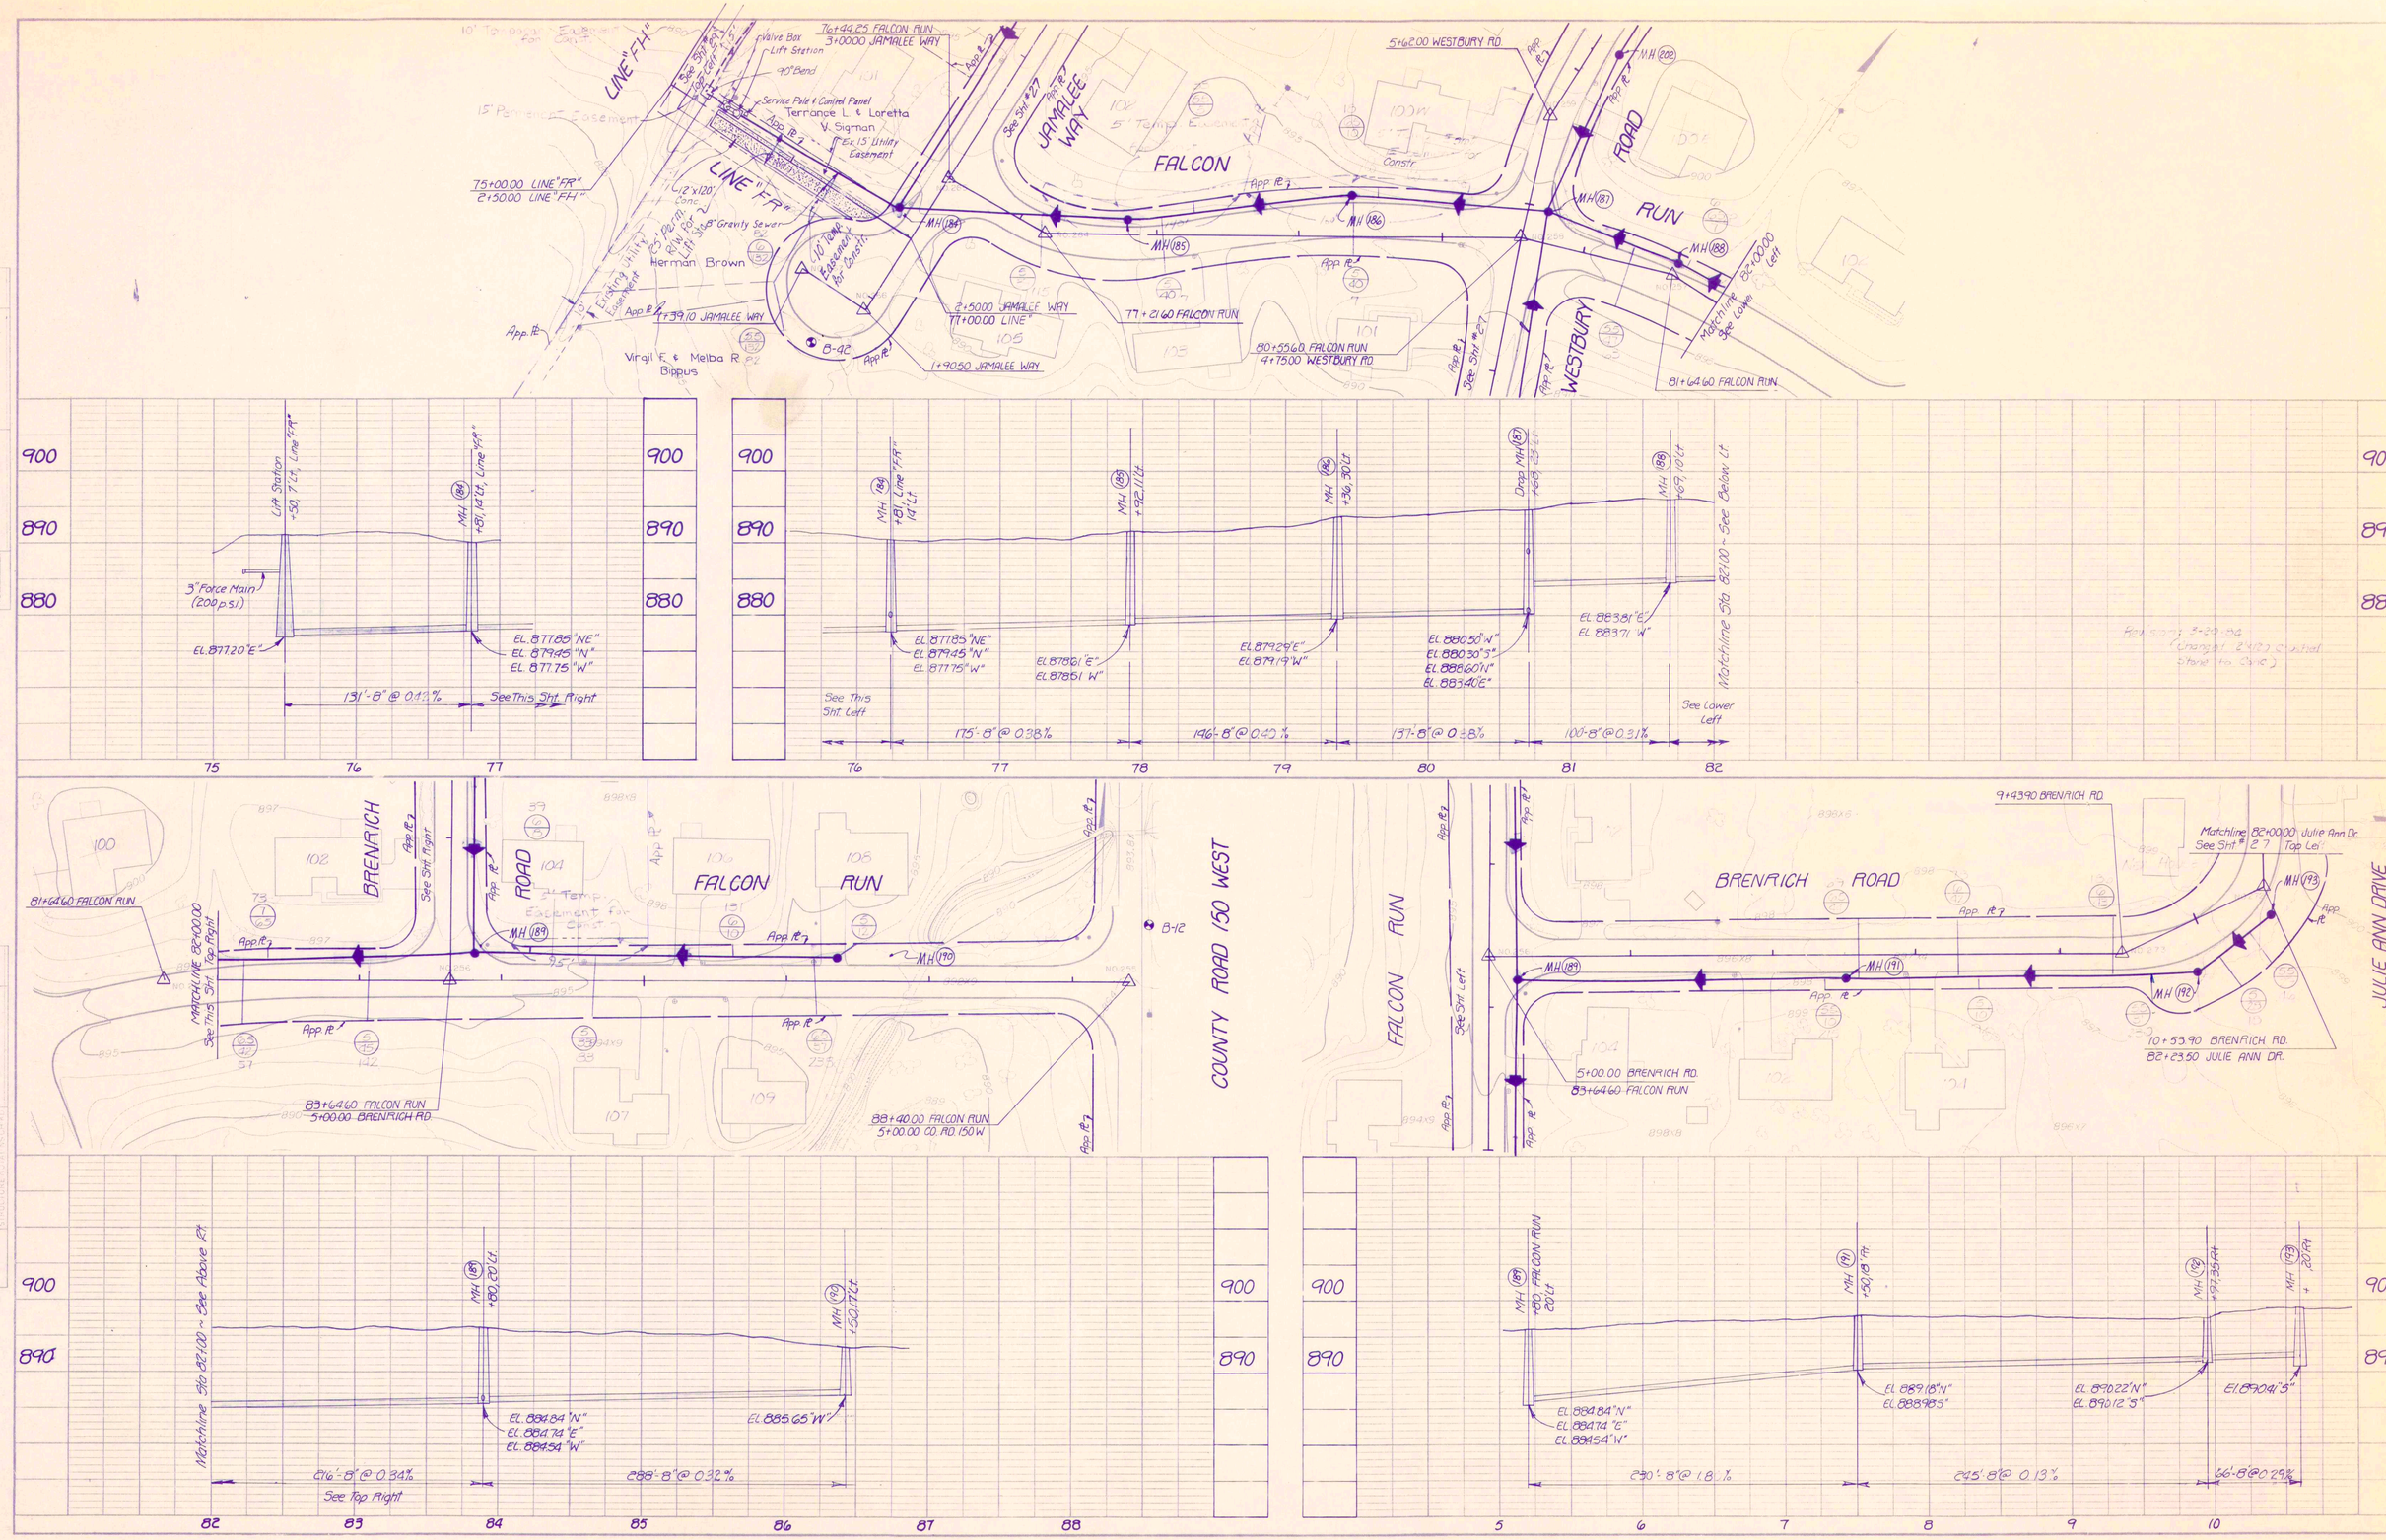

PLAN

PROFILE

RECORD DRAWING

LINE "FR"/ FALCON RUN/ BRENRICH Rd.

FALL CREEK R.W.D. PLAN & PROFILE

HORIZ. 1" = 50'

VERT. 1" = 10'

BEAM, LONGEST & NEFF, INC.
CONSULTING ENGINEERS
INDIANAPOLIS, INDIANA

SHEET 28