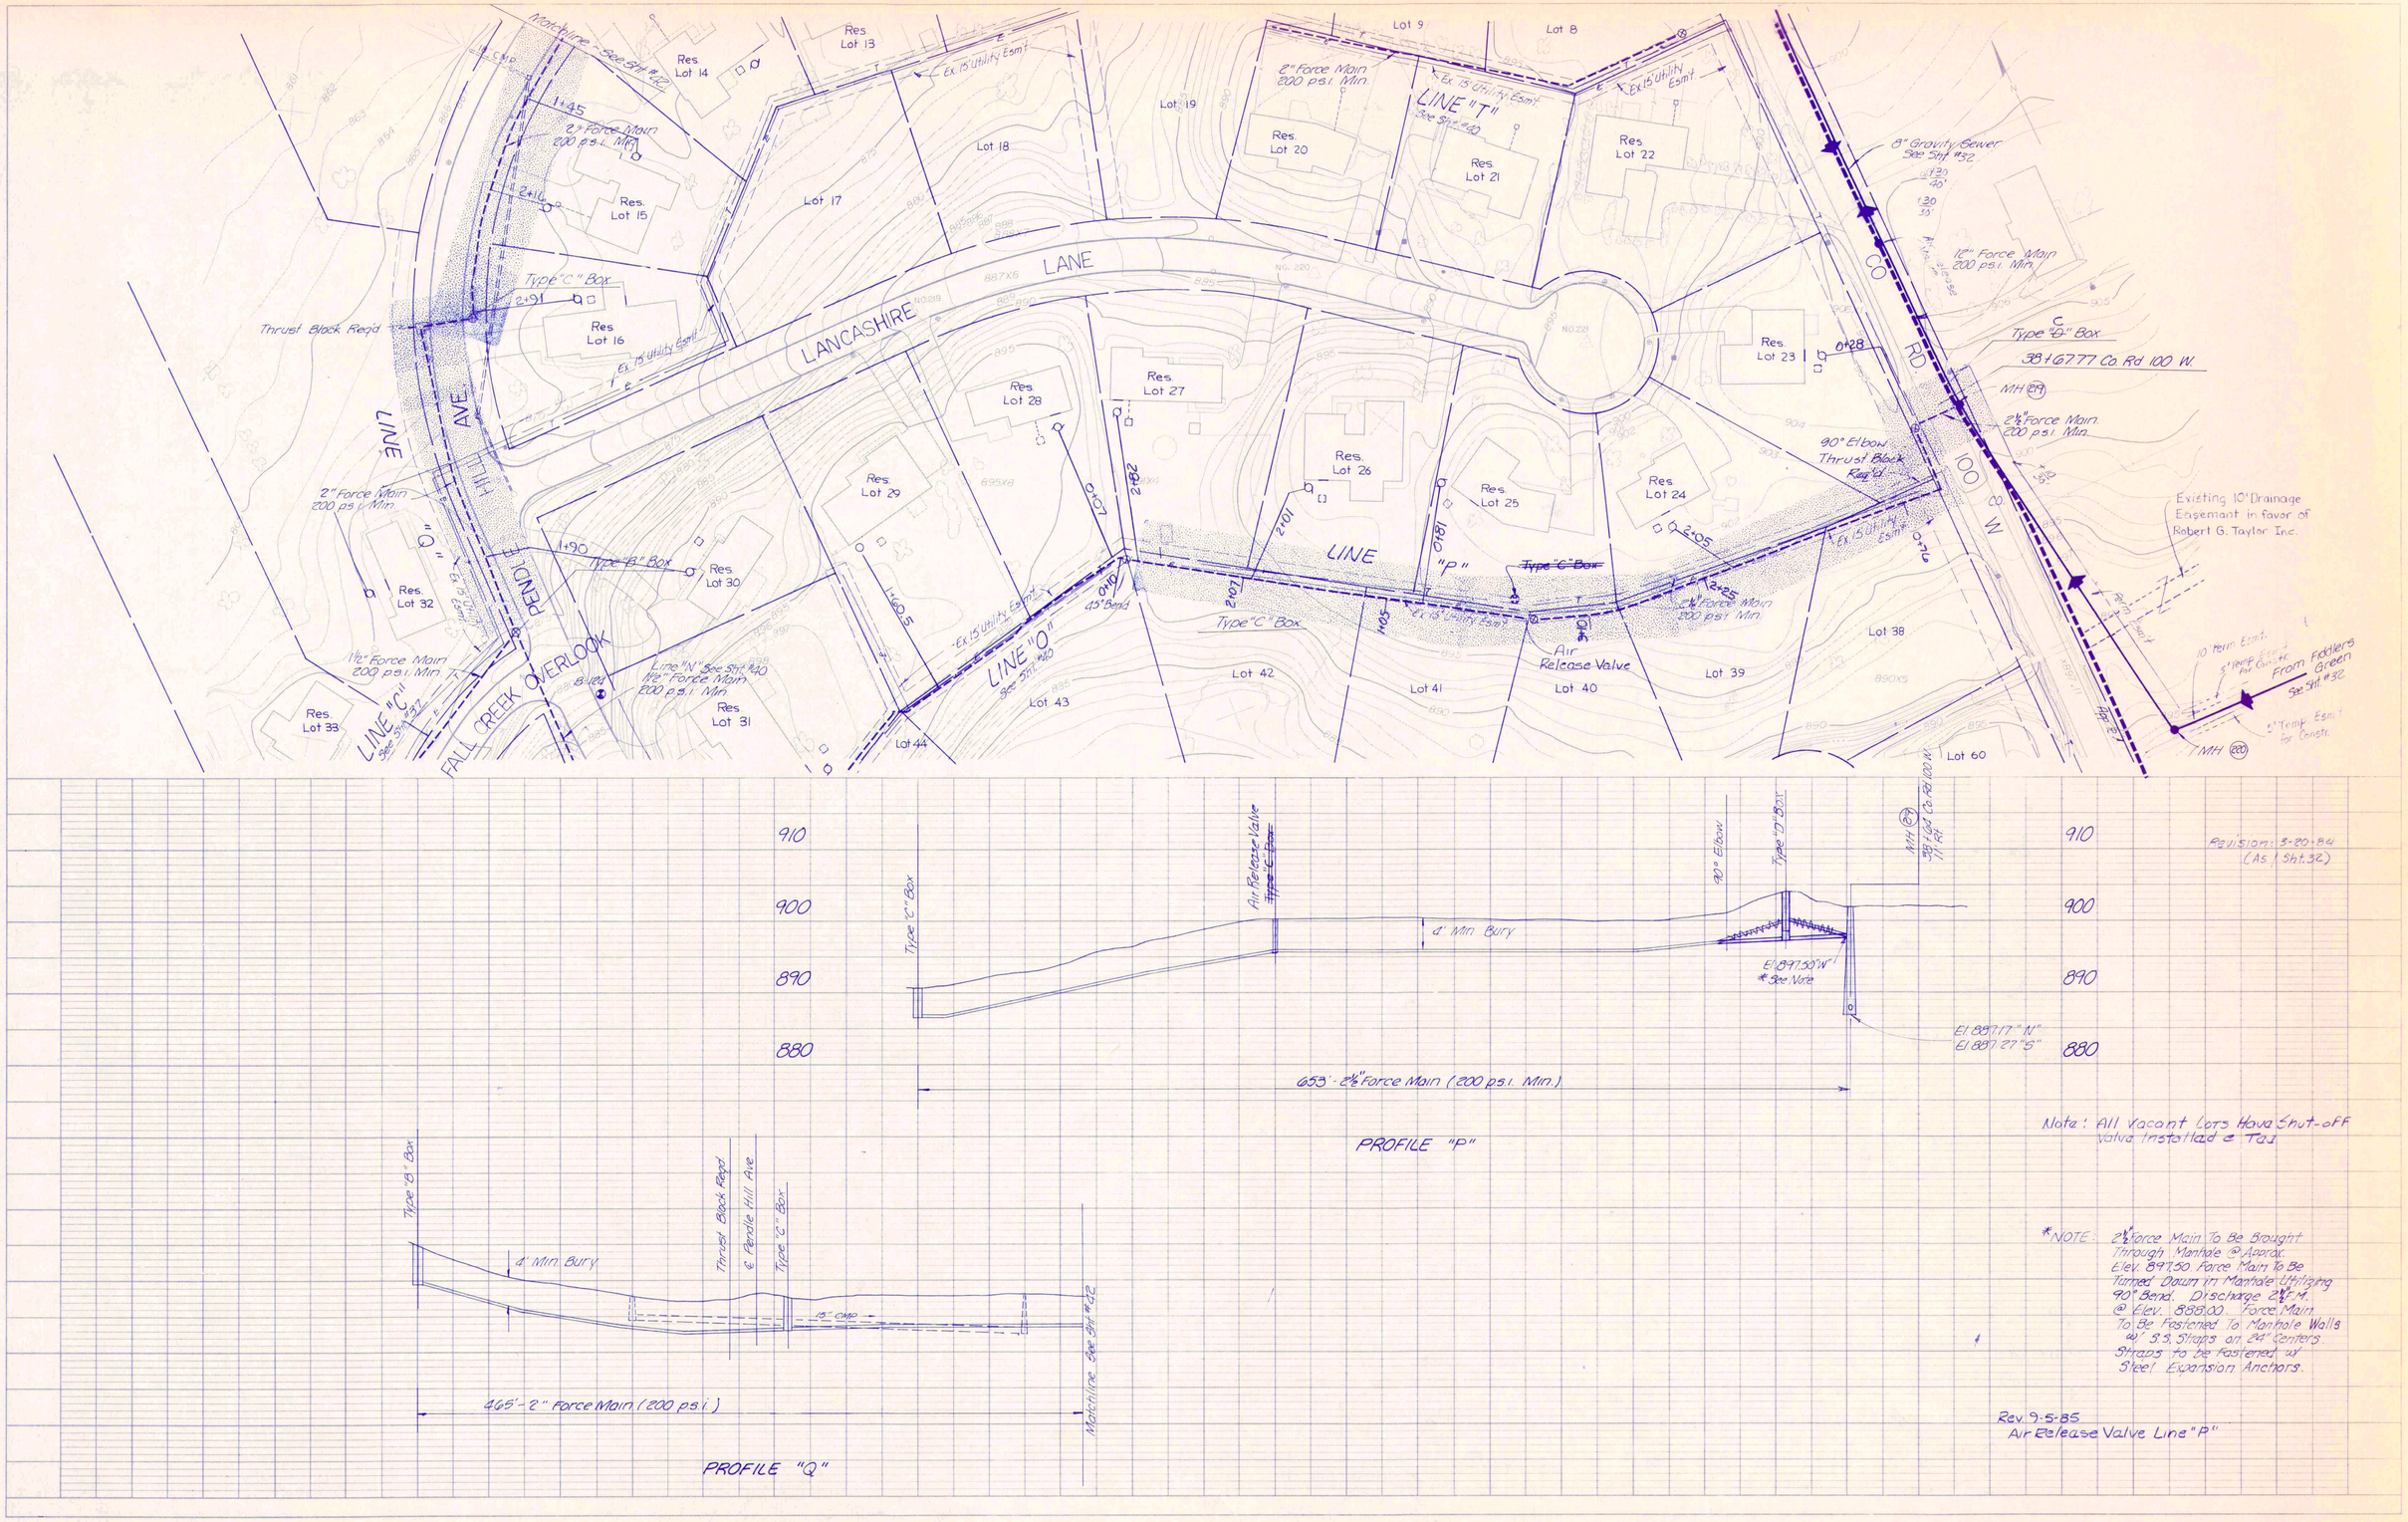

RECORD DRAWING

PENDLE HILL AVE.
LANCASHIRE LN. - CO. RD. 100 W.
FALL CREEK R.W.D. PLAN & PROFILE

HORIZ. 1" = 50'
VERT. 1" = 10'

BEAM, LONGEST & NEFF, INC.
CONSULTING ENGINEERS
INDIANAPOLIS, INDIANA

SHEET 41