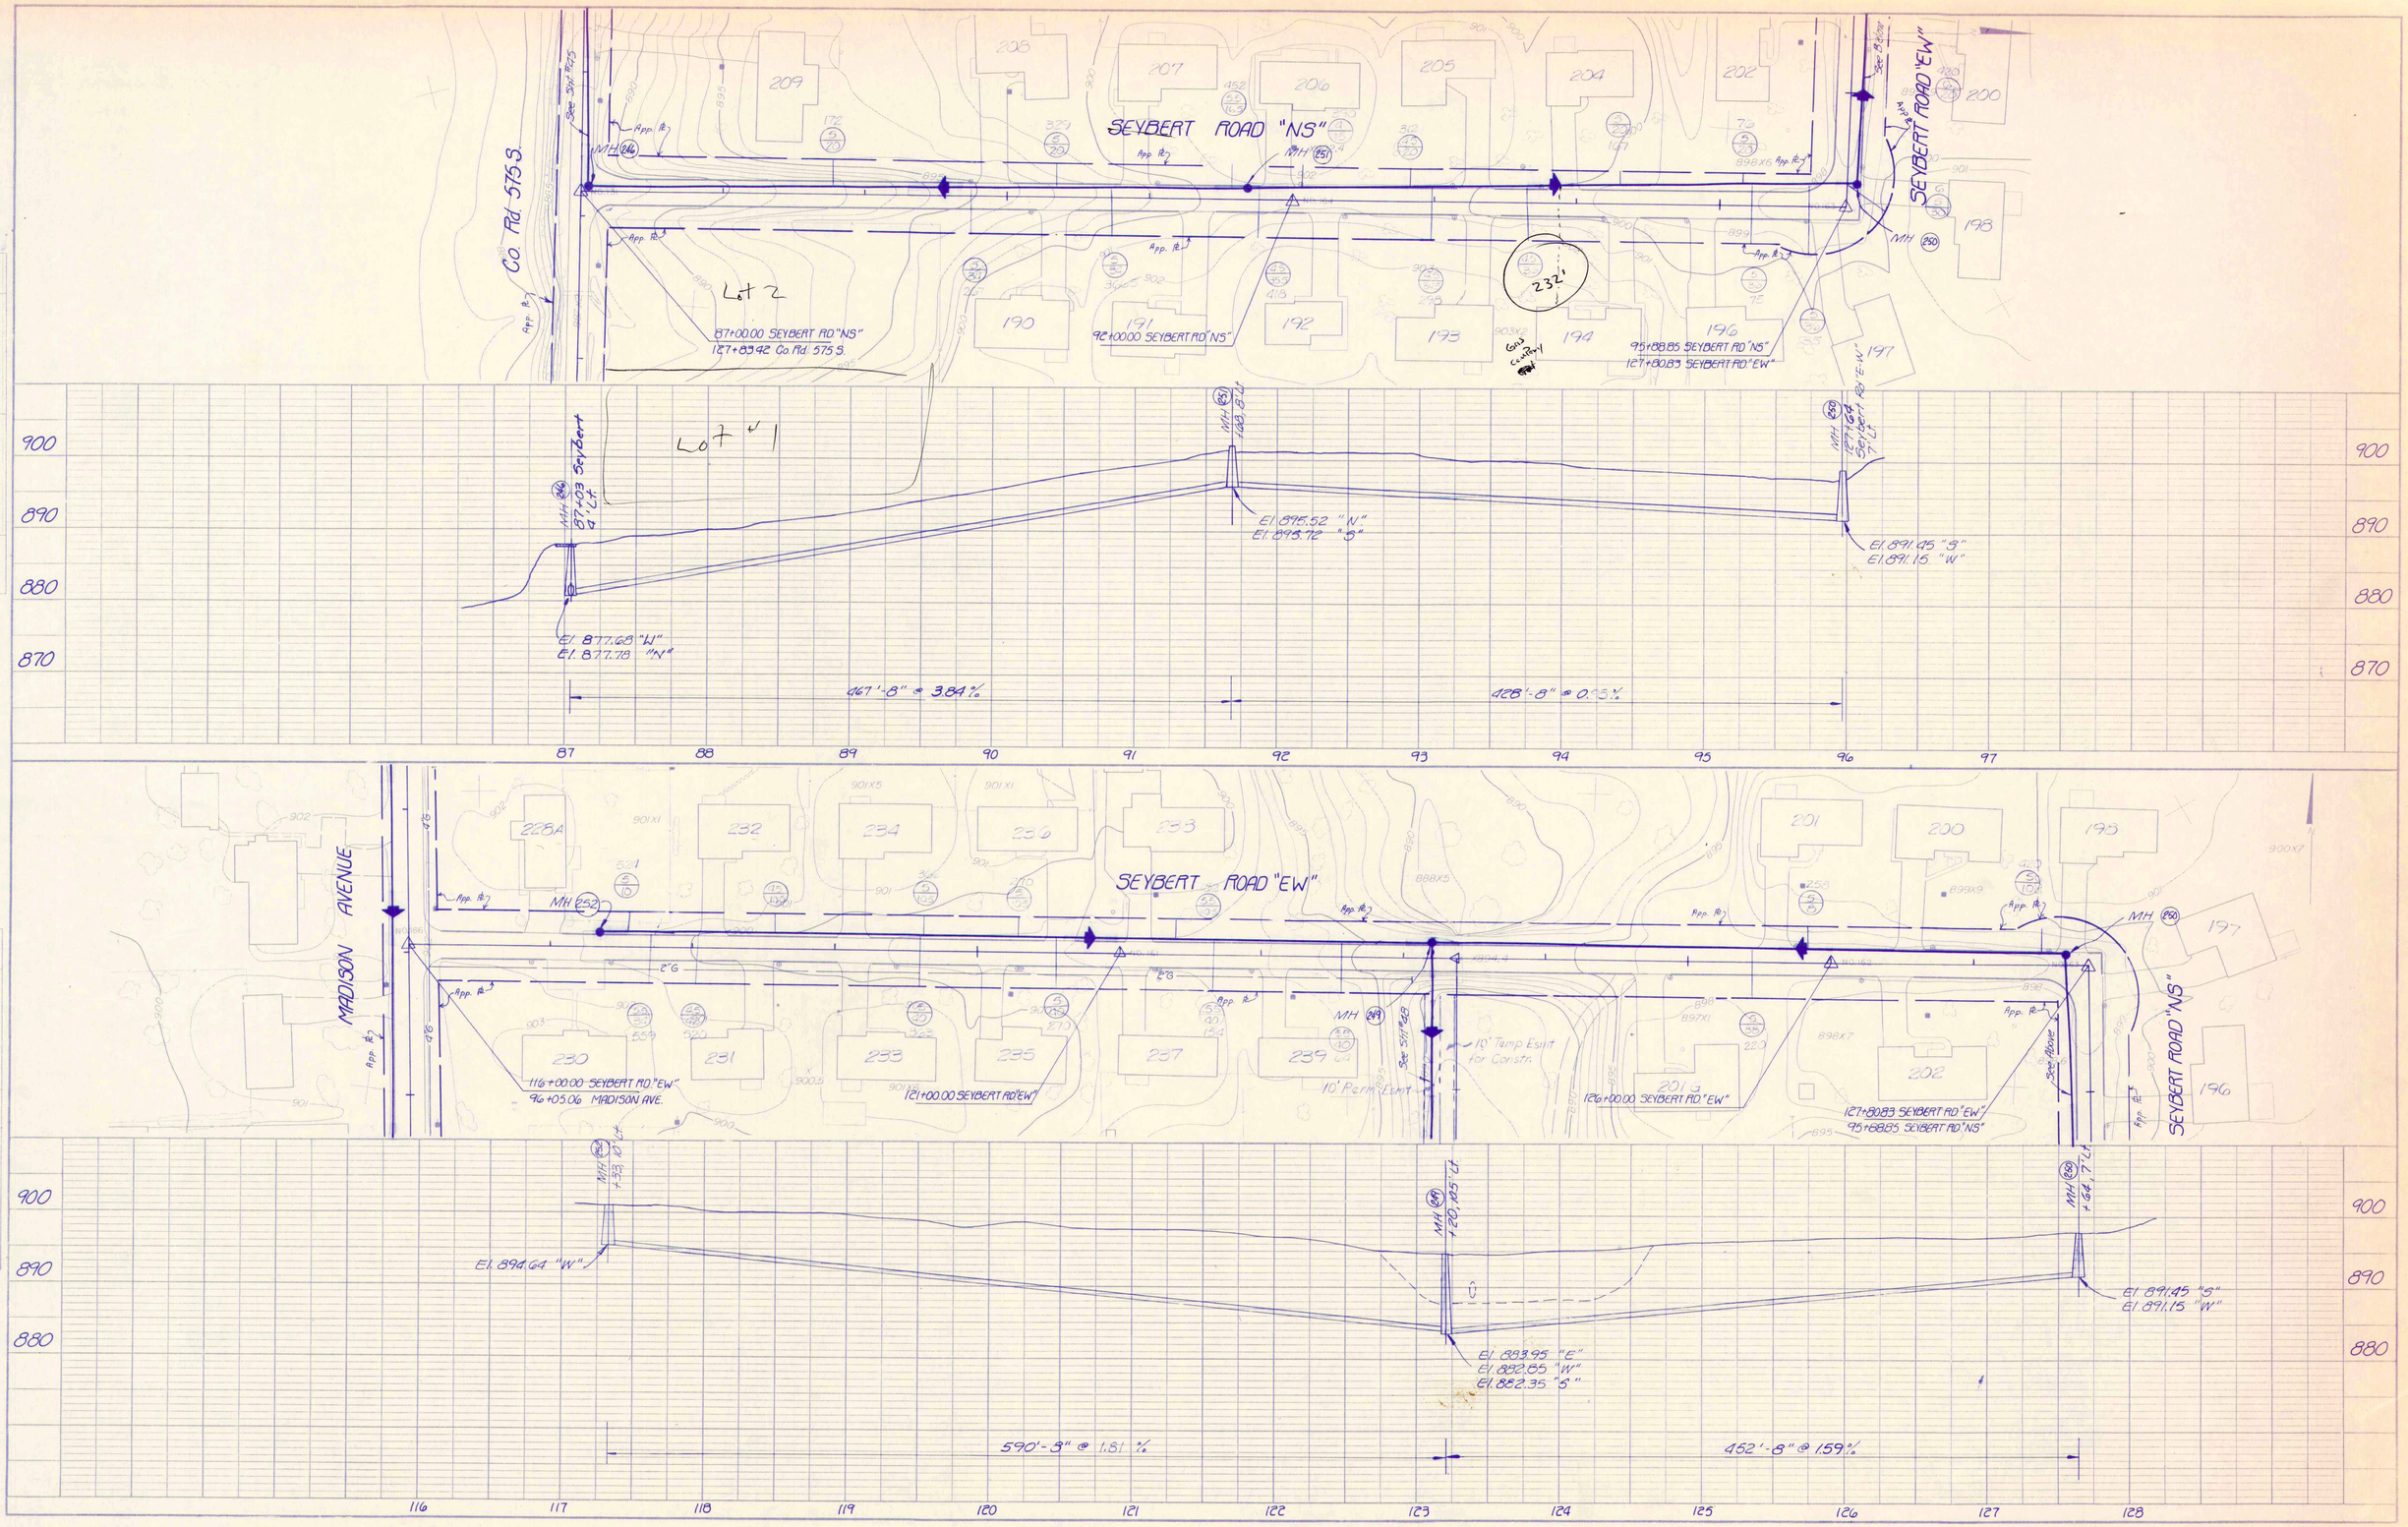

PLAN
SURVEYED
PLOTTED
NOTE BOOK
NO.
ALIGNMENT CHECKED
RT. OF WAY CHECKED

PROFILE
SURVEYED
PLOTTED
GRADES CHECKED
NOTE BOOK
NO.
STRUCTURE NOTAT. CHECKED

RECORD DRAWING

ERIC RESKE
REGISTERED
7-16-84
STATE OF INDIANA
PROFESSIONAL ENGINEER

SEYBERT ROAD "N.S." & "E.W."		
FALL CREEK R.W.D. PLAN & PROFILE		SHEET
HORIZ. 1" = 50'	BEAM, LONGEST & NEFF, INC.	49
VERT. 1" = 10'	CONSULTING ENGINEERS	
	INDIANAPOLIS, INDIANA	